


GRAPHIC SCALE

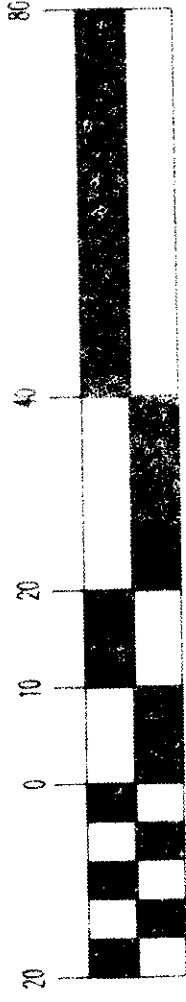

( IN FEET )

1 inch = 20 ft

### GENERAL NOTES:

1. DRIVEWAY APRON TO BE 6" THICK
2. BENCHMARK - TOP STEM OF FIRE HYDRANT LOCATED IN FRONT OF SUBLOT No. 123, ELEV. = 695.18

### LEGEND

- EXISTING CONTOUR
- PROPOSED CONTOUR
- EXISTING ELEVATION
- PROPOSED ELEVATION

### CERTIFICATION

"I, THE UNDERSIGNED HEREBY CERTIFY THAT THIS TOPOGRAPHY INDICATED BY 1" CONTOURS AND ELEVATIONS SHOWN HEREON REPRESENTS AN ACTUAL SURVEY MADE BY ME ON THE 28th DAY OF DEC. 1994 AND THE ELEVATIONS WERE TAKEN AT APPROPRIATE INTERVALS AND AS OF THAT DAY THEY EXISTED AS INDICATED HEREON.

"I HEREBY CERTIFY THAT THIS PLAN WAS PREPARED BY ME AND IS CORRECT TO THE BEST OF MY KNOWLEDGE"

*David W. Novak*  
DAVID W. NOVAK, P.E. No. 7507

### PREPARED BY:

**Himebaugh and Novak**

Surveyors and Site Consultants

8663 Tyler Boulevard

Mentor, Ohio 44060-4346

(216) 974-7670, (216) 255-5900 FAX.

**SITE PLAN:** SUBLOT No. 123, WHITE ASH DRIVE 60' PAINESVILLE, TWP.

PREPARED FOR: CEDAR GLEN SUBDIVISION No. 5, VOL. 21, PG. 29, L.C.R.P.

SCALE: 1" = 20'


DATE: MARCH 23, 1995

DRAWN BY: DAVID W. NOVAK

REV. A, REVISED HOUSE LOCATION PER R.C., 03/24/95

94-012-123

MAR 24 1995

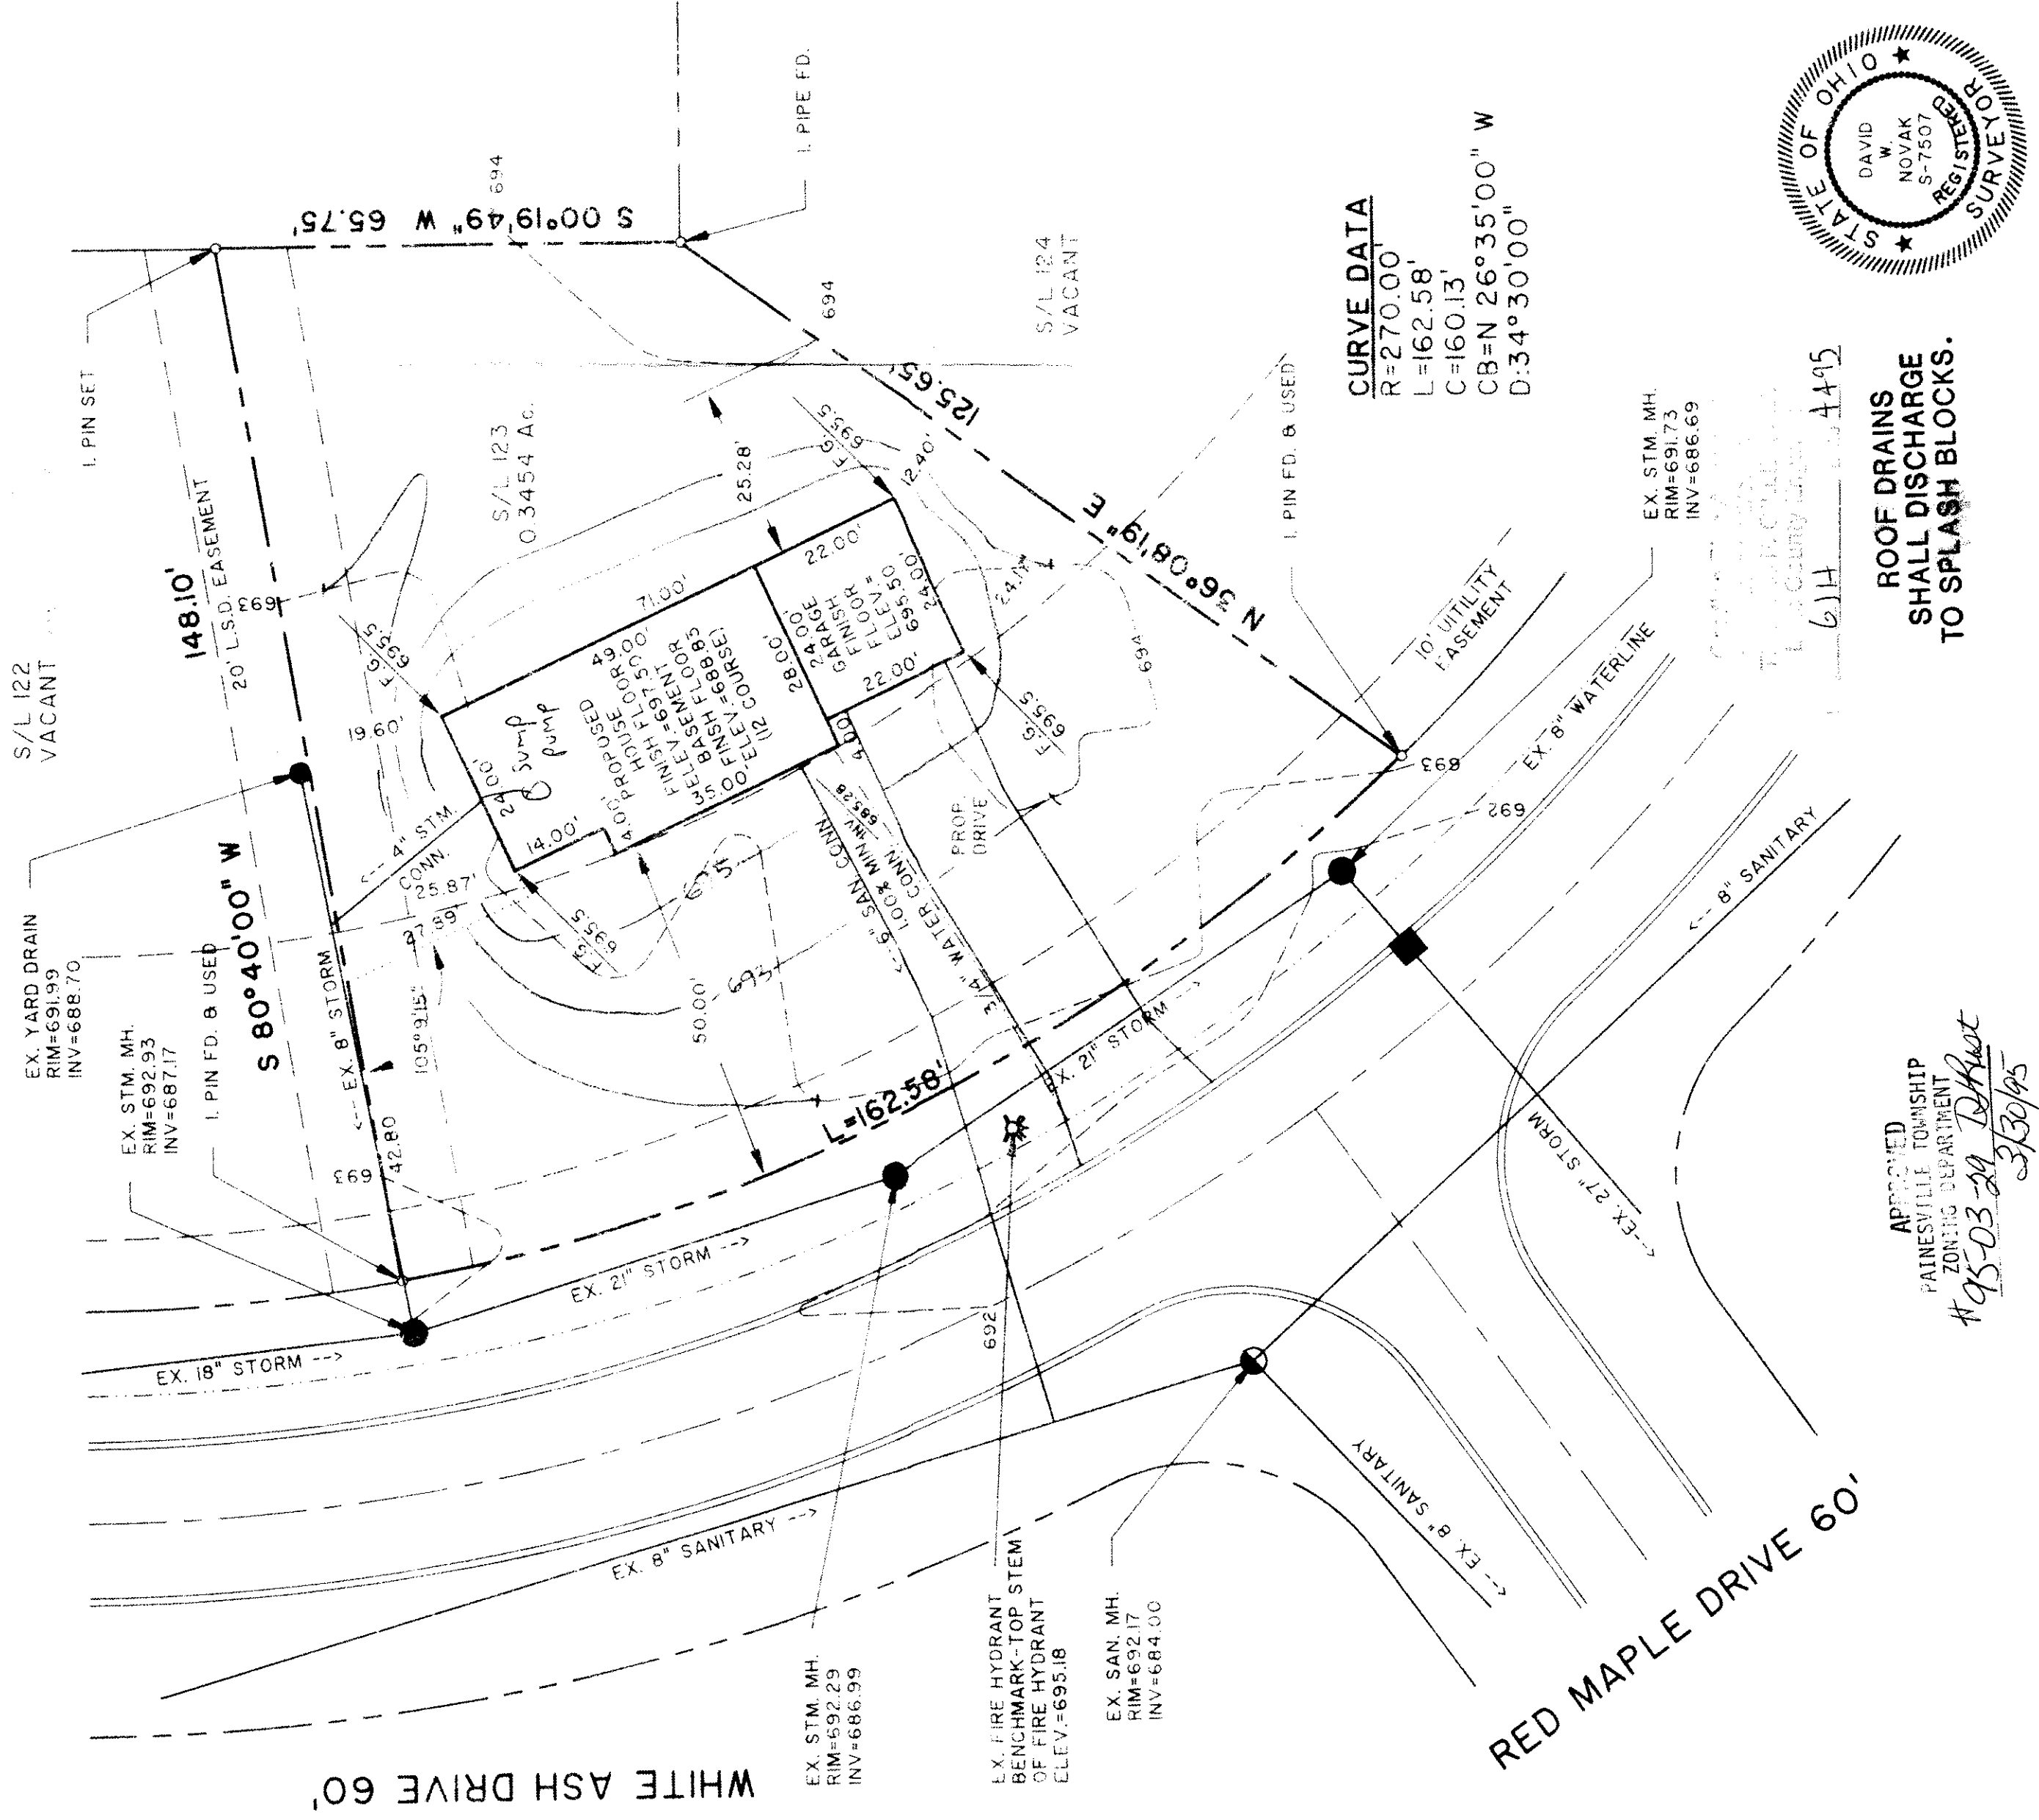

ROOF DRAINS  
SHALL DISCHARGE  
TO SPLASH BLOCKS.

APPROVED  
PAINESVILLE TOWNSHIP  
ZONING DEPARTMENT

#95-03-24  
3/30/95