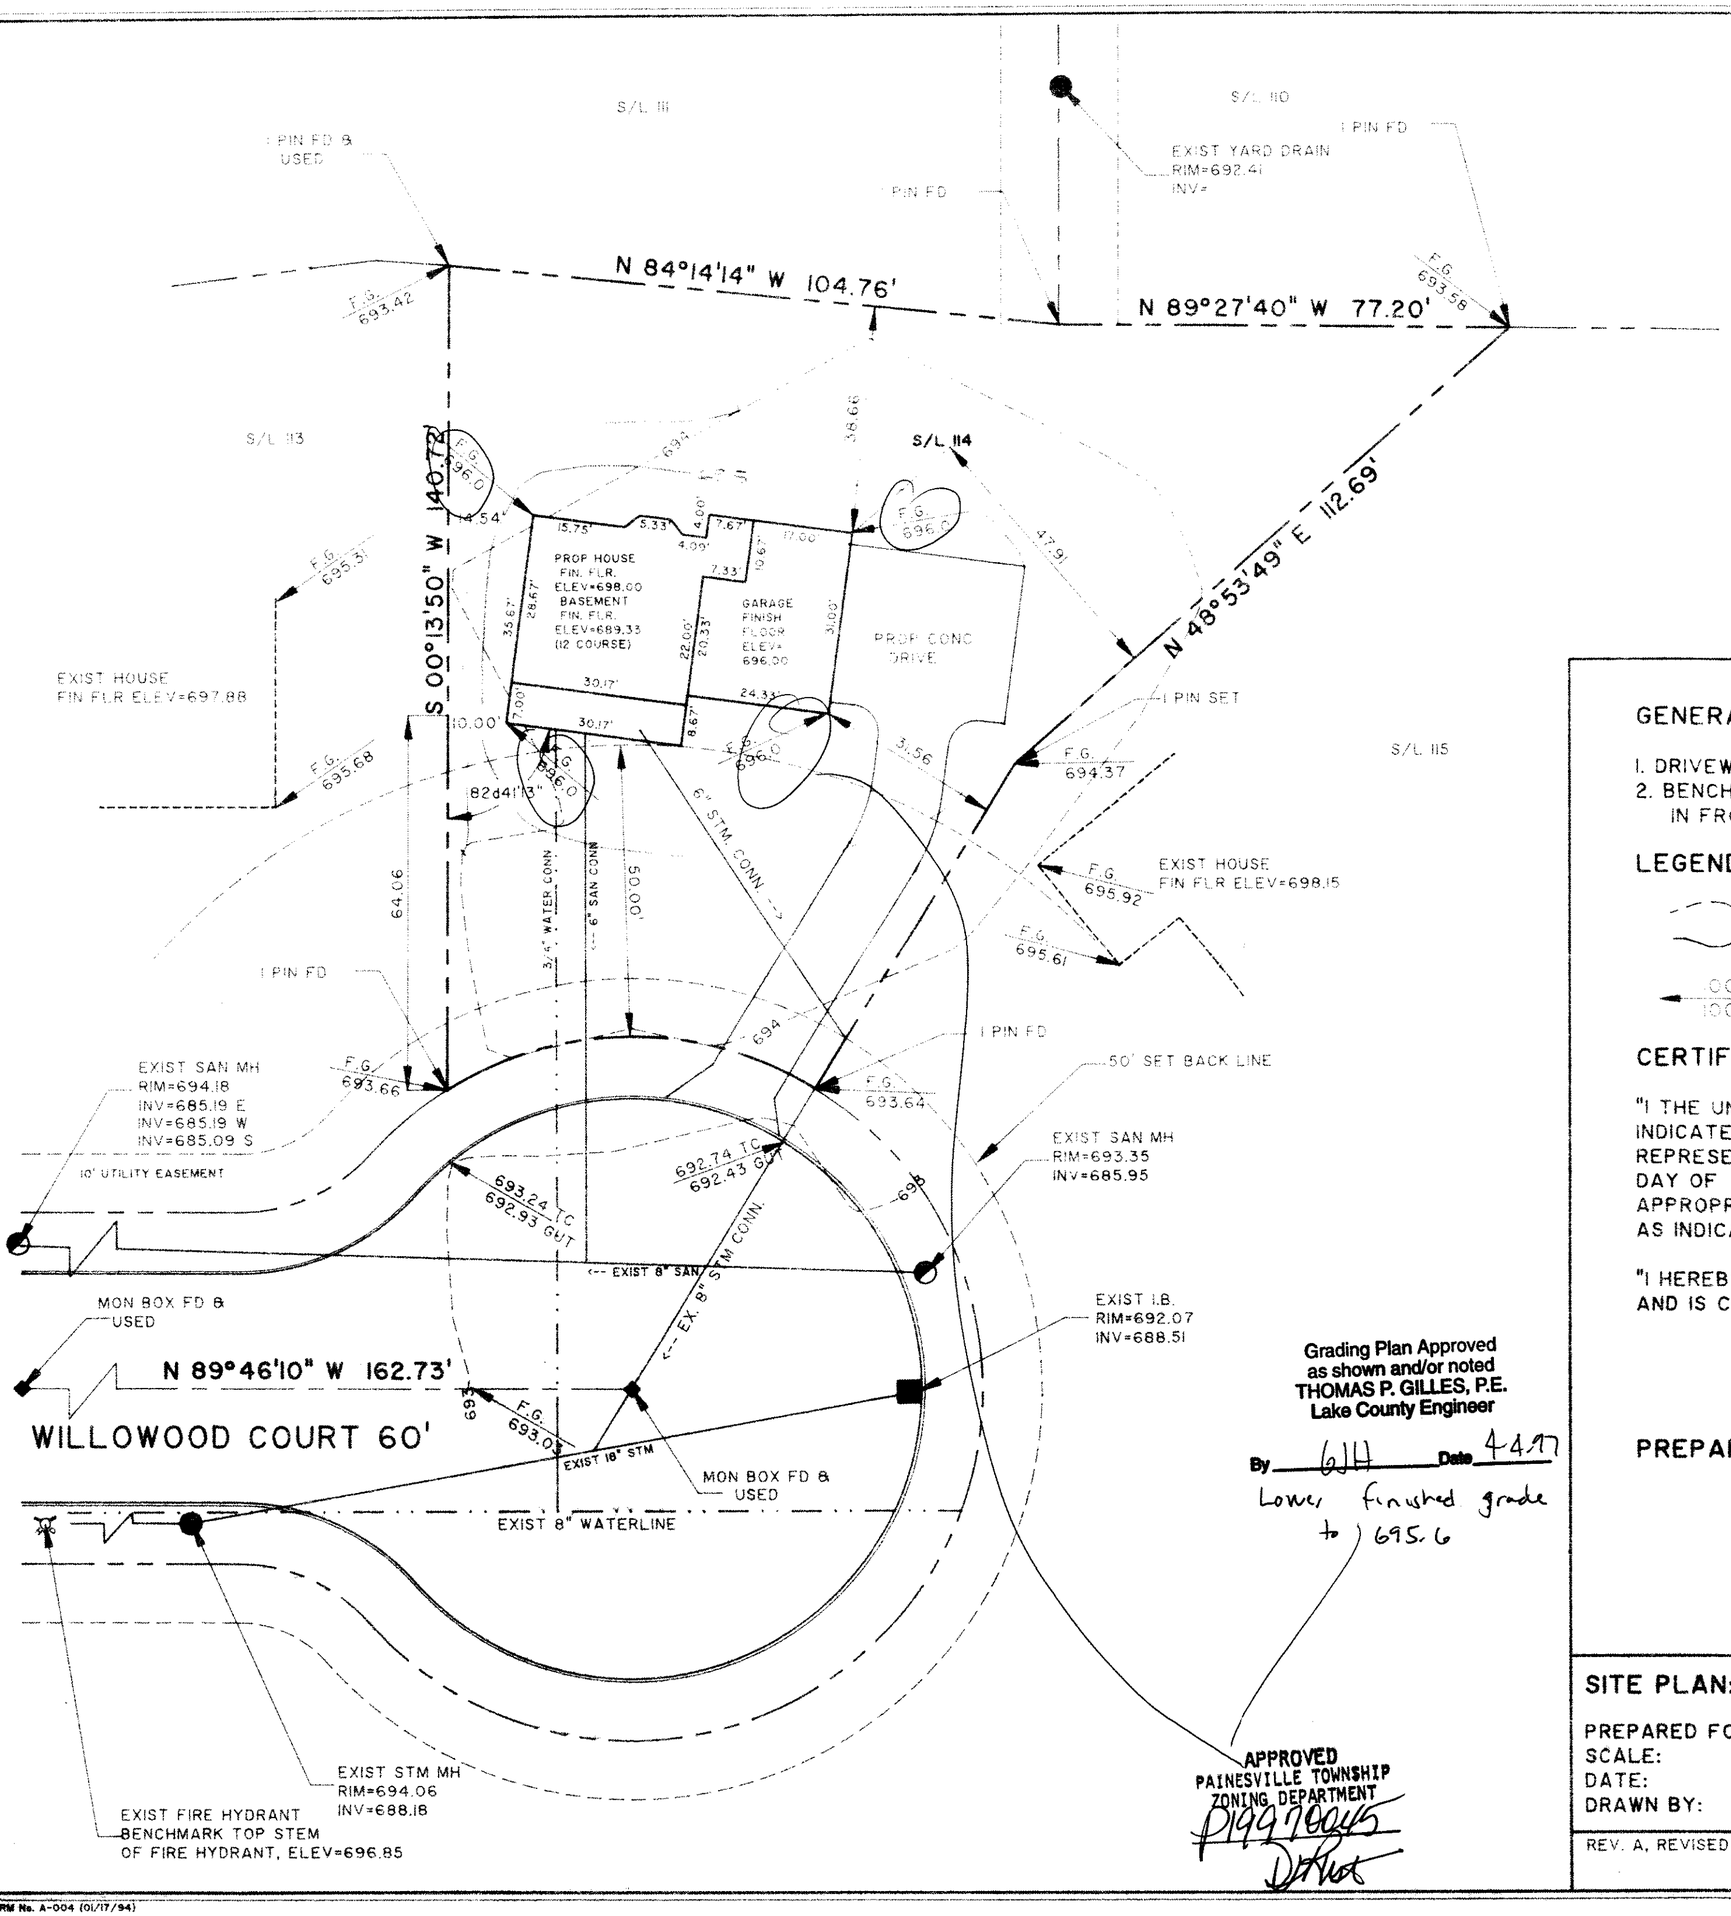

GRAPHIC SCALE

20 0 10 20 40 80

(IN FEET)
1 inch = 20 ft.

Grading Plan Approved
as shown and/or noted
THOMAS P. GILLES, P.E.
Lake County Engineer

By GH Date 4-4-97

Lower finished grade to 695.6

APPROVED
PAINESVILLE TOWNSHIP
ZONING DEPARTMENT
P19970045
DAVid

GENERAL NOTES:

1. DRIVEWAY APRON TO BE 6" THICK
2. BENCHMARK - TOP STEM OF FIRE HYDRANT LOCATED IN FRONT OF SUBLOT No. 119, ELEV. =696.85

LEGEND

EXISTING CONTOUR
PROPOSED CONTOUR

00.00 EXISTING ELEVATION
100.00 PROPOSED ELEVATION

STATE OF OHIO
DAVID W. NOVAK
S-7507
REGISTERED
SURVEYOR

CERTIFICATION

"I THE UNDERSIGNED HEREBY CERTIFY THAT THIS TOPOGRAPHY INDICATED BY 1' CONTOURS AND ELEVATIONS SHOWN HEREON REPRESENTS AN ACTUAL SURVEY MADE BY ME ON THE 31ST DAY OF MARCH , 1997 AND THE ELEVATIONS WERE TAKEN AT APPROPRIATE INTERVALS AND AS OF THAT DAY THEY EXISTED AS INDICATED HEREON.

"I HEREBY CERTIFY THAT THIS PLAN WAS PREPARED BY ME AND IS CORRECT TO THE BEST OF MY KNOWLEDGE"

DAVID W. NOVAK, P.S. No. 7507

PREPARED BY:

Himebaugh and Novak

Surveyors and Site Consultants
8663 Tyler Boulevard
Mentor, Ohio 44060-4346
(216) 974-7670, (216) 255-5900 FAX.

SITE PLAN: SUBLOT No. 114 WILLOWOOD COURT 60' PAINESVILLE TWP.
CEDAR GLEN SUBDIVISION, VOL. 21, PG. 29-2

PREPARED FOR: LITTLE MOUNTIAN HOMES, INC.
SCALE: 1" = 20'
DATE: MARCH 31, 1997
DRAWN BY: CHRISTOPHER R KRAFT

REV. A, REVISED HOUSE DIM. (04/04/97) DWN

96046-114