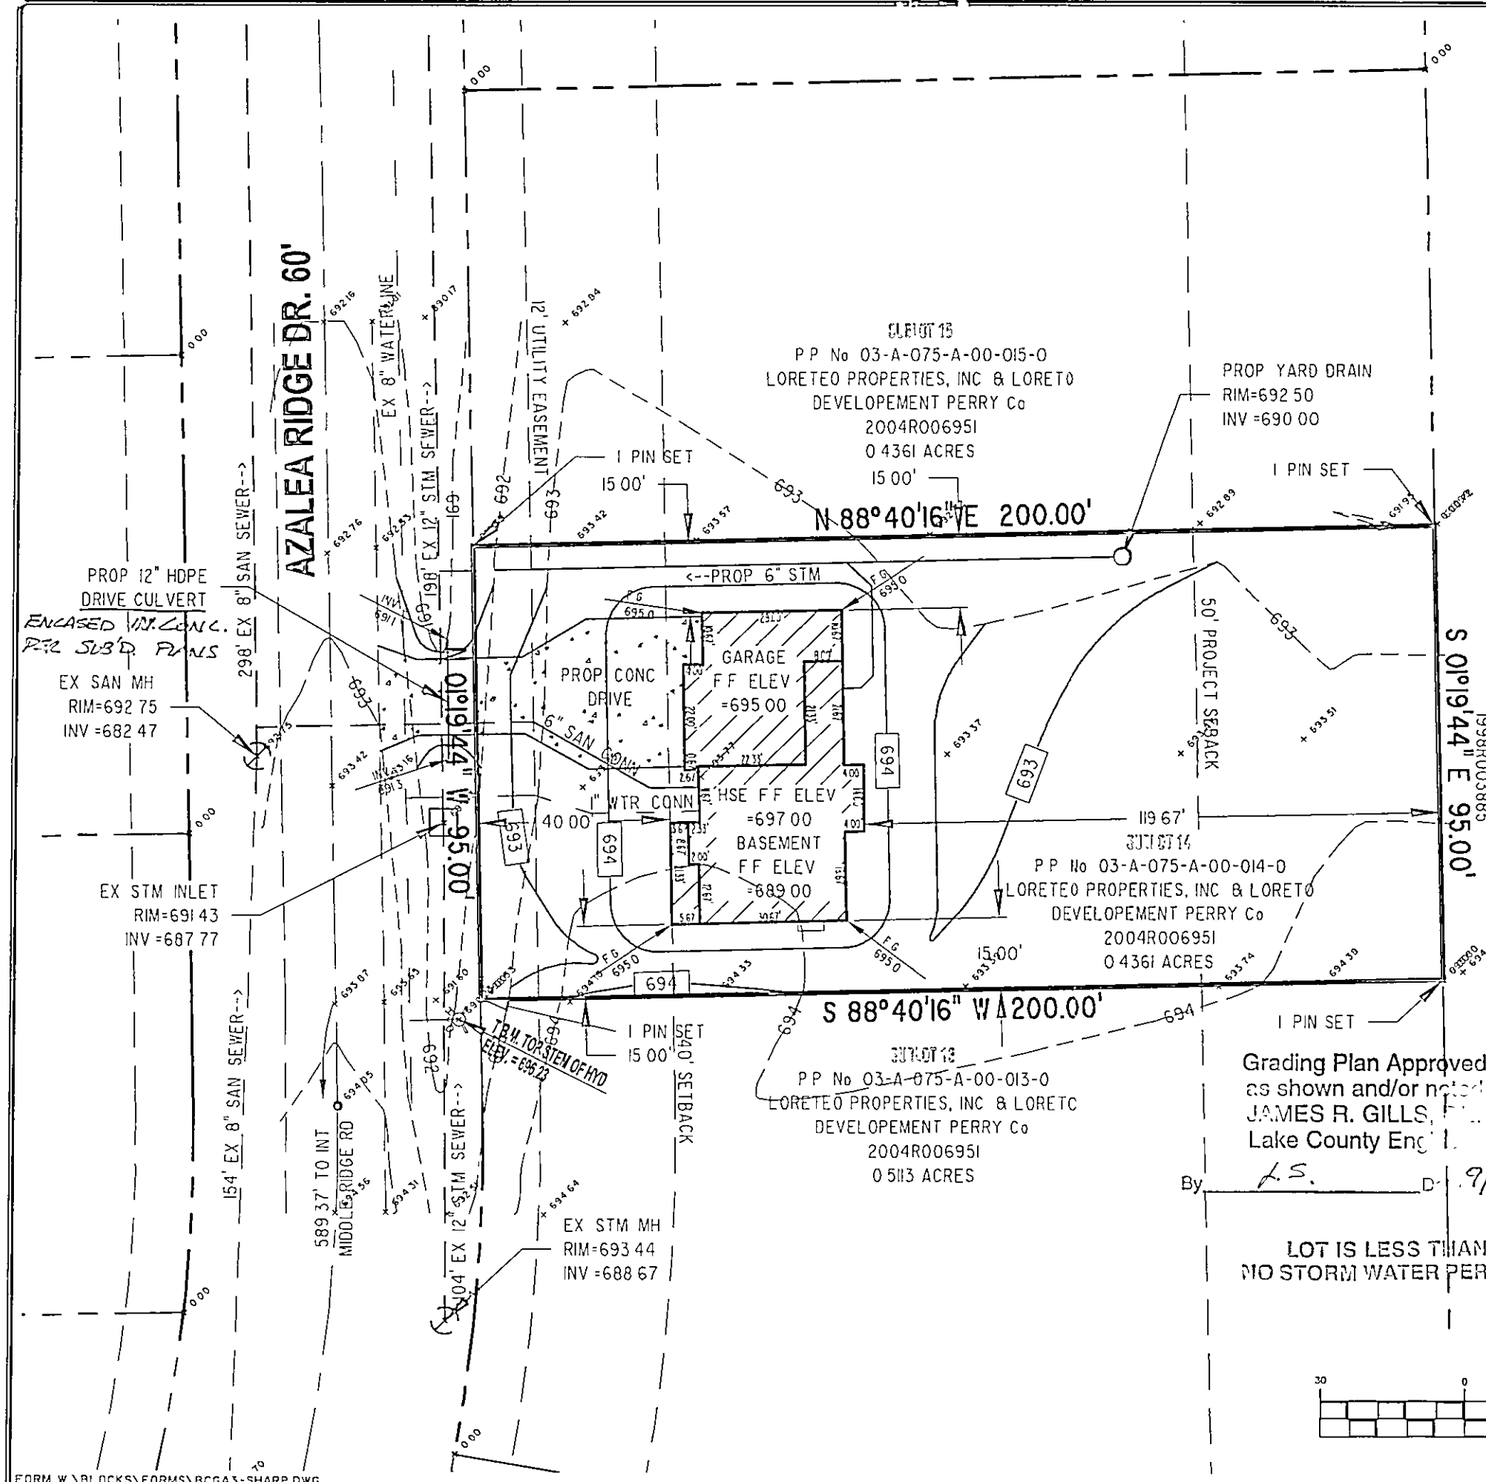

GENERAL NOTES:

1. BENCHMARK - TOP STEM OF FIRE HYDRANT IN FRONT OF SUBLOT 13, ELEVATION = 696 23
2. DRIVEWAY APRON TO BE 6" THICK CONCRETE
3. ALL DOWNSPOUTS TO BE OUTLETTED TO SPLASH BLOCKS.
4. CONTRACTOR RESPONSIBLE FOR CONTACTING THE OHIO UTILITY PROTECTION SERVICE (1.800.362.2764) AND ALL UTILITY COMPANIES A MINIMUM OF 48 HOURS PRIOR TO CONSTRUCTION.
5. THE LOCATION BOTH HORIZONTAL AND VERTICAL OF EXISTING UNDERGROUND UTILITIES SHOWN HEREON, HAVE BEEN OBTAINED BY A DILIGENT AND COMPREHENSIVE SEARCH OF AVAILABLE RECORDS. VERIFICATION BY FIELD OBSERVATION HAS BEEN CONDUCTED WHERE PRACTICAL, HOWEVER, BARRINGTON CONSULTING GROUP, INC. DOES NOT GUARANTEE THE COMPLETENESS, NOR ACCURACY THEREOF.
6. CONTRACTOR SHALL VERIFY ELEVATIONS OF LATERAL INVERTS IN THE FIELD PRIOR TO FOUNDATION EXCAVATION.
7. SEE SHEET 2 FOR EROSION AND SEDIMENT-CONTROL PLAN
8 SEE SHEET 2 FOR SEEDING INFORMATION

CERTIFICATION :

"I THE UNDERSIGNED HEREBY CERTIFIES THAT THIS TOPOGRAPHY INDICATED BY 1 FOOT CONTOURS AND ELEVATION SHOWN HEREON REPRESENTS AN ACTUAL SURVEY MADE BY ME ON THE 31st DAY OF AUGUST, 2006 AND THE ELEVATIONS WERE TAKEN AT AN APPROPRIATE INTERVAL AND AS OF THAT DAY THEY EXISTED AS INDICATED HEREON.

"I HEREBY CERTIFY THAT THIS PLAN WAS PREPARED BY ME AND IS CORRECT TO THE BEST OF MY KNOWLEDGE AND BELIEF"

DAVID W NOVAK, P S No. 7507

CERT 1 DWG

Grading Plan Approved as shown and/or noted
JAMES R. GILLS, P.E.
Lake County Eng'l.
By L.S. Date 9/12/06

APPROVED
SIDE LINES & SET BACK
PERRY TOWNSHIP ZONING
PERMIT NO. 7770
ZONING INSPECTOR

LOT IS LESS THAN 1 ACRE.
NO STORM WATER PERMIT NEEDED.

Barrington CONSULTING GROUP, INC.

GRAPHIC SCALE

30 0 15 30 60 120

(IN FEET)
1 inch = 30 ft.

FORM W \BLOCKS\FORMS\BCGA3-SHARP DWG

06108-14

REVISIONS	BY

Barrington
CONSULTING GROUP, INC.
9114 TYLER BLVD., MENTOR, OHIO 44060
PHONE 440.205.1260 FAX 440.205.1262
BCG@BarringtonCGI.com

STATE OF OHIO
DAVID W NOVAK S-7507
REGISTERED SURVEYOR

SITE PLAN

S/L 14 AZALEA RIDGE DR., PERRY, OHIO
AZALEA RIDGE SUBDIVISION VOL. 52 PG. 25

LITTLE MOUNTAIN HOMES

DRAWN WSO
CHECKED DWN
DATE SEPT. 01, 2006
SCALE 1" = 30'
JOB NO 06108-14
SHEET 1/2 OF SHEETS