Grading Plan Approved
as shown and/or noted
THOMAS P. GILLES, P.E.
Lake County Engineer
By [illegible] Date 3-11-77

APPROVED
SIDE LINES & SET BACK
PERRY TOWNSHIP ZONING
PERMIT NO. 1856
ZONING INSPECTOR [illegible]

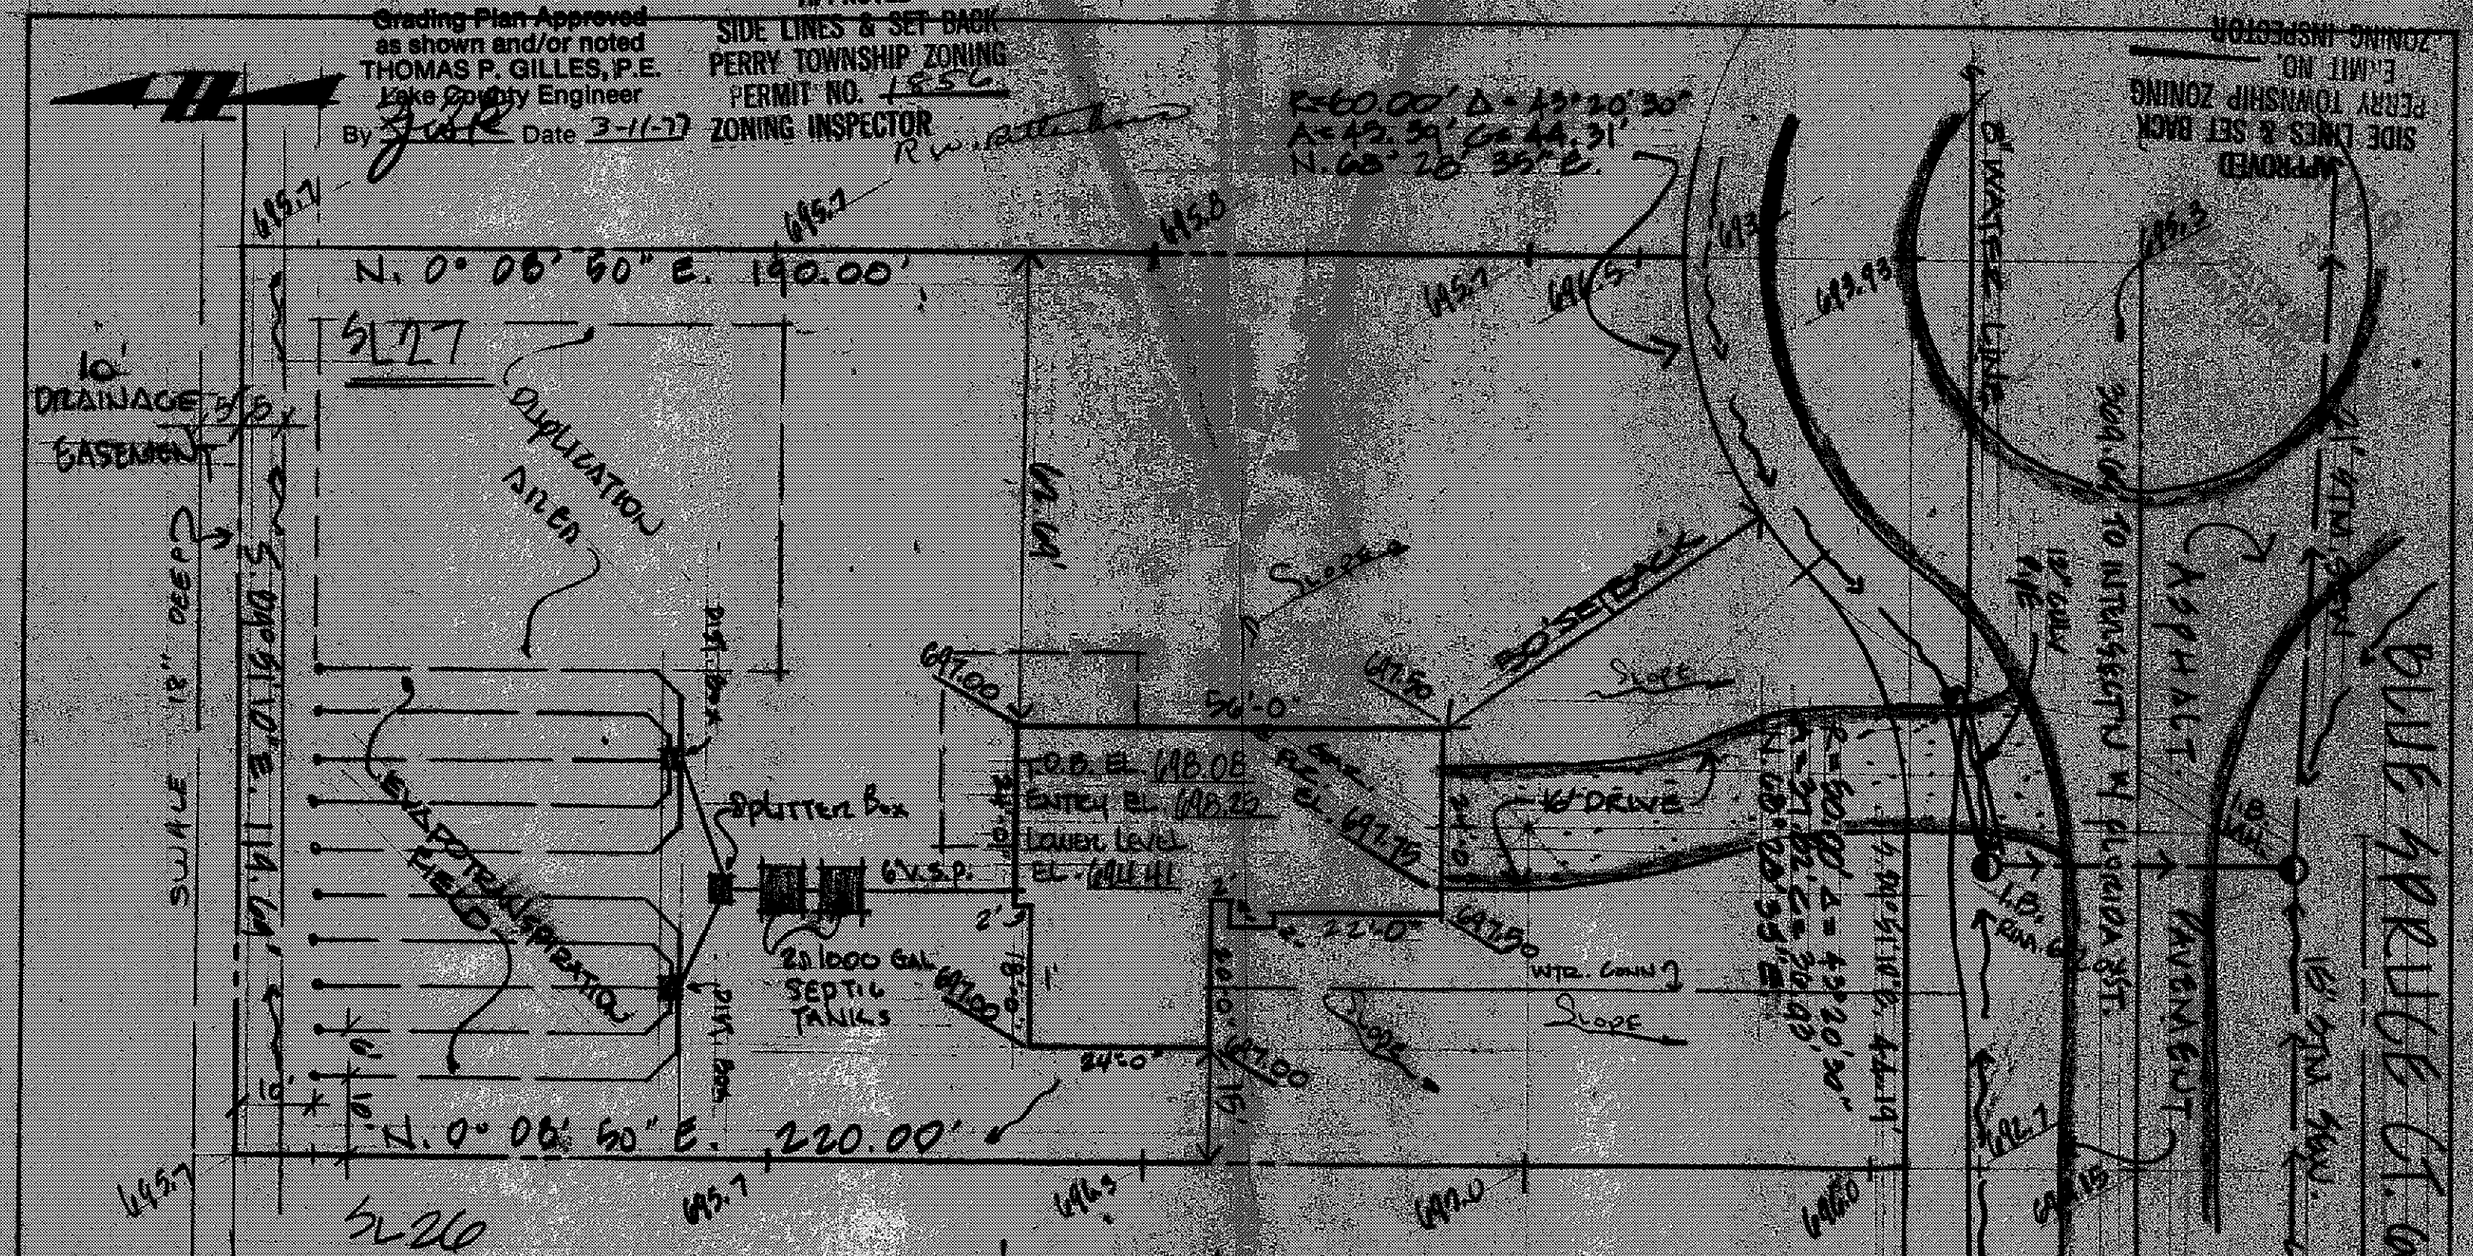

T.B.M. TOP OF FIRE HYD AT END OF BLUE SPRUCE CT. EL. 695.41

NOTE: UNDERLINED ELEV. INDICATES PROPOSED GRADES

DESIGN CERTIFICATION

THIS PLAT WAS PREPARED BY ME, AND IS CORRECT TO THE BEST OF MY KNOWLEDGE AND BELIEF.

[signature]

REG. SURVEYOR NO. 4785

AS BUILT CERTIFICATION

I HEREBY CERTIFY THAT THE CIRCLED GRADES ARE EXISTING FINISH GRADES CHECKED IN THE FIELD ON _____ AND THAT SURVEY IS CORRECT TO THE BEST OF MY KNOWLEDGE AND BELIEF.

REG. SURVEYOR NO. _____

COLPETZER · WOODS
CONSULTANTS, INC.
180 SOUTH STATE STREET • PAINESVILLE, OHIO 44077 • (216) 357-7560

DATE 2/4/77
SCALE 1" = 20'
DRWN BY [illegible]
CHKD BY [illegible]
JOB NO 77-013
PB 301 PG 14

SITE PLAN FOR:
CASEMENT HOMES
1251 MADISON AVE., P'VILLE, OH.
BEING SUBLOT NO. 27 IN BIRCHFIELD MEADOWS SUBDIVISION NO. 1 IN PERRY TWP., OHIO.

3001 Blue Spruce Court