
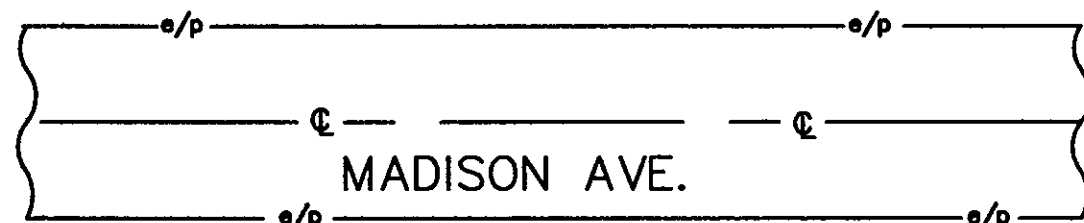


SITE PLAN
FOR
DAVE FISHER
BENNETT ROAD
MADISON TOWNSHIP, LAKE COUNTY, OHIO


SCALE 1" = 20 ft.
29 JUNE 1999

- P — DENOTES PROPERTY LINE
— C — DENOTES CENTERLINE OF ROAD
● DENOTES 1/2" Ø IRON PIN SET (CAPPED "PETER 6420")
○ DENOTES IRON PIN FOUND
⊗ DENOTES EXISTING TREE
--- 99 --- DENOTES EXISTING CONTOUR ELEVATION
--- 98 --- DENOTES PROPOSED CONTOUR ELEVATION
▲ DENOTES WOODEN STAKE SET ON LINE

Jim Peter Land Survey
4759 Crosby-Cook Road
Rome, Ohio 44085
(216) 294-2187

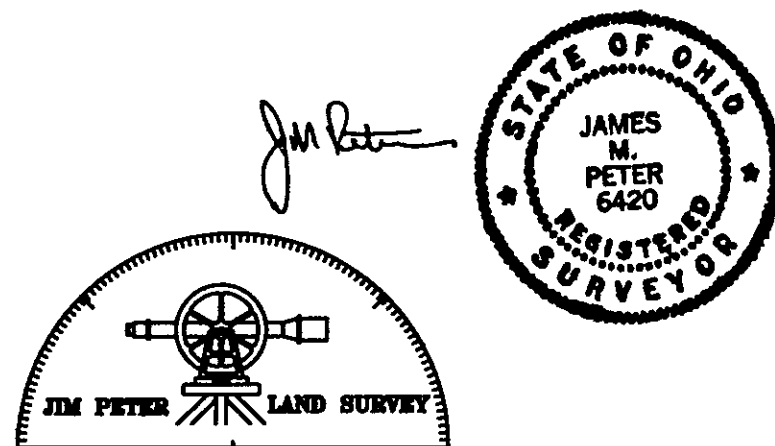


BENCH MARK
TOP OF HYDRANT
ELEVATION 100.00 FL.

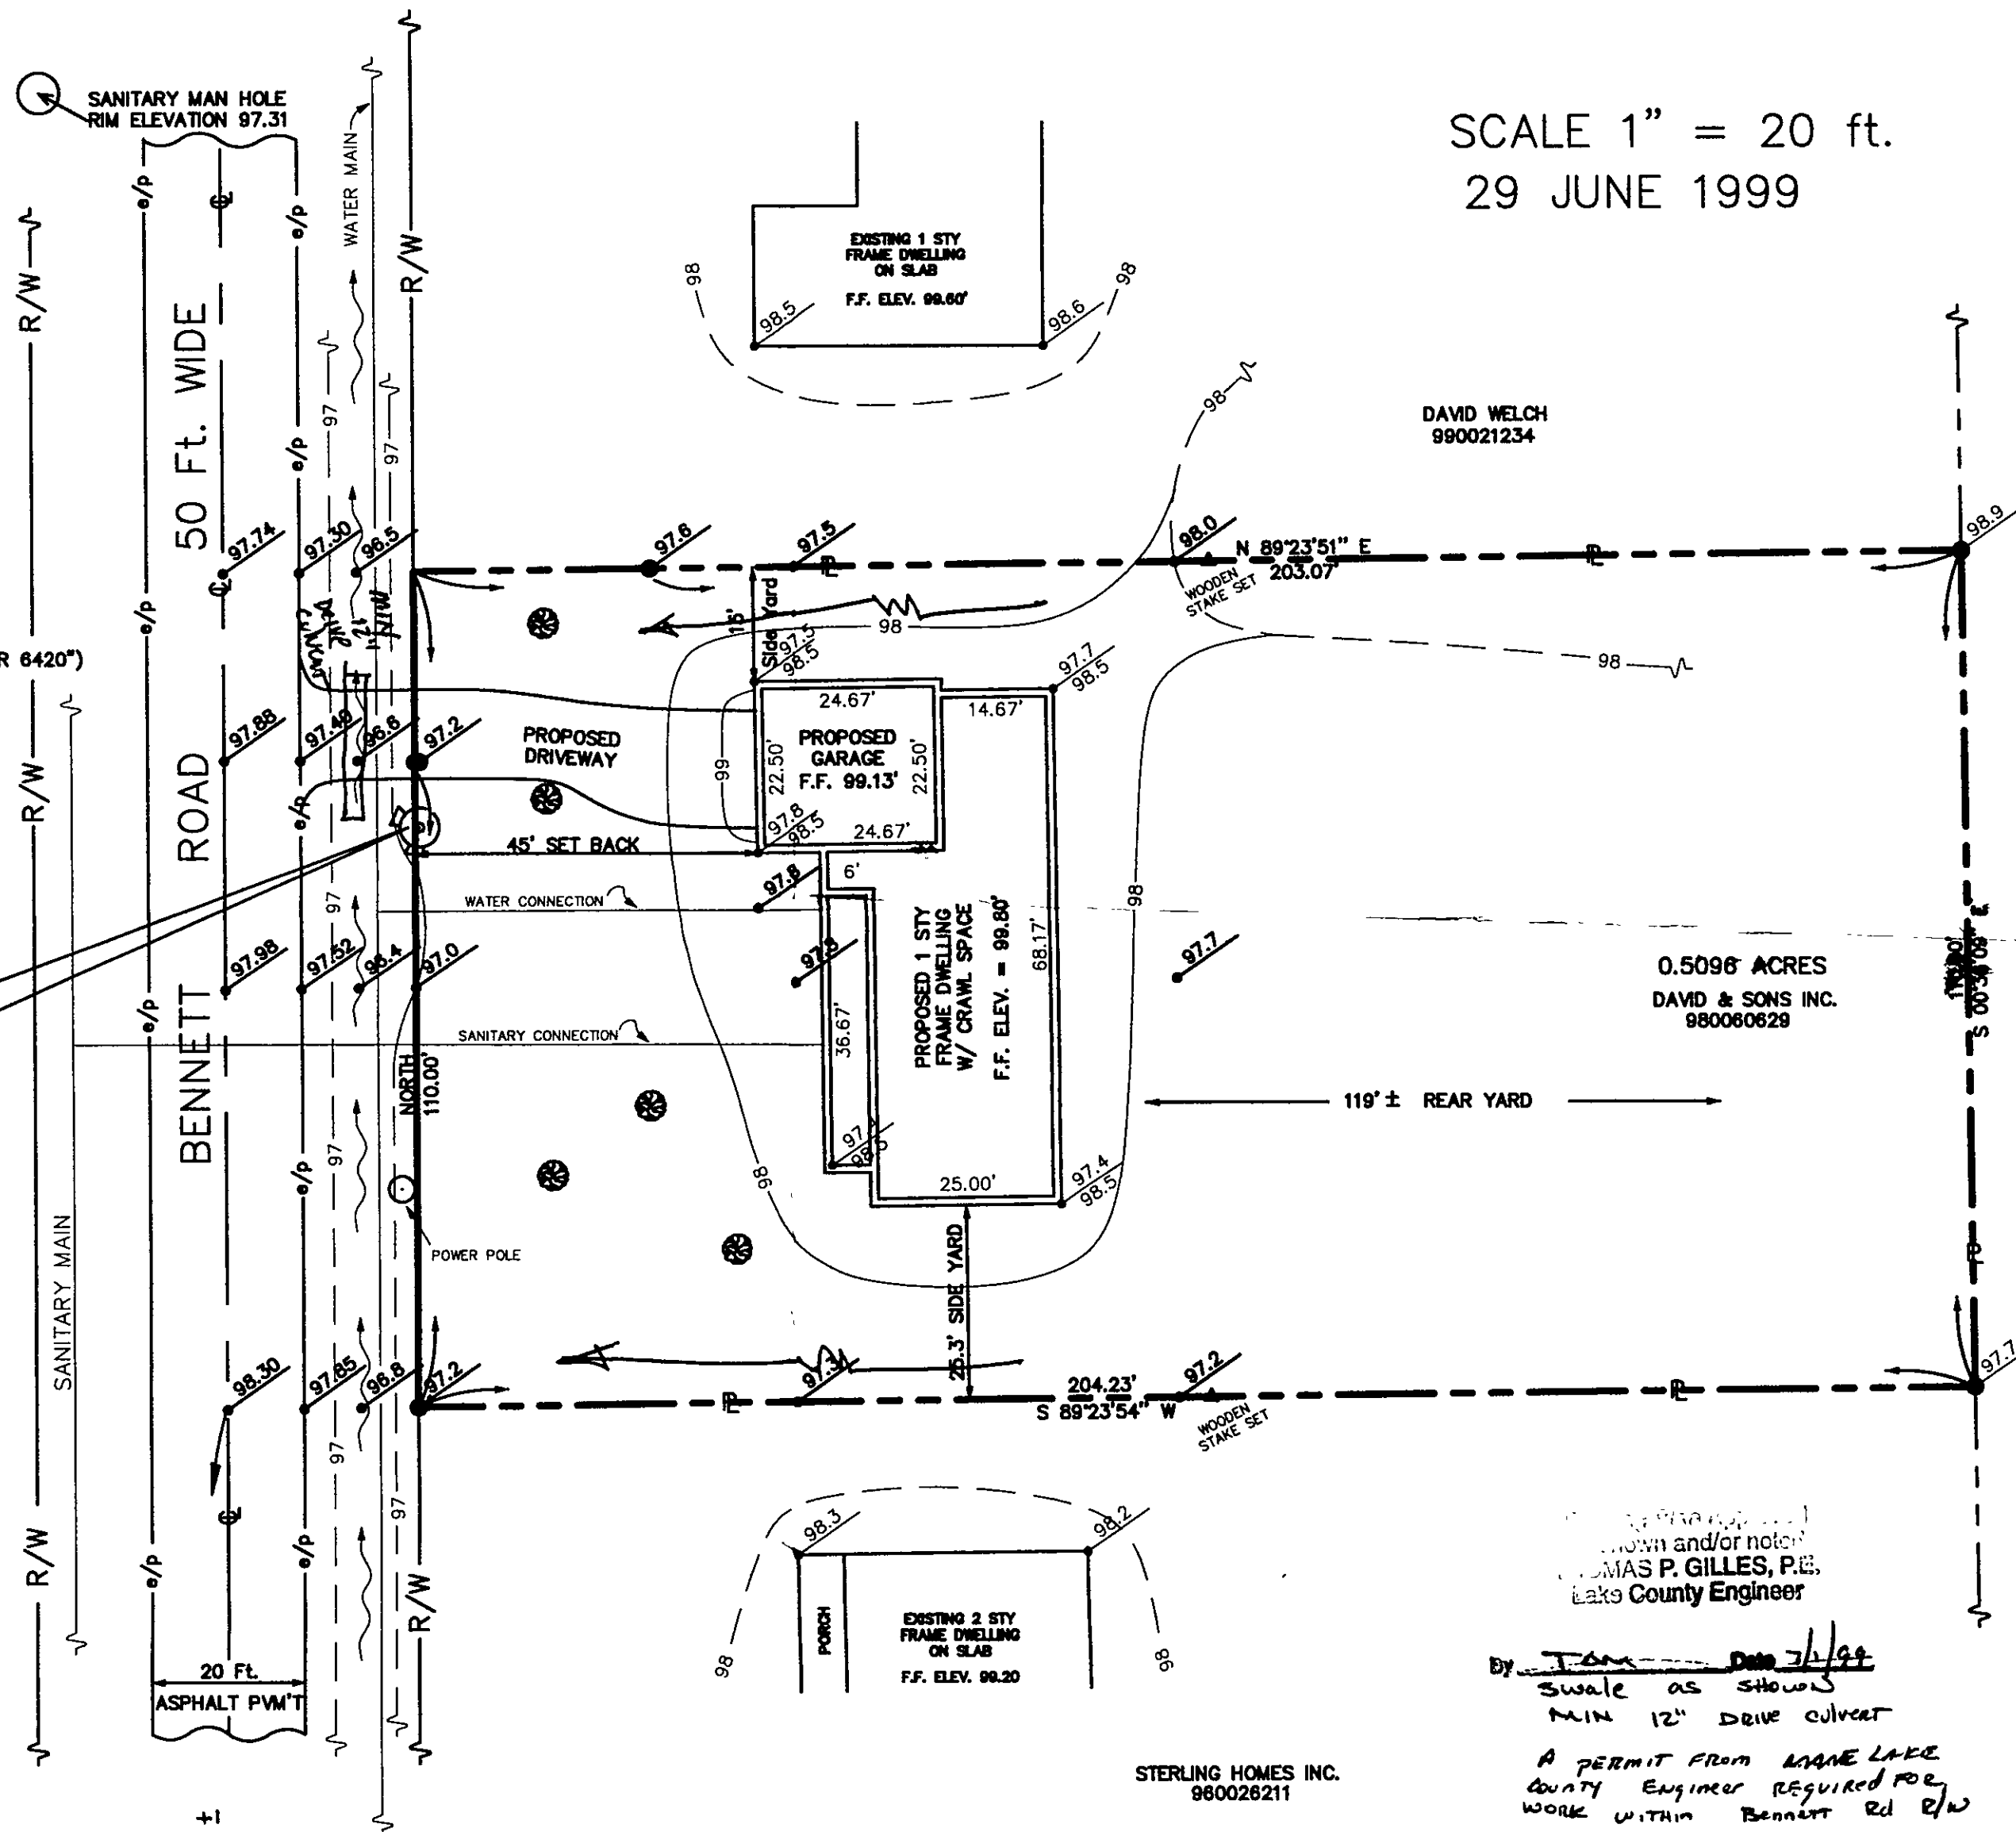

By Tom Date 7/1/99
Swale as shown
Main 12" Drive Culvert
A PERMIT FROM LAKE COUNTY ENGINEER REQUIRED FOR WORK WITHIN BENNETT RD R/W

STERLING HOMES INC.
980026211

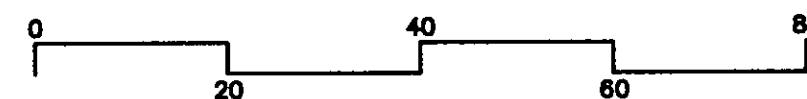

SCALE IN FEET

DWG #960707

APPROVED
MADISON TOWNSHIP ZONING
DATE 6/30/99
BY DM 16284