
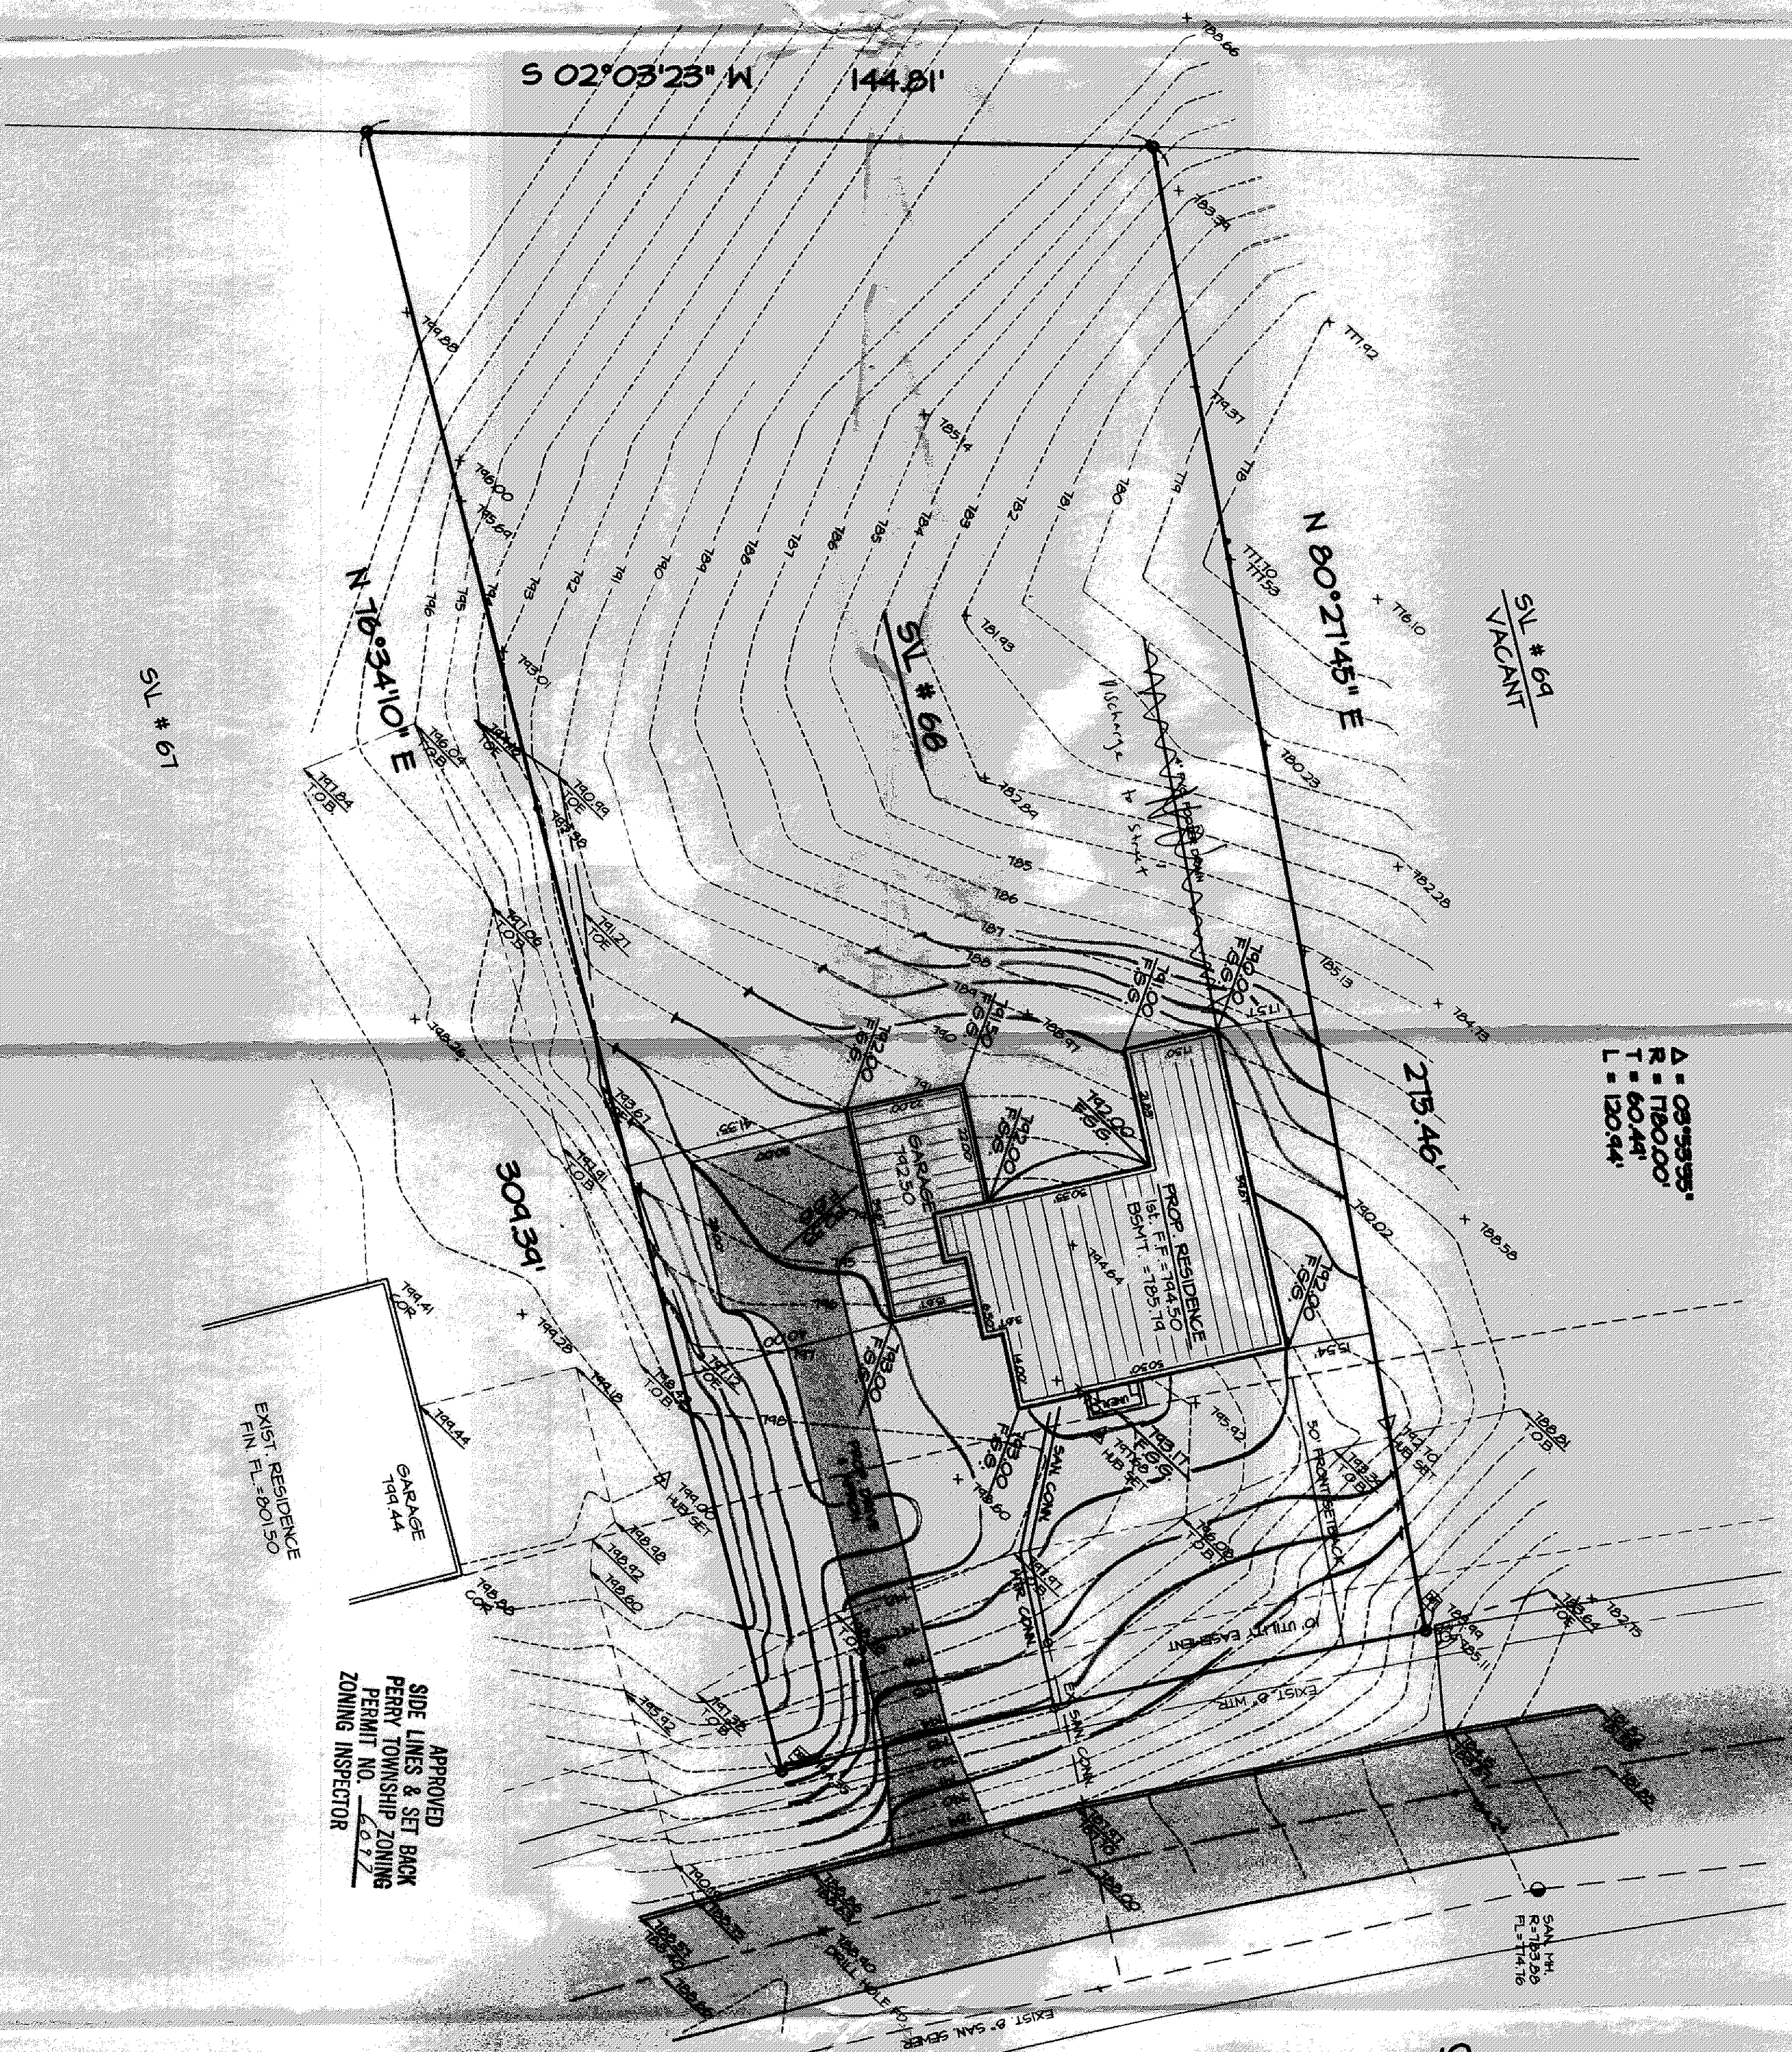
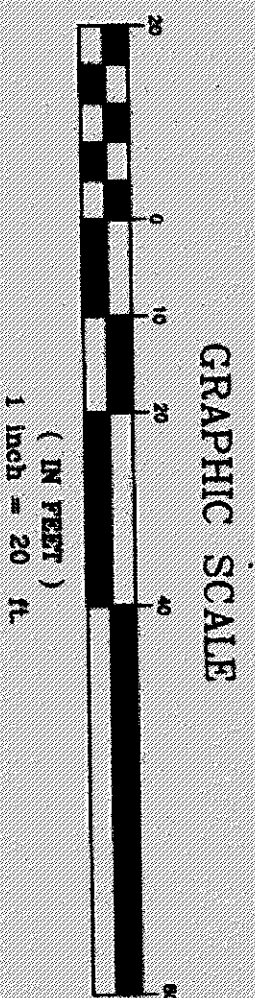


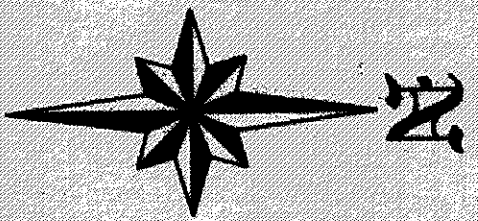

Δ = 08°59'55"
R = 1180.00'
T = 60.44'
L = 120.44'

CANYON RIDGE DRIVE 60'

BENCHMARK :
TOP OF EXISTING SAN. MH.
ELEVATION = 184.27

Created: Plan Approved
as shown and dated
THOMAS P. GILLES, P.E.
Leite County Engineer
By: 6/14 Date: 5/11/95

ROOF DRAINS
SHALL DISCHARGE
TO SPLASH BLOCKS.

PRINTED
APR 7 1995
LAKE INC.



Rev. No.	Description	Date	By	CHK'D

SITE PLAN
S/L # 68
CANYON RIDGE SUBD. PERRY TOWNSHIP

Drawn By: D. Abbott
Filename: 95-3195-31
Checked By:
Approved By:
Date: MARCH 6/1995

SIGNATURE HOMES

Scale:
HORIZ. 1" = 20'
VERT. 1" = 20'
Sheet No. 1 of 1