

SITE PLAN
FOR
ANGELORO CONST.
BEING SUBLOT NO. 5 OF THE CASA
BELLA SUBDIVISION, TOWNSHIP OF PERRY,
LAKE COUNTY, OHIO.

SCALE
1"=20'


① CURVE DATA
R= 242.15
CH= 111.10
A= 112.09
B= N 76° 22' 41" W

- A. To be brought to finished grade
1. Septic tank manhole covers
2. Sifter box cover
3. D. Sifter box cover
- B. The foot of drains or down pipes to be scattered into septic tanks
- C. All waste water to be discharged into septic tanks

LOW YIELD WATER
FIXTURES REQUIRED
ON ALL
Toilet
Shower Head


SEWAGE DISPOSAL PERMIT MUST BE
OBTAINED BY A LAKE COUNTY LICENSED
INSTALLER BEFORE INSTALLATION IS
STARTED.

Reviewed and Accepted
LAKE COUNTY GENERAL HEALTH DISTRICT
Date: 12-18-89
JOEL LUTCH, R. S. M. P. H.
Health Commissioner
By: *Thomas M. Coffman*

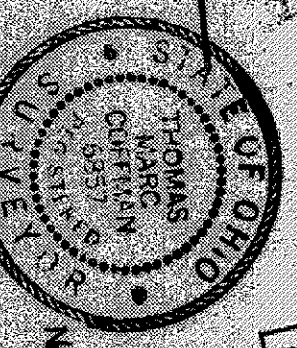

VILLAGE SURVEYING CO.
202 THIRD ST. FAIRPORT HBR, OHIO 44077
(216) 357-1359

This Plan was Prepared By ME And Is Accurate
To The Best Of My Knowledge And Belief.
Thomas M. Coffman
THOMAS M. COFFMAN P.E. No. 12414

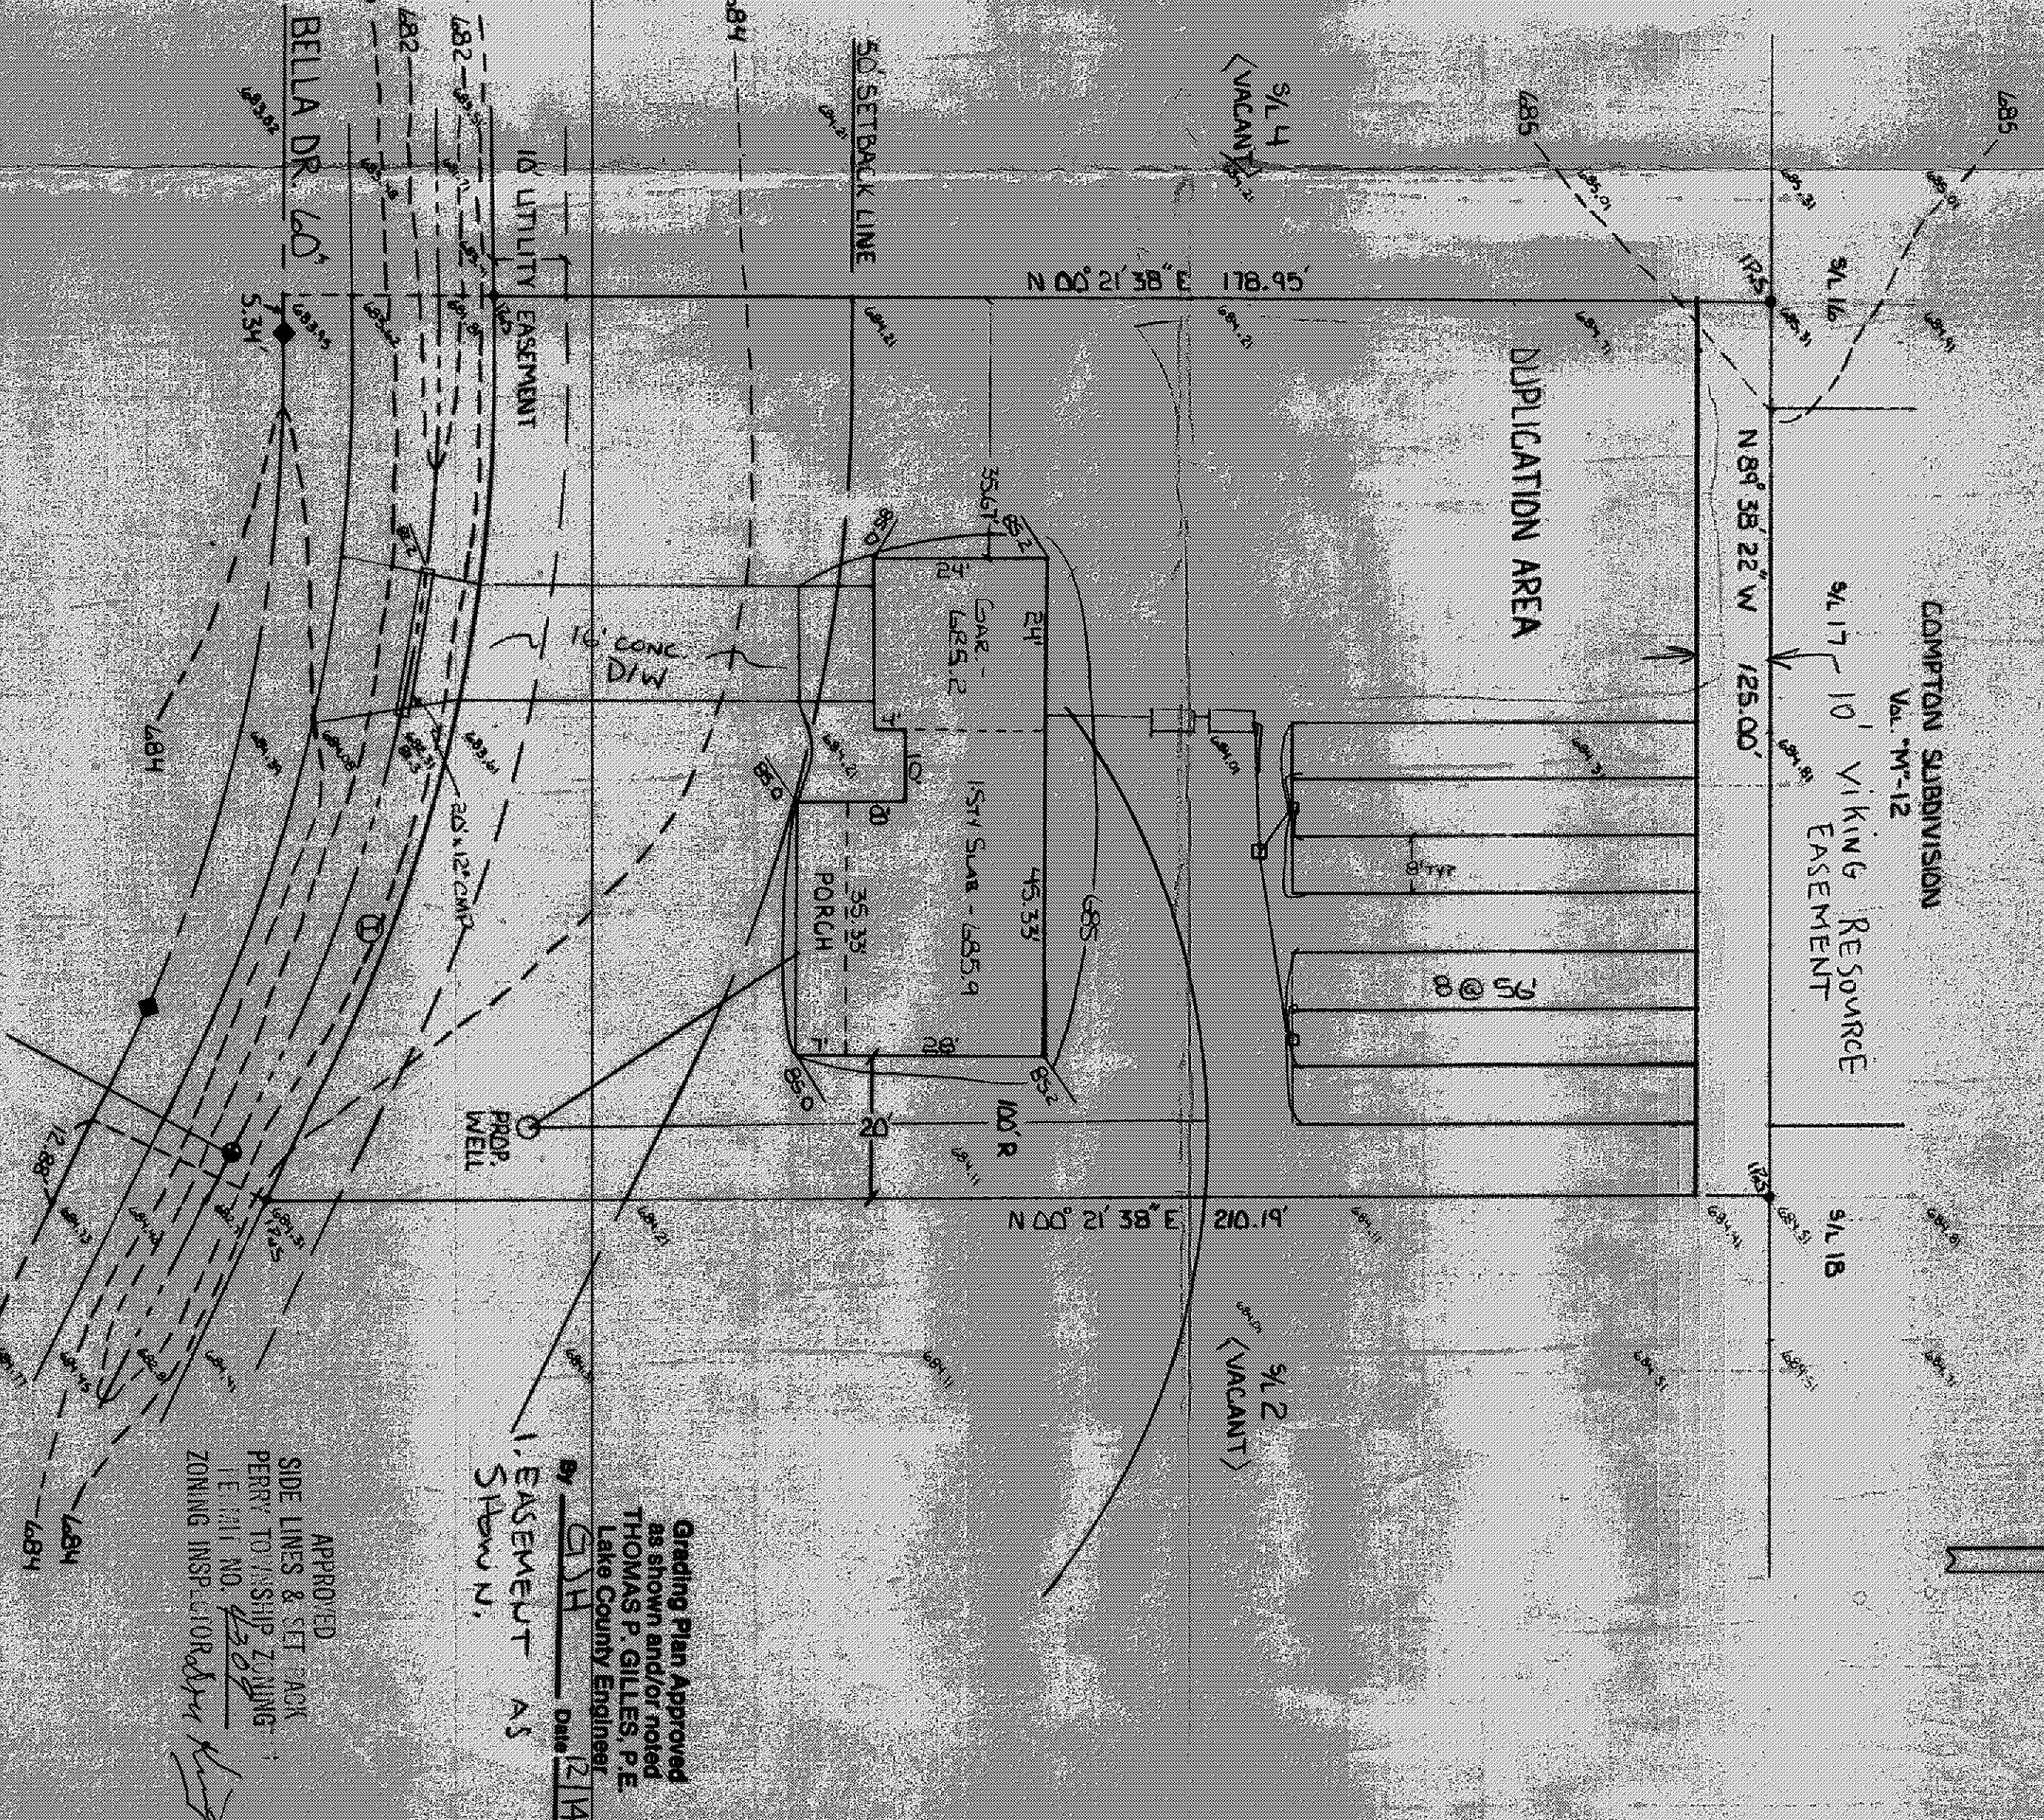

APPROVED
SIDE LINES & SET BACK
PERY TO / SHIP ZONING
12.11.11 NO. 12308
ZONING INSP. CLOR *John King*

Grading Plan Approved
as shown and/or noted
THOMAS P. GILLES, P.E.
Lake County Engineer
Date: 12/14/89
GPH
1. EASEMENT AS
SHOWN.