


SITE PLAN FOR SUBLOT 6 LORETO LANDINGS - PLAT VOL. 44, PAGE 26

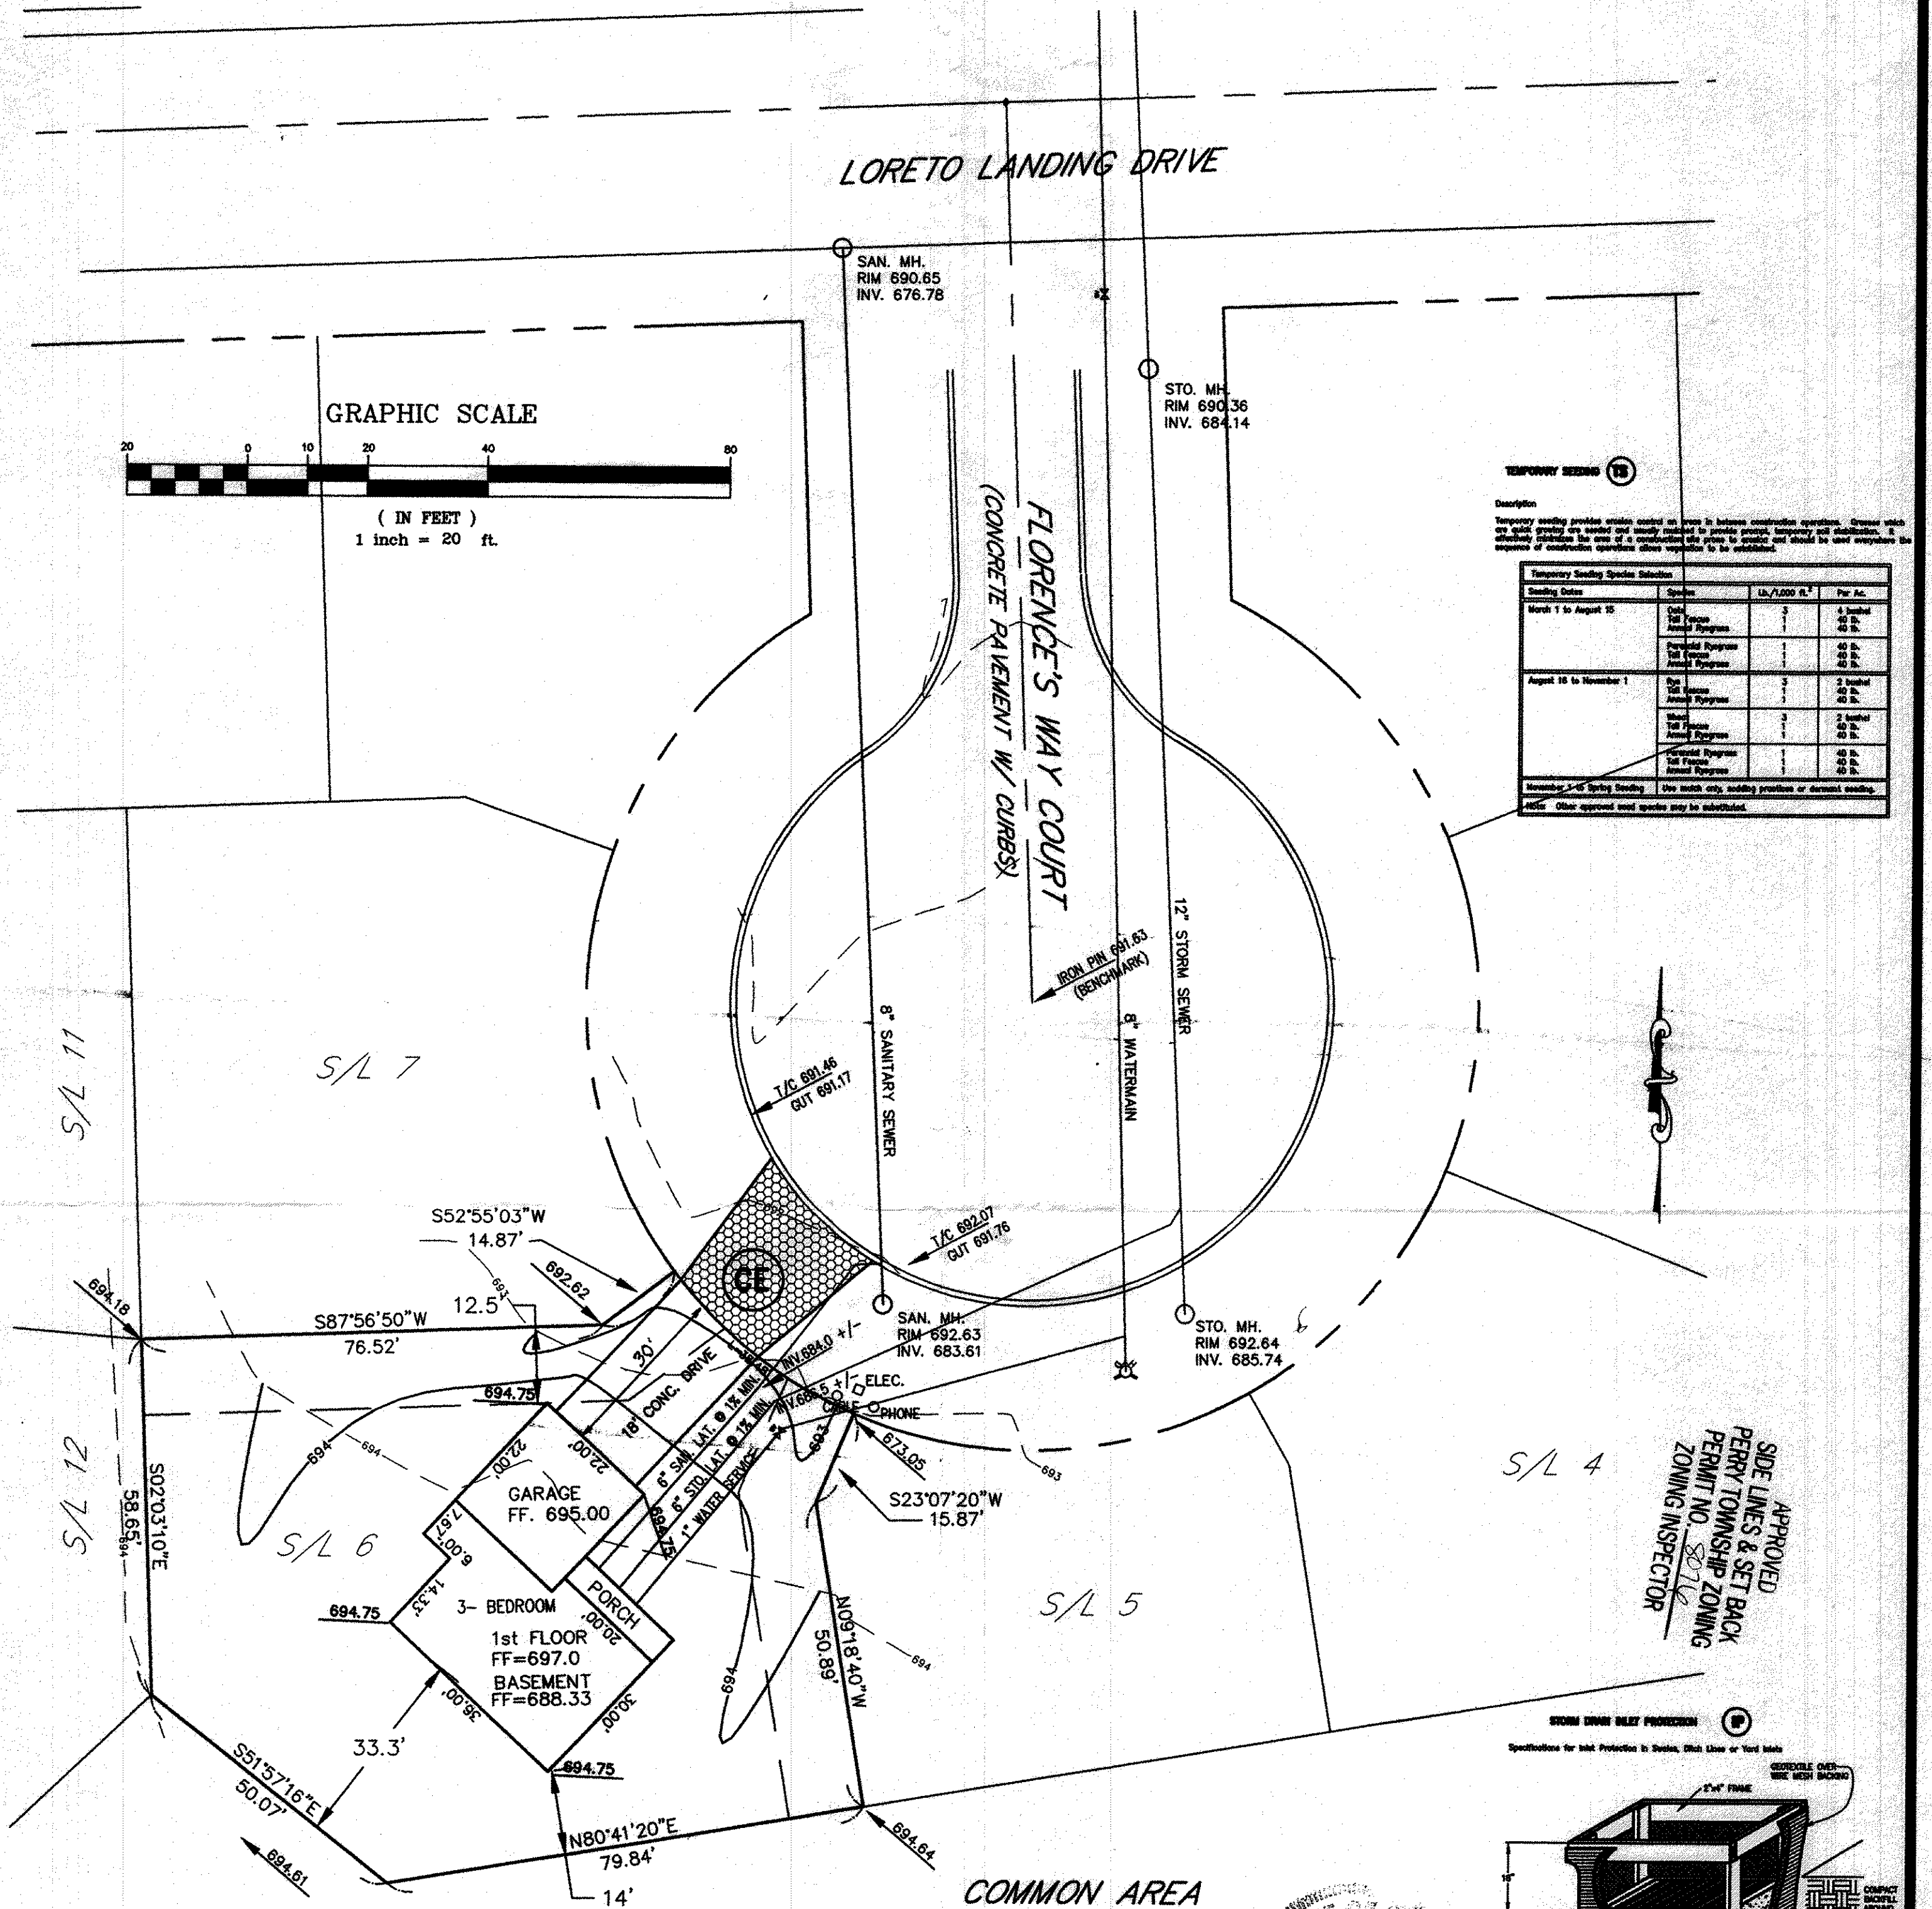


TEMPORARY SEEDING

Description: Temporary seeding provides erosion control on areas in between construction operations. Grasses which are quick growing are seeded and usually retained to provide erosion control. Temporary seeding is not intended to be a permanent seeding. The use of a permanent seeding is to be determined by the sequence of construction operations and vegetation to be established.

Seeding Dates	Species	Lb./A,000 ft. ²	Per A.C.

Other approved seed species may be substituted.

APPROVED
SIDE LINES & SET BACK
PERMITS NO. 80716
ZONING INSPECTOR

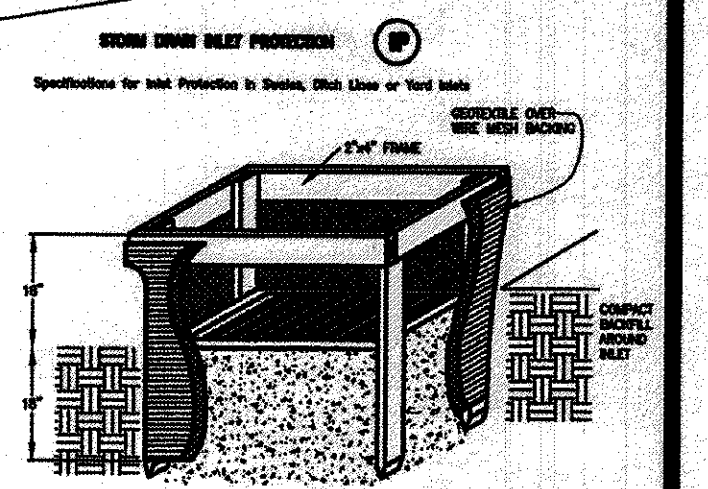

- NOTES:**
- The Contractor Shall Verify the Following Before Starting:
Finish Floor Elevations and House Size.
Location and elevation of existing utility connections.
 - Contractor Shall Contact OUPS at least 2 Working Days prior to construction, 1-800-362-2764.

EROSION AND SEDIMENT CONTROL SCHEDULE

Specifications for Construction Entrance
A stone access drive complete with under lying geo-textile fabric (20 feet wide and 50 feet long) for ingress and egress at the site shall be installed. This drive shall be the only entrance and exit to the site.



Silt Fence
All silt fence shall be installed prior to any earthwork activities at the site in the locations shown on the site plan as well as along the front of any lot that slopes toward the street.

Mulching
Straw-mulch shall be applied at a rate of 1 bale per every ten (10) feet of curb, at a width of thirty (30) feet of the entire length of the lot. Wood chips may also be used but must be spread at a minimum depth of four inches over the thirty-foot width and must be accompanied by a properly installed silt fence.

Temporary Seeding
Disturbed areas of the site that are to remain idle for more than twenty-one (21) days shall be properly seeded and straw mulched within seven (7) days of completion of initial grading. Temporary seeding and mulching of a thirty (30) foot strip of the entire front of the lot shall be maintained on the site once initial grading is complete.

Stabilization of critical areas within fifty (50) feet of any stream or wetland shall be complete within two (2) days of the disturbance if the site is to remain inactive for longer than fourteen (14) days.

Maintenance
Erosion and sediment controls shall be inspected every seven (7) days or within 24 hours of a 0.5" or greater rainfall event. Necessary repairs shall be made at this time.

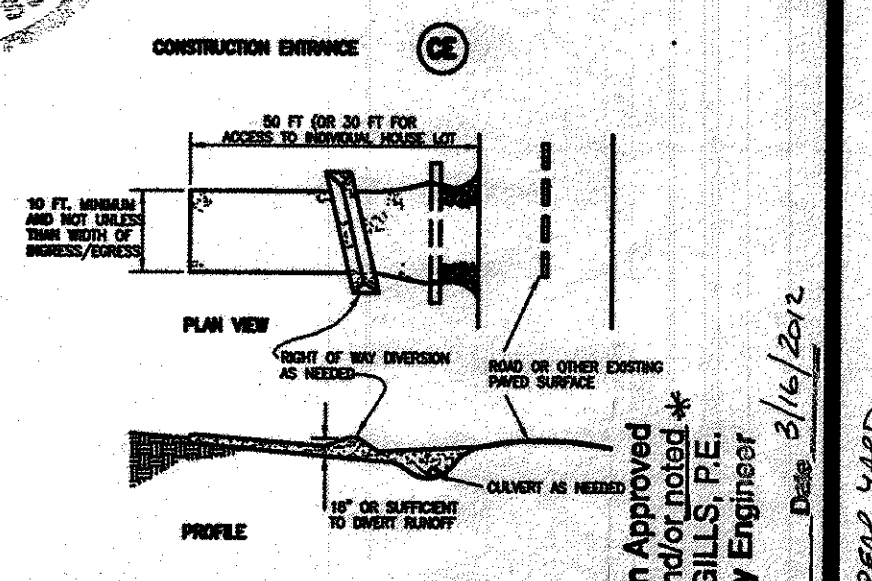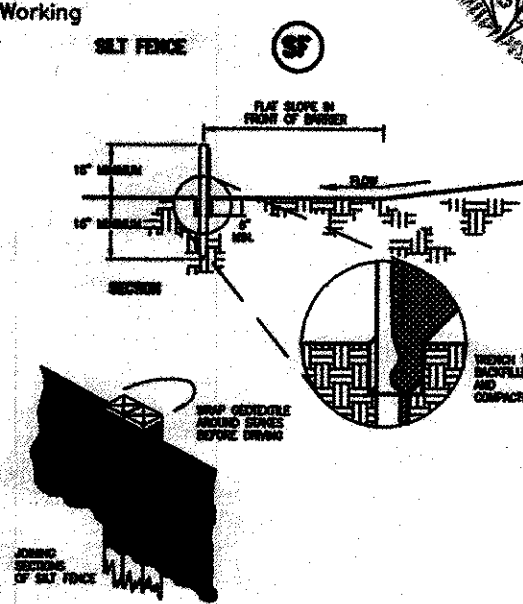

DAVID RAPP SERVICES
dave@usaec.com 440-983-1607

DATE: MARCH 2012
DRAWN BY: DAR
APPROVED BY: DAR
P.S. No. 7597

HSM BUILDERS
LORETO LANDINGS
Site Plan For Sublot 6

"I, the undersigned hereby certify that this topography, indicated by 1' contours and elevations shown hereon represents an actual field survey made by me in March 2012, and that the elevations were taken at appropriate intervals and that as of that date they existed as indicated hereon."

David A. Rapp #1597

Grading Plan Approved
as shown and/or noted *
JAMES R. GILLS, P.E.
Lake County Engineer

By: L.S. Date: 3/16/2012

* GRADE THE REAR YARD
TOWARD THE CUL-DE-SAC