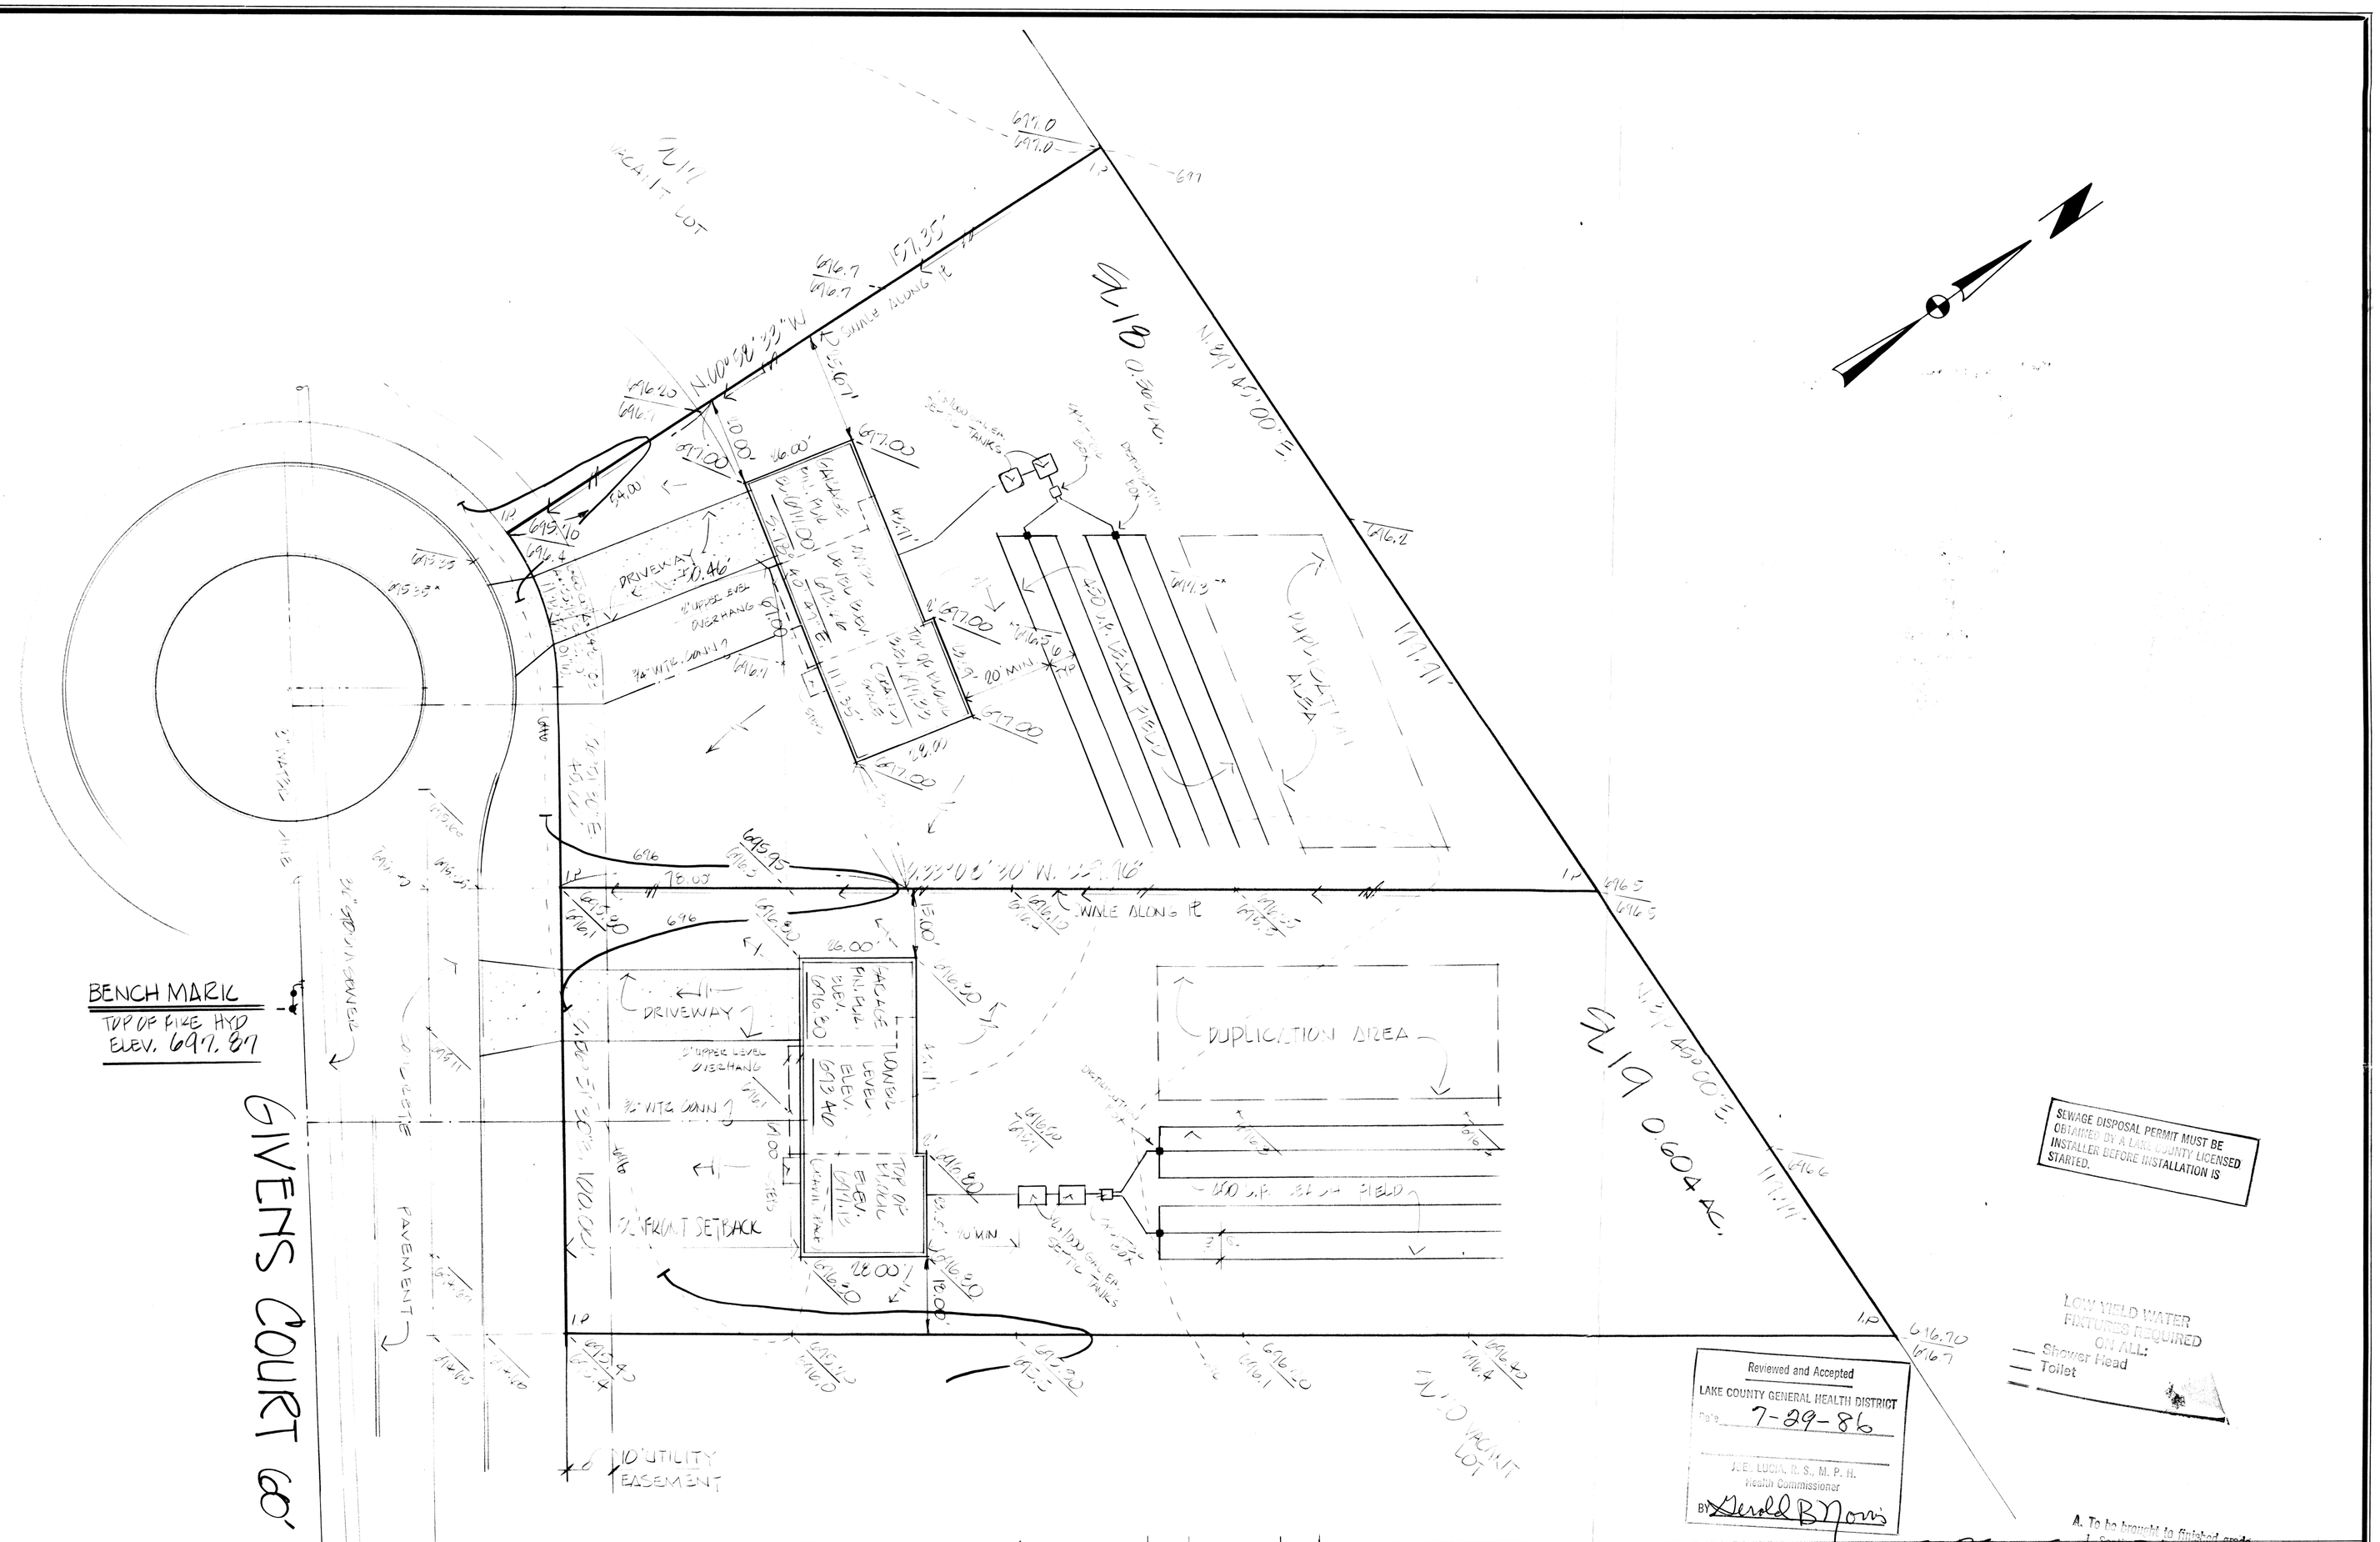

DESIGN CERTIFICATION:
I HEREBY CERTIFY THAT THIS PLAT IS CORRECT TO THE BEST OF MY KNOWLEDGE AND BELIEF.
BY: RICHARD J. BILSKI, P.S. NO. 5244

COLPETZER-THOMAS, INC.
AN ENGINEERING GROUP
WILLOUGHBY • MENTOR • NORTH CANTON • STEUBENVILLE • LORAIN

REV. NO.	DESCRIPTION	DATE	BY	CH'K'D.

DATE JUNE 23, 1986
DRAWN BY: CJ
CHECKED BY:
APPROVED BY:
F.B. No. PG.

SITE PLAN FOR:
CASEMENT HOMES
1251 MADISON AVENUE PAINESVILLE, OHIO.
BEING SUBLOT NO. 18 & SUBLOT NO. 19 IN DAILEY ACRE SUBDIVISION IN PERRY TWP., OHIO.

SCALES	
HOR.	1" = 20'
VERT.	1" = 5'
CONTRACT No.	
83-131-018/019	
SHEET NO.	OF
1	1