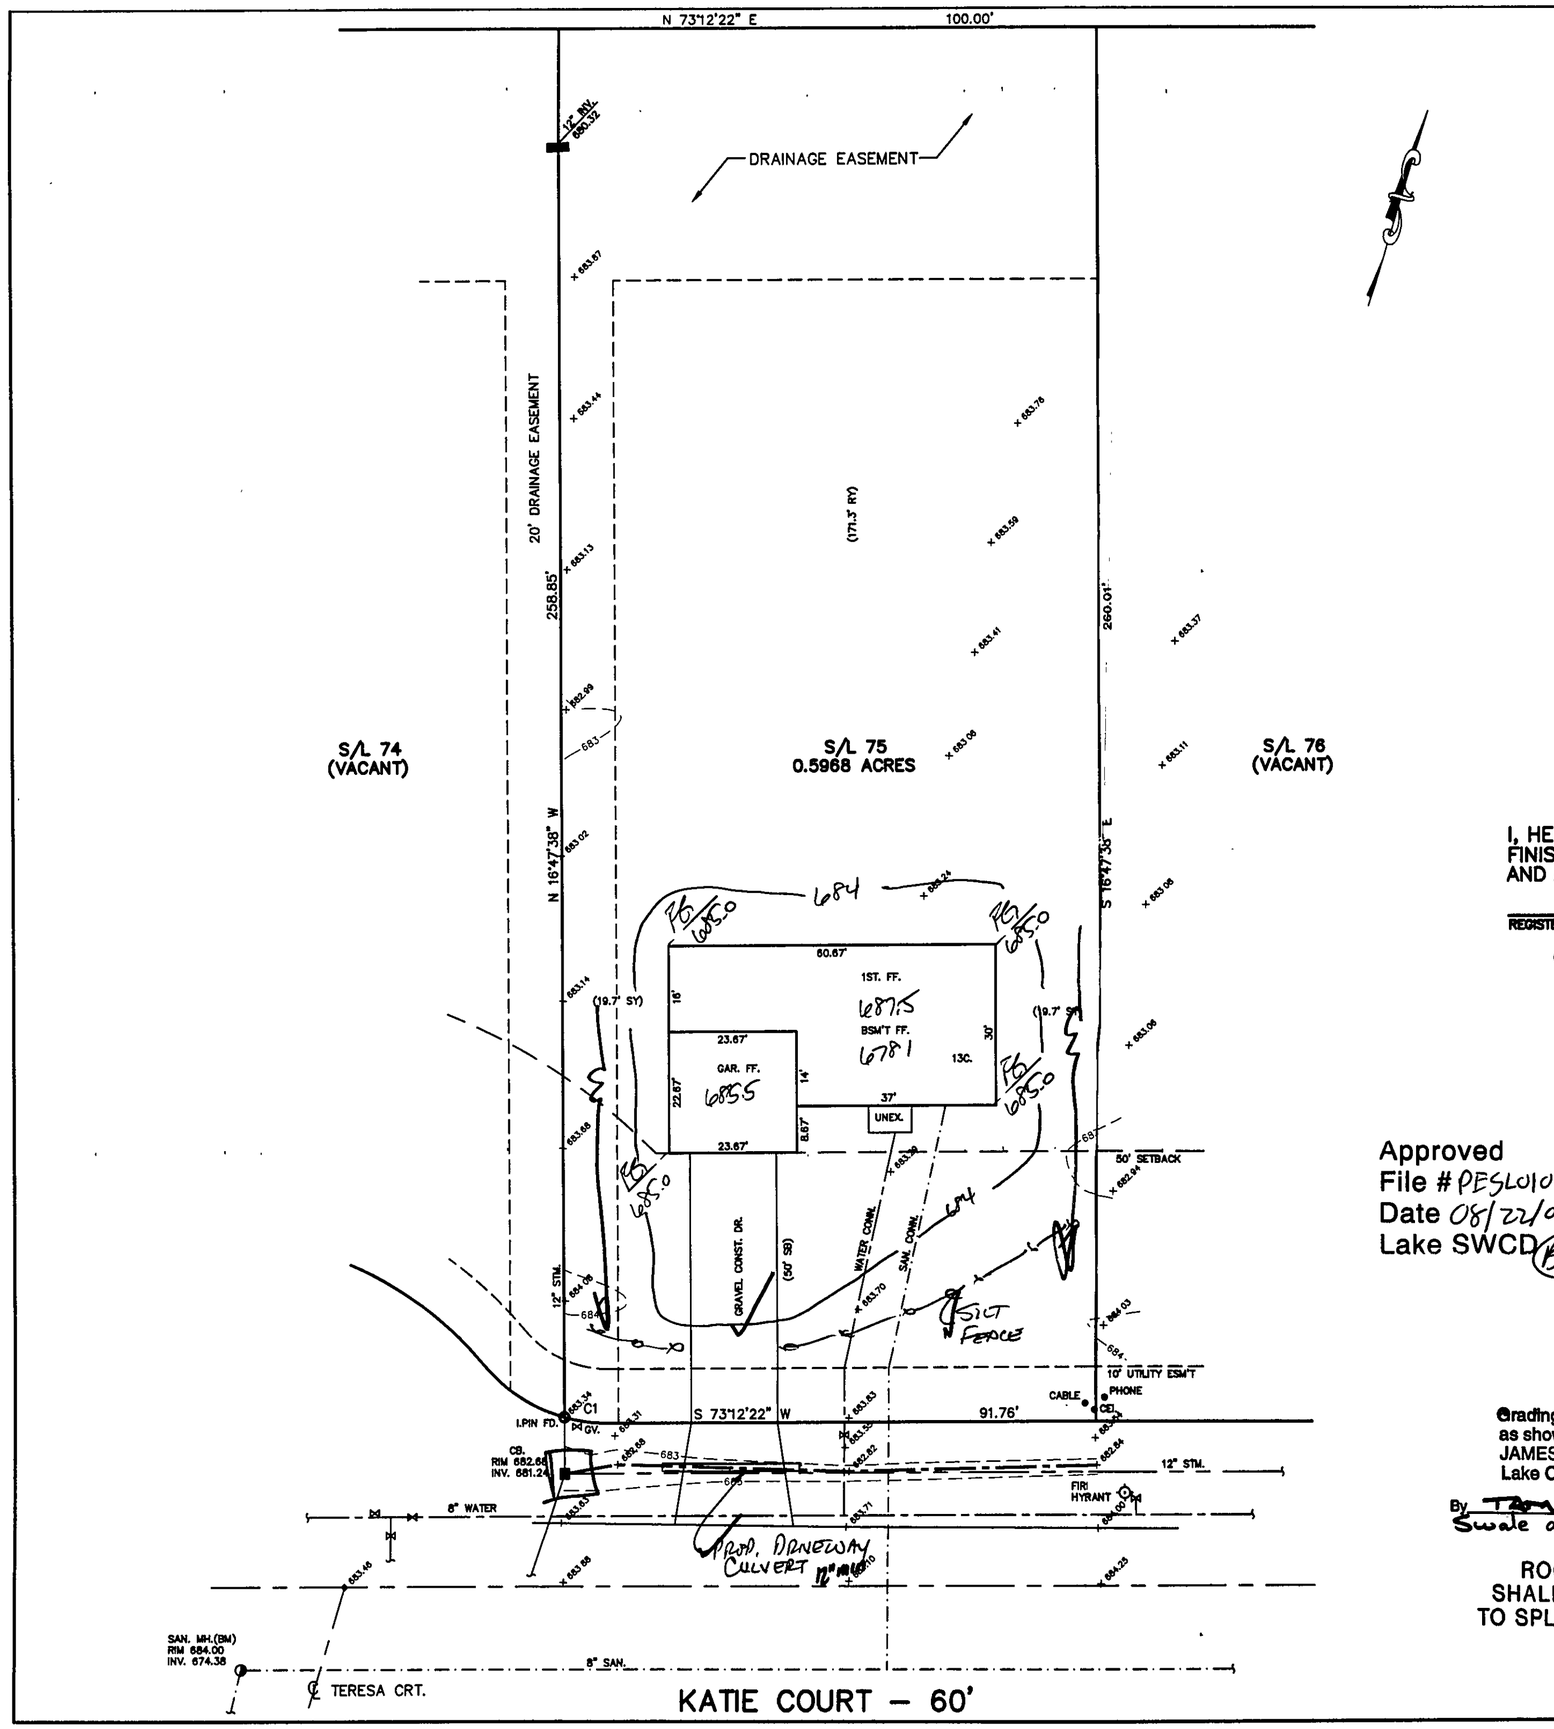

SITE PLAN

PERRY TOWNSHIP, LAKE COUNTY, OHIO

for: STADEN HOMES
CLIENT OWNER

ADDRESS STREET CITY ZIP

RED MILL RUN — SUBDIVISION
38–34 VOL.–PG. — NAME
TRACT
LOT
STREET
75 — SUBLOT NO.
KATIE COURT — STREET
VOL.–PG.
PERM. PARCEL NO.

LEGEND

SANITARY MANHOLE
STORM MANHOLE
INLET OR CATCH BASIN
HYDRANT
EXISTING CONTOURS
PROPOSED CONTOURS

EXIST. ELEV. 100.0 / 100.0 PROP. ELEV.

AS BUILT ELEVATION 100.0

INDICATES DIRECTION OF SURFACE DRAINAGE

DESIGN CERTIFICATION

THIS PLAT WAS PREPARED BY ME, AND IS CORRECT TO THE BEST OF MY KNOWLEDGE AND BELIEF.

NAME SURVEYOR REGISTRATION NO. #6343

REVISIONS		
NO.	DATE	BY
1		
2		
3		
4		
5		

PLAN PREPARED BY:
BABCOCK · JONES & ASSOCIATES, INC.
PAINESVILLE, OHIO

DRAWN BY T.R.	SCALE 1"=20'	PHONE NO. 440–357–1811	
CHK'D. H.J.	DATE 7/27/01	DRAWING NO. 93–032–75	
CREW CHIEF R.B.	APP'D H.J.		

"AS BUILT" CERTIFICATION
I, HEREBY CERTIFY THAT THE CIRCLED GRADES ARE EXISTING FINISH GRADES CHECKED IN THE FIELD ON _____, 20___ AND ARE CORRECT TO THE BEST OF MY KNOWLEDGE AND BELIEF.

REGISTERED SURVEYOR REG. NO.

C1: R=30.00'
L=8.34'
T=4.20'
D=15°56'02"
C=8.32'
N81°10'23"E

BM–SANITARY MANHOLE
RIM=684.00

NOTE: TEMPORARY SEEDING REQUIRED IN DISTURBED AREAS.

Approved
File # PESL010160
Date 08/22/01
Lake SWCD BN

APPROVED
SIDE LINES & SET BACK
PERRY TOWNSHIP ZONING
PERMIT NO. 7160
ZONING INSPECTOR

Grading Plan Approved
as shown and/or noted
JAMES R. GILLS, P.E.
Lake County Engineer
By TAM Date 8/30/01
Swale as Shown

ROOF DRAINS
SHALL DISCHARGE
TO SPLASH BLOCKS.

STATE OF OHIO
HARRY S. JONES, JR.
S-6343
REGISTERED
PROFESSIONAL SURVEYOR