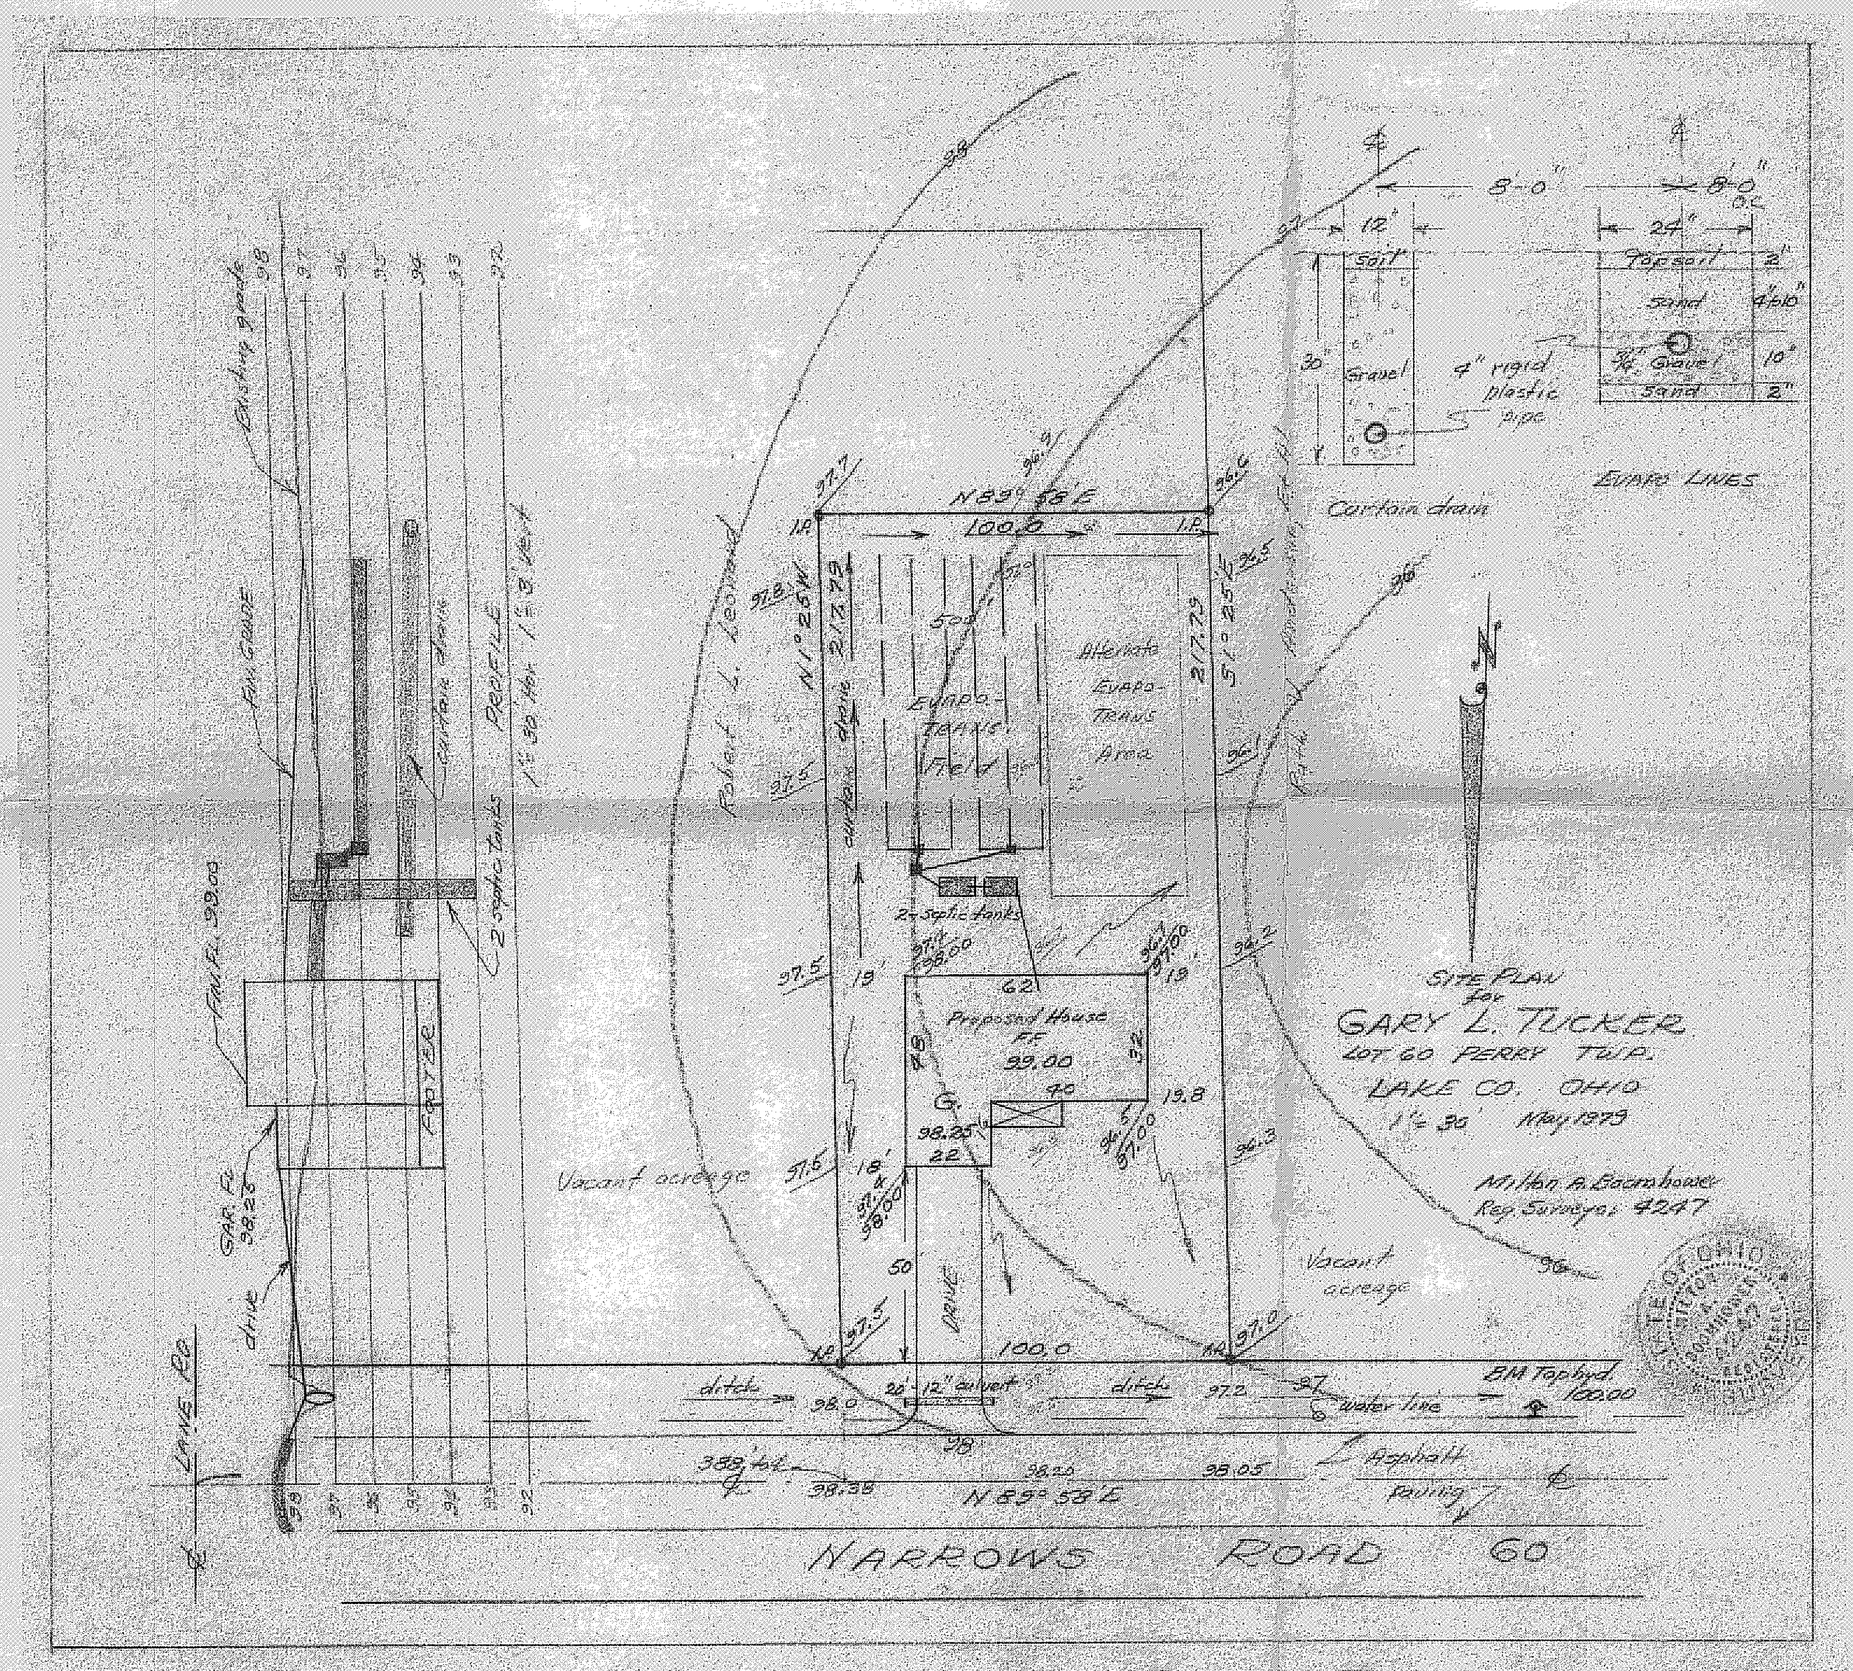

Reviewed and Accepted

LAKE COUNTY COMBINED GENERAL DISTRICT DEPARTMENT OF HEALTH

Date 5-18-79

FRED C. KLUTH, M. D.
Health Commissioner
By J. Munnings

A. To be brought to finished grade
1. Septic tank manhole covers
2. Splitter box cover
3. Distribution box cover
4. Vent Pipes

B. No footer drains or downspouts to be discharged into septic tanks

C. All waste water to be discharged into septic tanks

Grading Plan Approved as shown and/or noted
THOMAS P. GILLES, P.E.
Lake County Engineer
By [illegible] Date 5-18-79

APPROVED
SIDE LINES & SET BACK
PERRY TOWNSHIP ZONING
PERMIT NO. 22-56
ZONING INSPECTOR
R.W. [illegible]