


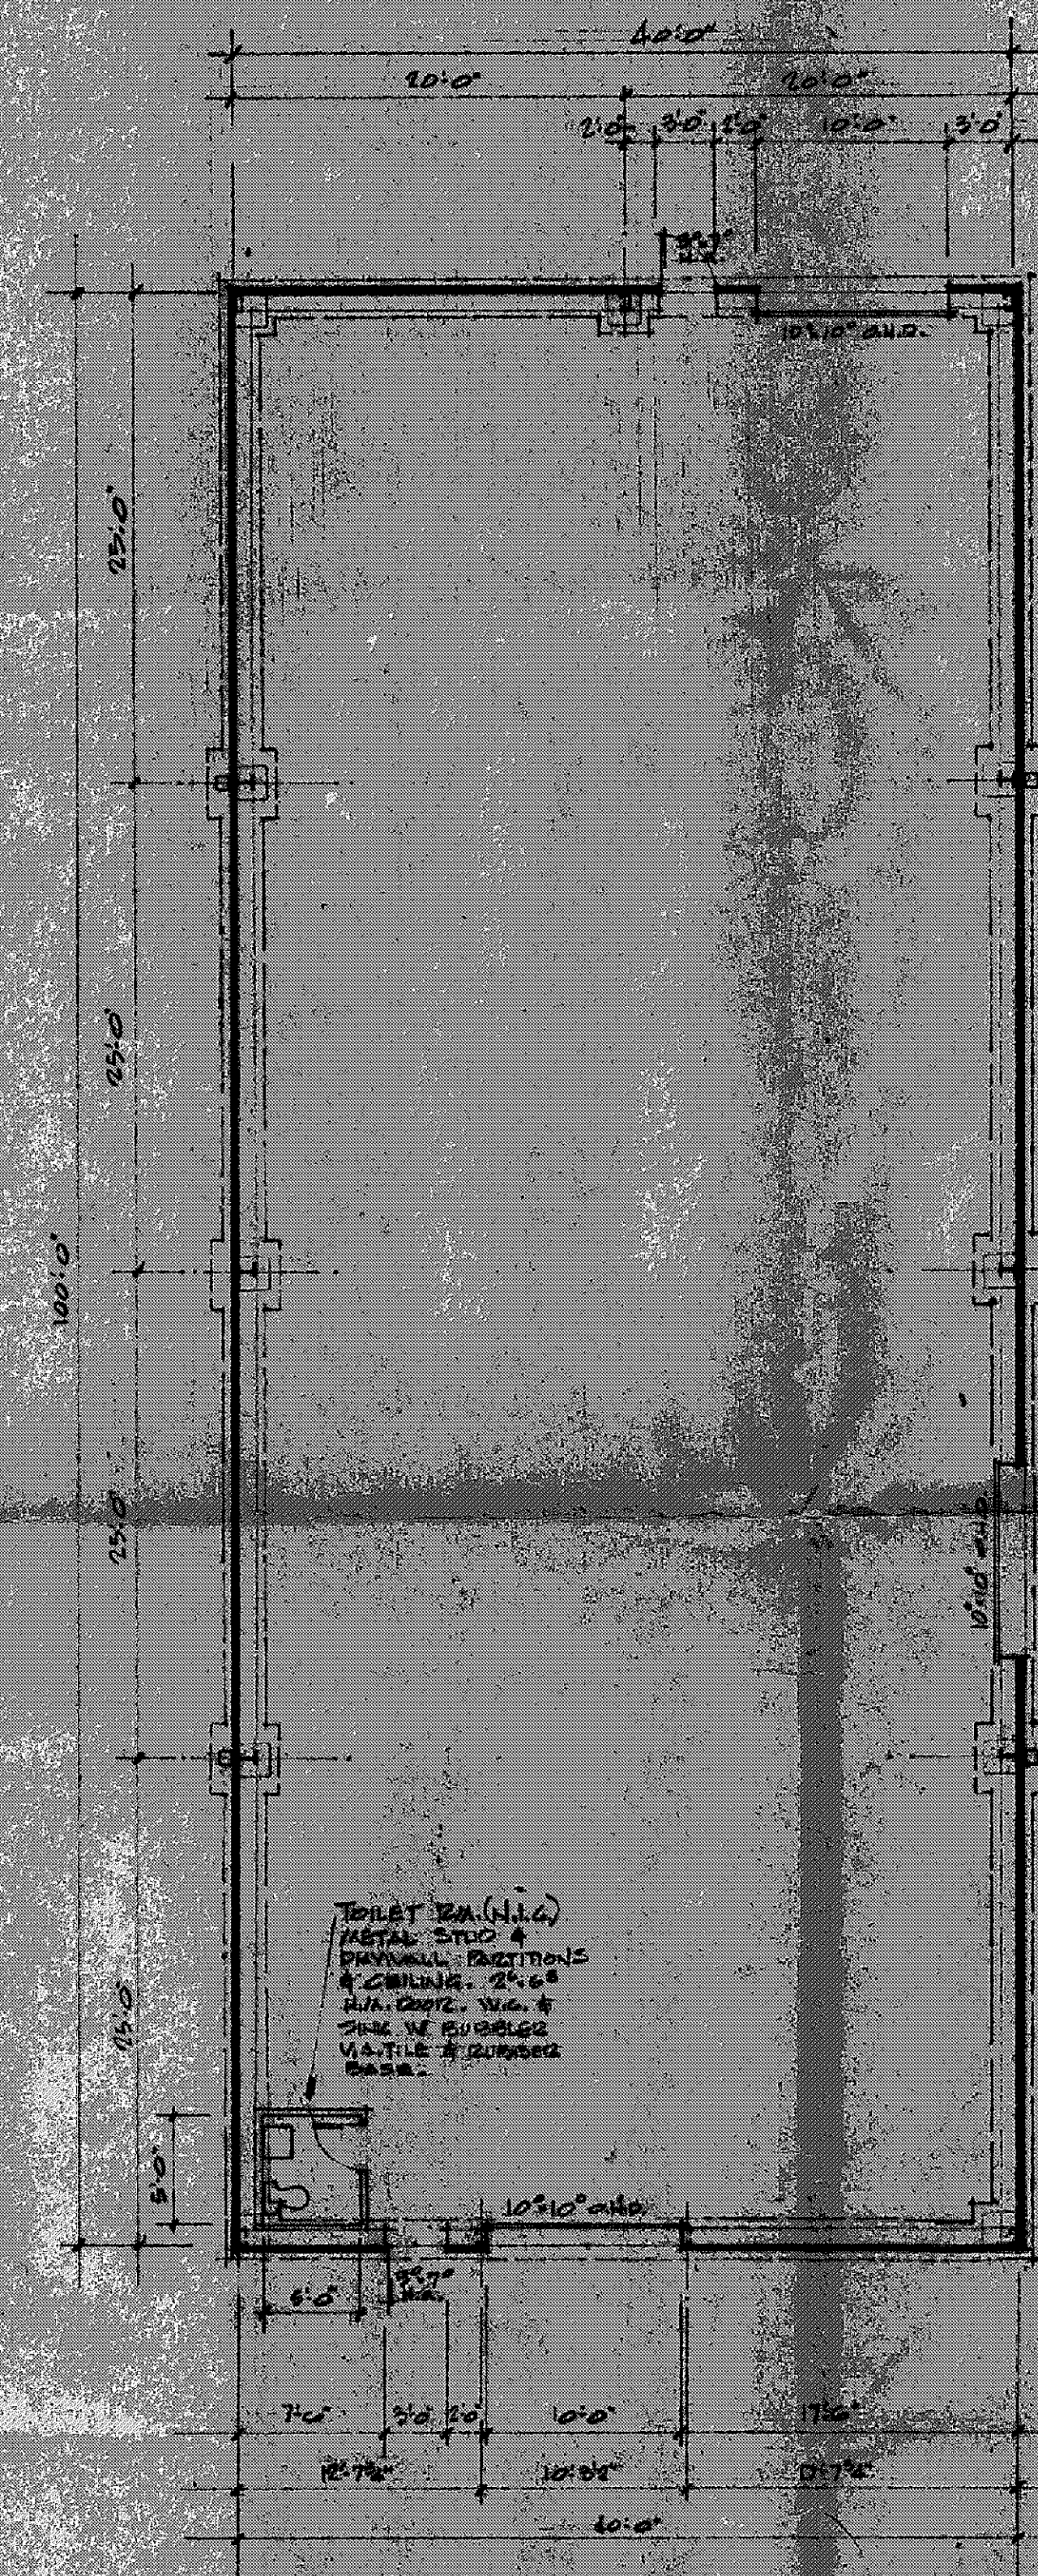


NEW BUILDING - 4,200 SF.
EXIST. BUILDINGS - 6,632 SF.


TOTAL - 10,832 SF.

LAND AREA - 110,820 SF. (2.53 AC)

% BLDG/LAND - 9.6%

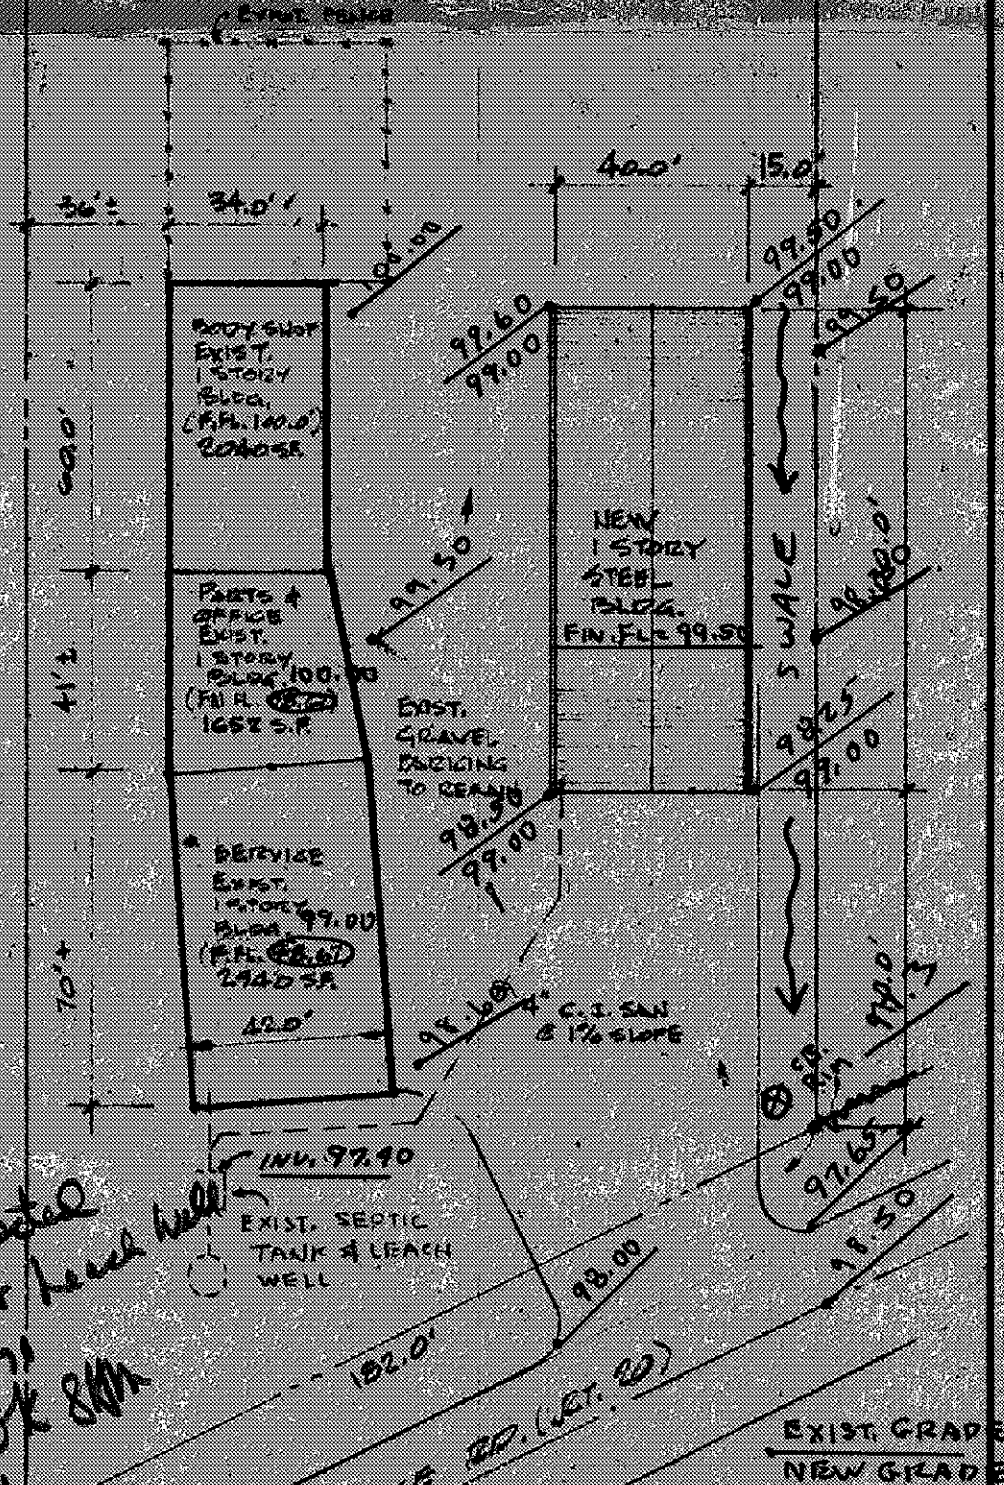

Grading Plan Approved
as shown and/or noted
THOMAS P. GILLES, P.E.
Lake County Engineer
By TSK Date 12-16-2

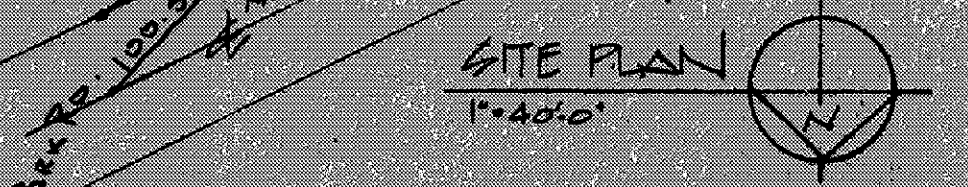

zelko
designers
engineers
builders

**BUILDING
SYSTEMS**

1372 LLOYD ROAD
WICKLIFFE, OHIO 44092
(216) 944-3757

REVISIONS: 2-19-76 - FRAMES	PROJECT: NEW BODY SILLOR FOR LAKE COUNTY FOREIGN CAR SERVICE, INC. 3380 NORTH GIBBS RD. PERRY TOWNSHIP, OHIO
--------------------------------	--

APPROVED
SIDE LINES & SET BACK
PERRY TOWNSHIP ZONING
PERMIT NO. 1893
ZONING INSPECTOR
R.W. Pattenhouse

