SITE PLAN
FOR
R. L. REED CONST.
BEING A PART OF LOT NO 25. IN THE
TOWNSHIP OF PERRY, COUNTY OF LAKE.
STATE OF OHIO

EXIST / PROP

1" = 30'

N 0° 38' 16" W 1235.73'

S 88° 25' 30" E 140.69'

S 51° 15' 41" E 1161.46'

S 15° 42' 00" W 165.00'

30' TO 4 RUN RD

WATER CONN

GRAVEL D/W

ASPHALT

DUPLICATION AREA

* LINES TO FOLLOW CONTOURS AS THEY EXIST AFTER TREES ARE REMOVED

FF - 843.2

BSMT - 834.53

GAR - 841.2

Grading Plan Approved
as shown and/or noted
THOMAS P. GILLES, P.E.
Lake County Engineer
By GJH Date 8/30/91

A. To be brought to finished grade
1. Septic tank manhole covers
2. Splitter box cover
3. Distribution box cover

B. No footer drains or downspouts to be discharged into septic tanks

C. All house water to be discharged into septic tanks

APPROVED
SIDE LINES & SET BACK
PERRY TOWNSHIP ZONING
PERMIT NO. 4526
ZONING INSPECTOR Don King

HYDRAULIC PROFILE
HORZ - 1" = 30' VERT - 1" = 3'

3 BEDROOM RESIDENCE

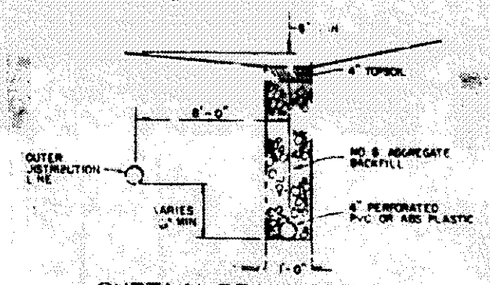

CURTAIN DRAIN DETAIL

Reviewed and Accepted
LAKE COUNTY GENERAL HEALTH DISTRICT
Date 8-27-91
JOEL LUCIA, R. S., M. P. H.
Health Commissioner
BY N. Nicholas

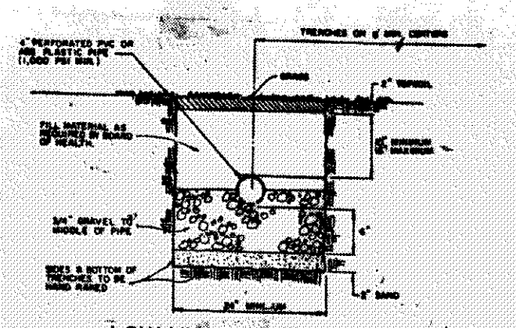

LOW YIELD WATER FIXTURES REQUIRED ON ALL:
___ Shower Head
___ Toilet
___ _____

SEWAGE DISPOSAL PERMIT MUST BE OBTAINED BY A LAKE COUNTY LICENSED INSTALLER BEFORE INSTALLATION IS STARTED.

AUG. 20, 1991

I, the undersigned hereby certify that this topography, indicated by 1' contours and elevations shown hereon represents an actual field survey made by me on July 8, 1991 and that the elevations were taken at appropriate intervals and that as of that date they existed as indicated hereon.

J. M. Coffman P.S. No 6857

VILLAGE SURVEYING Co.
282 THIRD ST., FAIRPORT HBR., OHIO 44077
(216) 357-1359