

SCALE 1"=30'

2

HYDRAULIC PROFILE
VERT. 1"=3' HORIZ. 1"=50'

3 BEDROOM HOME

BENCHMARK 100.00 ASSUMED
TO BOLT HYDRANT

SITE PLAN
FOR
KEN DRESS
BEING PART OF THE RIVERVIEW ADJUTMENT
(PROPOSED) IN THE TOWNSHIP OF PERRY,
COUNTY OF LAKE, STATE OF OHIO
4255 RIVER RD

N 38° 46' 00" E

183.72

RIVER ROAD 60'

S 75° 48' W

226.01

PUMP TO
DUPLICATION

SET @ 125'

NOTE: E-T LINES TO FOLLOW
CONTOURS AFTER FINAL CLEARING
AND GRADING

APPROVED
SIDE LINES & SET BACK
PERRY TOWNSHIP ZONING
PERMIT NO. 4787
ZONING INSPECTOR *Robert King*

Grading Plan Approved
as shown and/or noted
THOMAS P. GILLES, P.E.
Lake County Engineer

By *GT/H* Date 12/15/92

Dec. 8, 1992

Reviewed and Accepted
LAKE COUNTY GENERAL HEALTH DISTRICT
Date 12/11/92
JOE LUCIA, R.S.M.P.H. Health Commissioner
BY <i>Nancy Nielsen</i>


- A. To be brought to finished grade
1. Septic tank manhole covers
 2. Sifter box cover
 3. Distribution box cover
- B. No footer drains or downspouts
to be discharged into septic tanks
- C. All waste water to be discharged into
septic tanks

SEWAGE DISPOSAL PERMIT MUST BE
OBTAINED BY A LAKE COUNTY LICENSED
INSTALLER BEFORE INSTALLATION IS
STARTED.

LOW YIELD WATER
FIXTURES REQUIRED
ON ALL

Shower Head
Toilet

VILLAGE SURVEYING CO.
202 THIRD ST. FAIRPORT HARBOR, OHIO 44071
(216) 357-1554

 

1. The undersigned hereby certifies that
this engineering drawing is a true and
correct representation of the actual
work done and that the same was
prepared by the undersigned or under
his direct supervision and that he is
a duly licensed professional engineer
in the State of Ohio.

1. M. Coffman 25
NOV 27 1992