


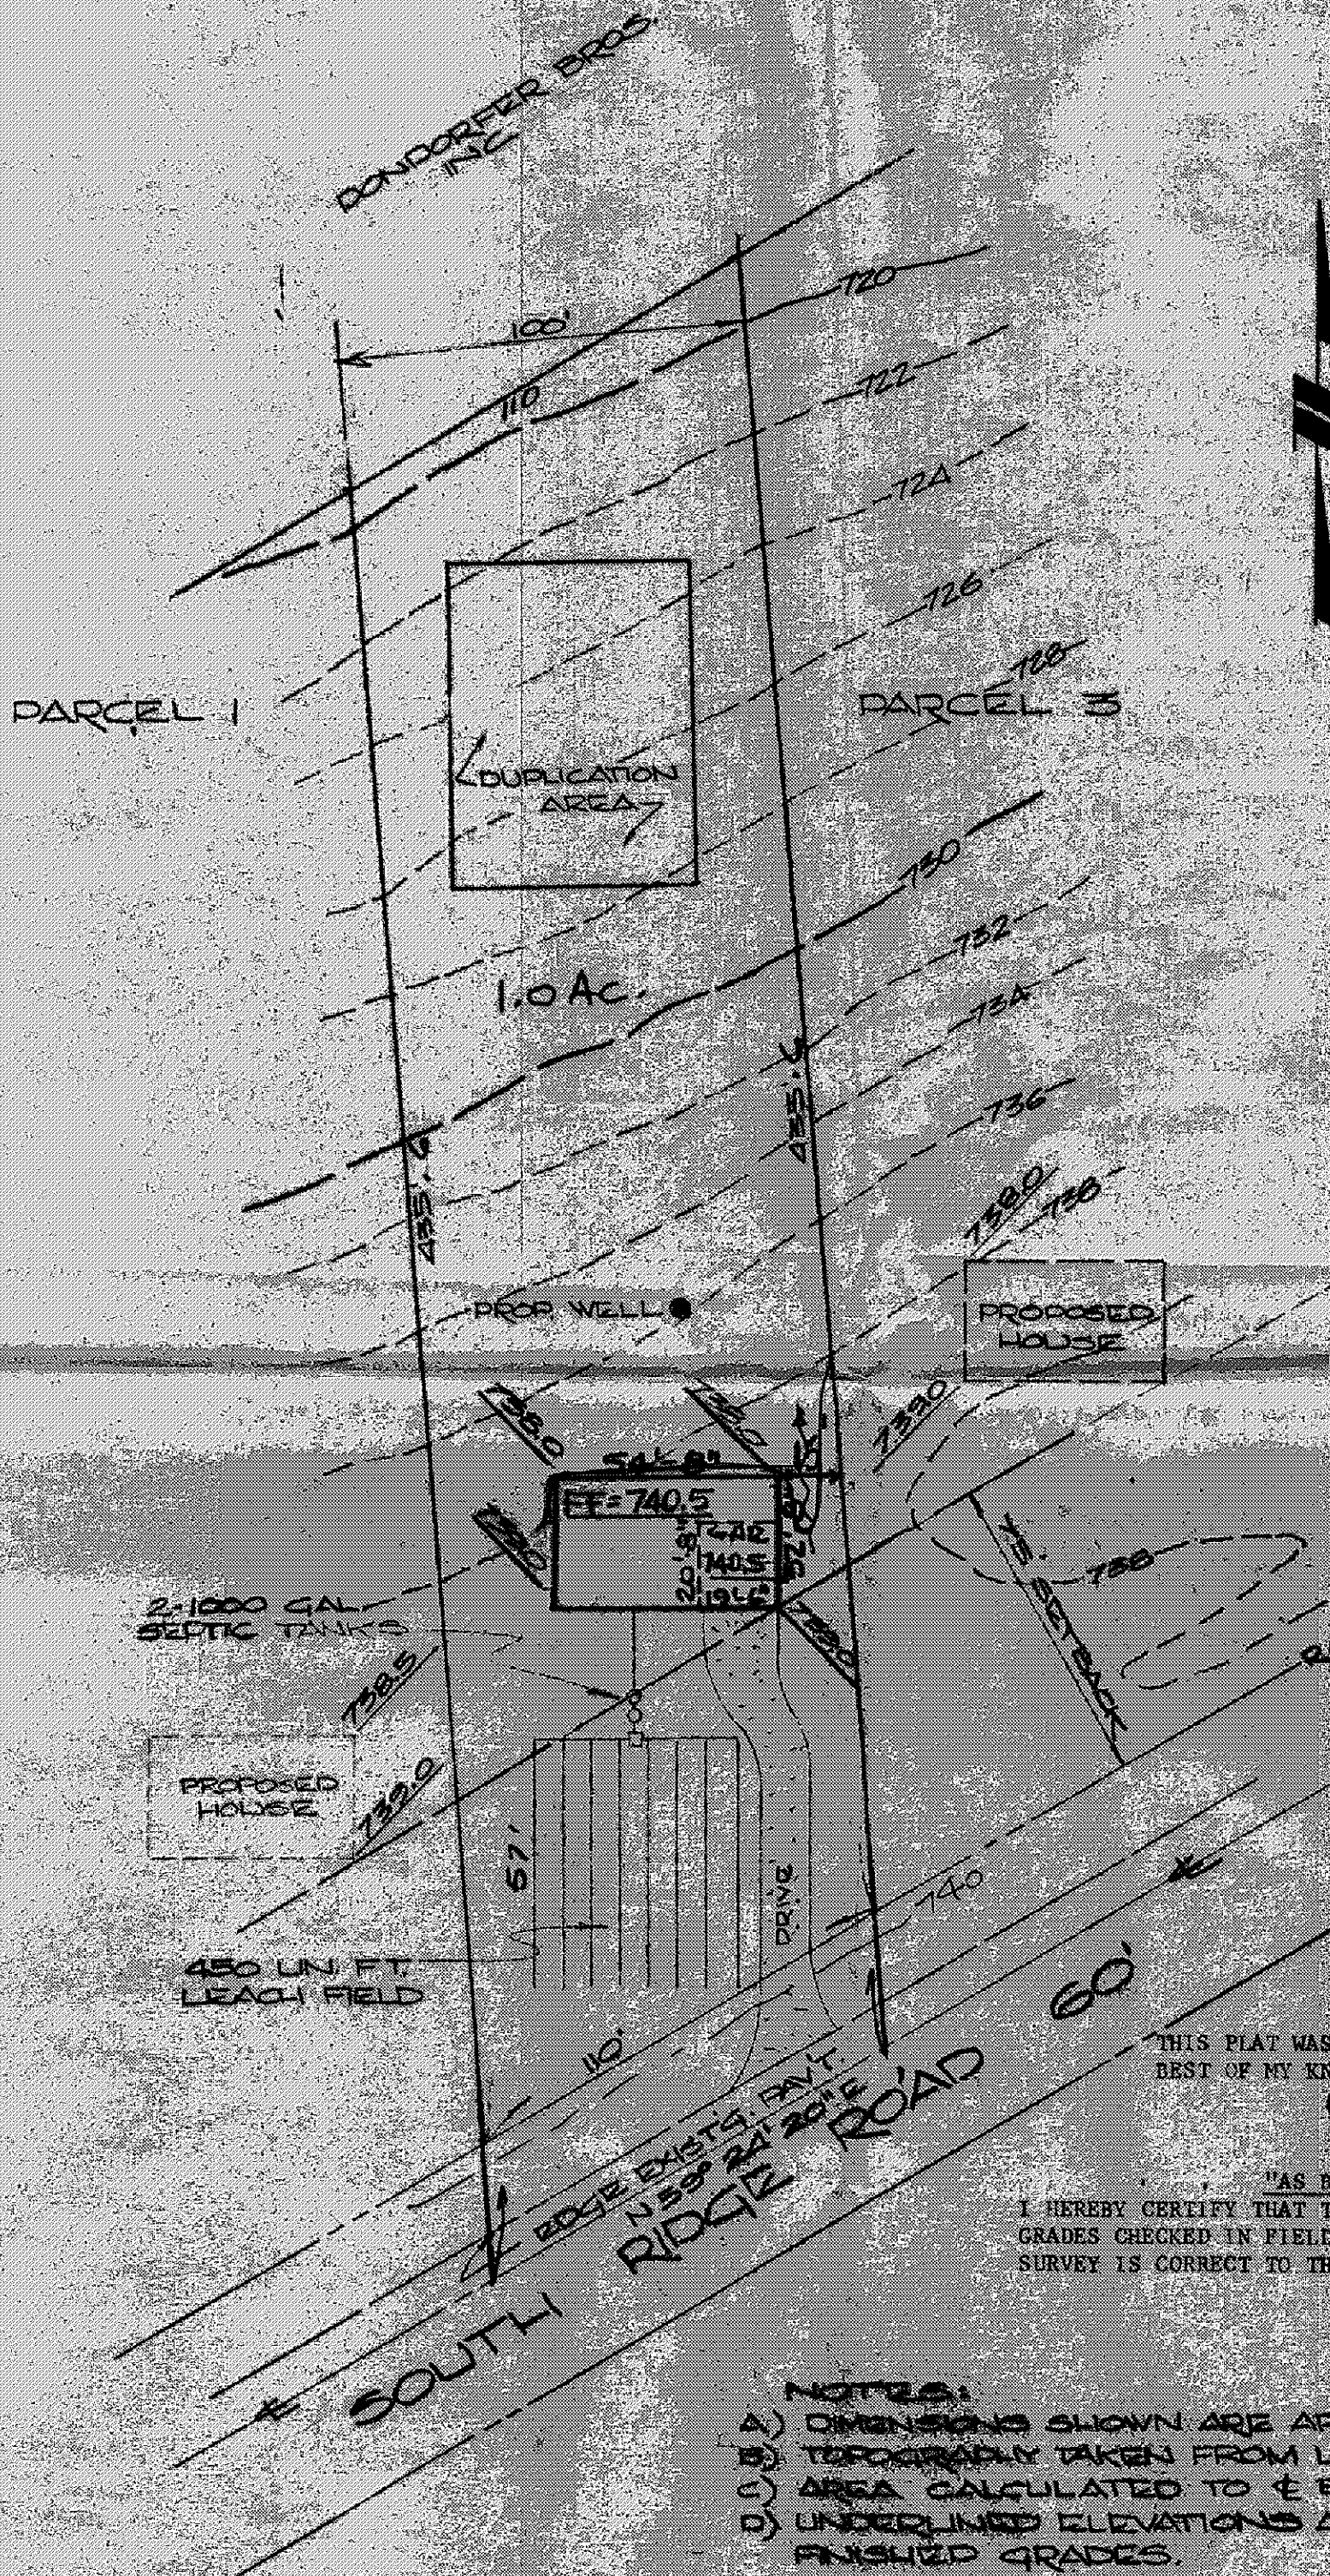

Grading Plan Approved
as shown and for noted
THOMAS E. WOODS, P.E.
Lake County Engineer

Thomas E. Woods
Date 6/26/76

DESIGN CERTIFICATION
THIS PLAN WAS PREPARED BY ME AND IS CORRECT TO THE
BEST OF MY KNOWLEDGE AND BELIEF.

Elisabeth
REG. SURVEYOR #4785

"AS BUILT" CERTIFICATION
I HEREBY CERTIFY THAT THE CIRCLED GRADES ARE EXISTING FINISH
GRADES CHECKED IN FIELD ON 19
SURVEY IS CORRECT TO THE BEST OF MY KNOWLEDGE AND BELIEF.

REG. SURVEYOR #

- NOTES:**
- A) DIMENSIONS SHOWN ARE APPROXIMATE.
 - B) TOPOGRAPHY TAKEN FROM LAKE COUNTY TOPO MAPS
 - C) AREA CALCULATED TO EXISTING ROAD
 - D) UNDERLINED ELEVATIONS ARE PROPOSED FINISHED GRADES.

PARCEL # 2

APPROVED
SIDE LINES & SET BACK
PERRY TOWNSHIP ZONING
PERMIT NO. 1718
ZONING INSPECTOR

R.W. Attenhouse

3567 South Ridge Rd.

SITE PLAN
FOR

RIDGEVIEW HOMES

PART OF LOT 37
PERRY TOWNSHIP, LAKE COUNTY, OHIO

Colpetzer • Woods Consultants, Inc.

CONSULTING ENGINEERS AND SURVEYORS
PAINESVILLE, OHIO 44077

#75-163

DATE NOV. 1976
SCALE 1"=40'
DRAWN BY J.M.
CHKD BY J.
F.B. PG.