


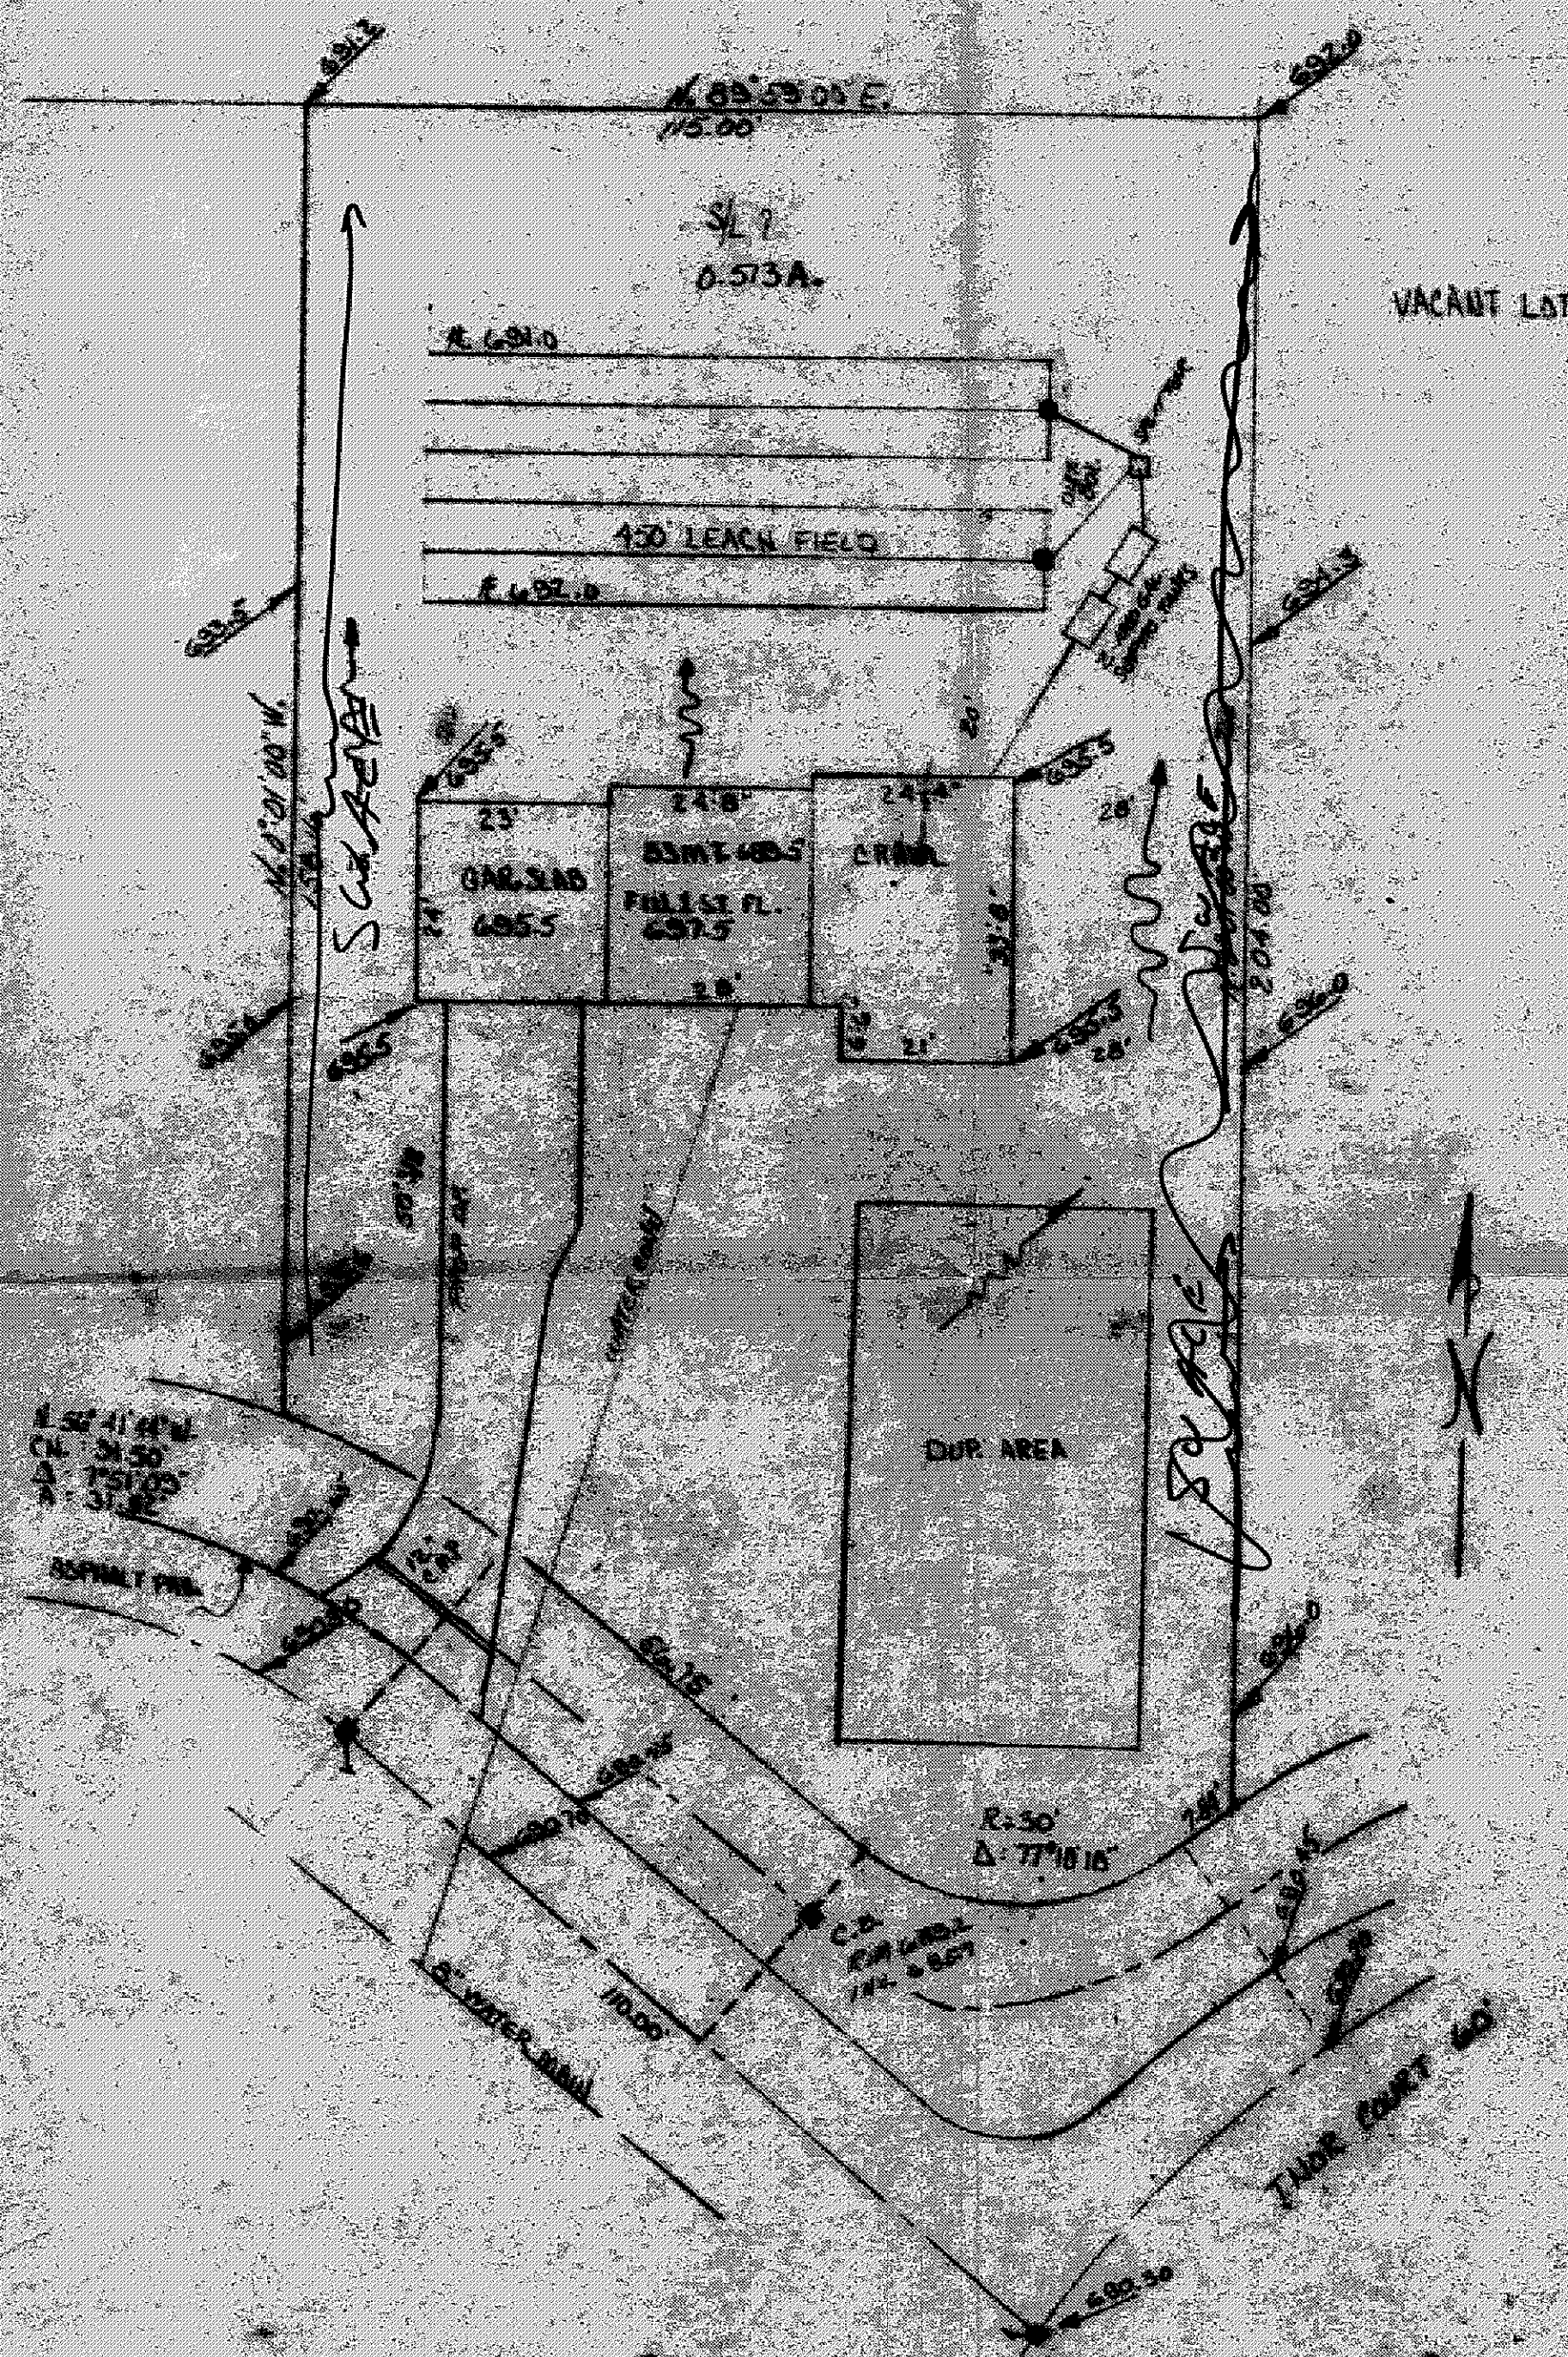

Grading Plan Approved
as shown and/or noted
THOMAS P. GILLES, P.E.
Lake County Engineer
By Joe Date 1/8/07

SITE PLAN

PERRY TOWNSHIP LAKE COUNTY,

FOR: RAY SLAYTON

ADDRESS STREET CITY

SUBDIVISION NAME LOT TRA
7 SOUTHWOOD VOLUME PAGE
SUBLOT NO. STREET PERM. PARCEL NO. STR

LEGEND

SANITARY MANHOLE
STORM MANHOLE
INLET OR CATCH BASIN
HYDRANT
EXISTING CONTOURS
PROPOSED CONTOURS
EXIST. ELEV. 1000.0 PROP. ELEV. 1000.0

WATER VALVE (GAS)
WATER METER (GAS)
AS BUILT ELEVATION
INDICATES DIRECTION OF SURFACE DRAINAGE

REMARKS

ALL BOUNDARY DATA SHOWN WAS OBTAINED FROM (DEEDS, RECORDS, SUBDIVISION PLAT OR OTHER PUBLIC RECORDS)
LOCATIONS AS SHOWN OF ADJACENT WELLS AND SEPTIC TANKS OR FROM LAKE COUNTY HEALTH DEPARTMENT.

DESIGN CERTIFICATION

THIS PLAT WAS PREPARED BY ME, AND IS CORRECT TO THE BEST OF MY KNOWLEDGE AND BELIEF.

NAME John C. Skonieczny REGISTRATION NO. 5-6356

CHECK LIST

NO. OF BEDROOMS
DIMENSIONS
BEARINGS
TIE TO NEAREST STREET
SUBLOT NO. PARCEL NO.
SURROUNDING OWNERS
BLDG. DIMENSIONS FIN. OR
BLDG. TIE FLY. GRADERS
APRON TYPE WIDTH THICKNESS
SIDEWALK TYPE WIDTH THICKNESS
CULVERT TYPE DIA. LENGTH
ROCK DITCH/STOPS
OVERHANGS

WATER MAIN SIZE, LOCATION
SAN. SEWER SIZE 1/2" DIA. LOC.
SAN. MFL. CAST ELEV. INV. E.
SAN. CONN. SIZE, LOC. DEPTH
STORM SEWER SIZE 1/2" DIA. L.
STORM MFL. CAST ELEV. INV.
PACE TYPE GRADE CURVES
GAS LINE 1/2" DIA. PRESS.
SEPTIC TANK LOCATION & DIA.
WELL LOCATION
ISOLATION RADIUS FROM WELL

REVISIONS

NO.	DATE	BY
1		
2		
3		
4		
5		

PLAN PREPARED BY:

JOHN C. SKONIECZNY
REG. SURVEYOR

DRAWN BY J.C.S. SCALE 1"=20' PHONE NO.
CHK'D DATE 1/11/07 DRAWING
CHK'D APP'D.

"AS BUILT" CERTIFICATION

I, HEREBY CERTIFY THAT THE CIRCLED GRADES EXISTING FINISH GRADES CHECKED IN FIELD IS BY AND A CORRECT TO THE BEST OF MY KNOWLEDGE AND

REGISTERED SURVEYOR REG. NO.