

SITE PLAN FOR:

ERNEST FAGIN
30050 E. EUCLID
WICKLIFFE, OHIO

REVISED FOR MR. DAVID SNIDER
2663 S. RIDGE ROAD
PAINESVILLE TWP.

PREPARED BY:

WM. R. GRAY ASSOC. INC.
7547 MENTOR AVENUE
MENTOR, OHIO 44077


BEING A PARCELOF LAND 680' NORTHEAST OF
THE INTERSECTION OF SOUTH RIDGE AND MADISON
AVENUE IN LOT 20 OF PERRY TOWNSHIP, OHIO.

DATE: 1976 SCALE: 1"=30'
REVISED 11 Nov 86 - ADDED PROP HOME, GRADING @ HOME
LOCATED EXIST BLDG AS PER
MARU RUKIN SITE PLAN


CERTIFICATION:

I HEREBY CERTIFY THAT THIS PLAT IS
CORRECT TO THE BEST OF MY KNOWLEDGE.

BY: WM R GRAY REG. SURV. # 2752

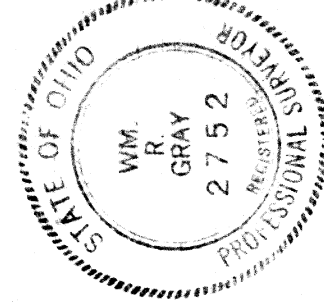

I HEREBY CERTIFY THAT THIS SITE PLAN IS A REVISION
OF A PREVIOUS TOPOGRAPHIC MAP ORIGINALLY PREPARED
BY WILLIAM R. GRAY ASSOC. FOR ERNEST FAGIN
WITH EXISTING BLDG LOCATED AS PER SITE
PLAN PREPARED BY MARU RUKIN-ARCHITECT.
PROPOSED HOME & GRADING SHOWN HAS BEEN
BEEN PREPARED BY ME UTILIZING PREVIOUS
WORK & INFORMATION PROVIDED BY CURRENT
CLIENT

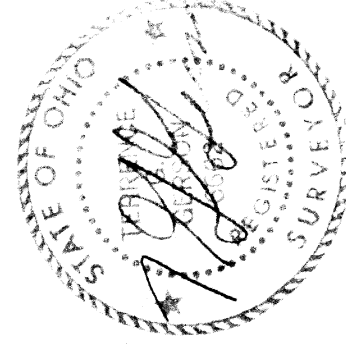

Grading Plan Approved
as shown and for record
THOMAS P. GILLES, P.E.
Lake County Engineer
BY: *[Signature]* Date 11/15/86

* T.B.M. TOP OF FIRE HYDRANT
ELEV. 100.00 (ASSUMED)

--- 86 --- EXISTING CONTOUR LINE
--- PROPOSED CONTOUR LINE

