


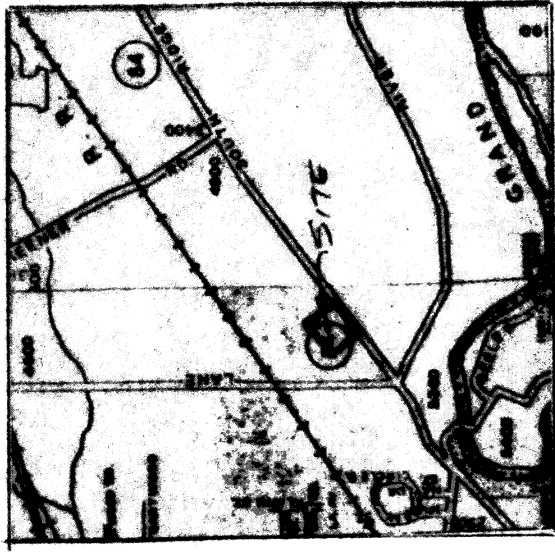

VICINITY MAP
NO SCALE

T.B.M - P.K. NALAN P.P. # 5371
Elev. - 747.00

OWNER: HEALING BIBLE CHURCH
2836 BURNS LANE
MADISON, OHIO 44057
1-216-438-6656

ENGINEER: HARRY S. JONES, PE,
BABCOCK, JONES & ASSOC. INC.,
1701 MENTOR AVE, SUITE 3
PAINEVILLE, OHIO 44077

1-246-357-1811 APPROVED

SIDE LINES & SET BACK
PERRY TOWNSHIP ZONING

PERRY TOWNSHIP ZONING
PERMIT NO. 3048

ZONING INSPECTOR *Don King*
PG. 1 OF 2

Dick Thomas & Co.


ARCHITECTS/BUILDERS
SUITE 306 54 S. STATE STREET PAINESVILLE, OHIO 44077-3423

SCALE: 1"=30'	APPROVED BY
DATE: JULY 14, 1996	

HERITAGE PIBLE CHURCH

6357 N. RIDGE RD., MADISON, OHIO 44051

THE ENLIGHTENMENT SURVEY OF DO

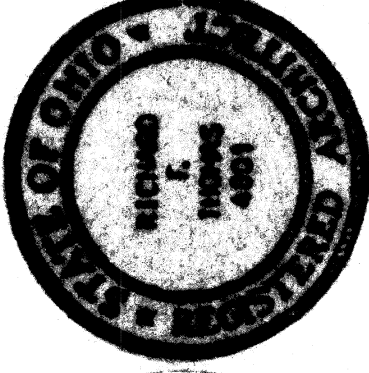

Not
Grading Plan Approved
as shown and/or noted
THOMAS W. GILLES, P.E.
Lake County Engineer

By [Signature] Date 9-26-86

SOUTH RIDGE ROAD (S.R. 84)