

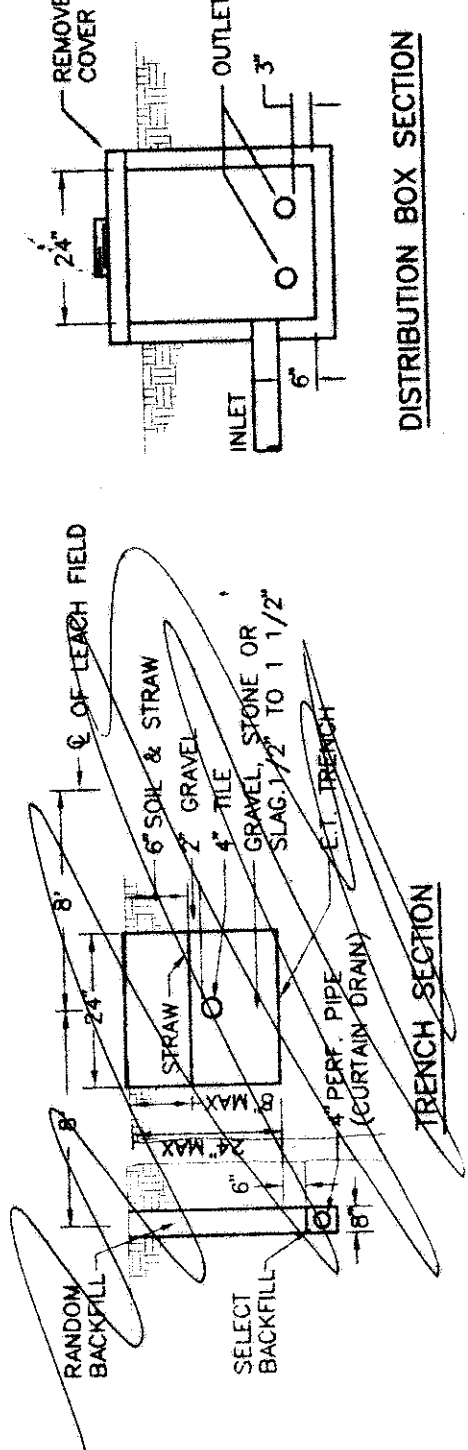


- NOTES :
- 1. CONTRACTOR SHALL VERIFY LOCATION AND DEPTH OF ALL UTILITIES PRIOR TO CONSTRUCTION.
 - 2. LAKE COUNTY HEALTH DISTRICT RULES AND STANDARDS ARE TO BE USED.

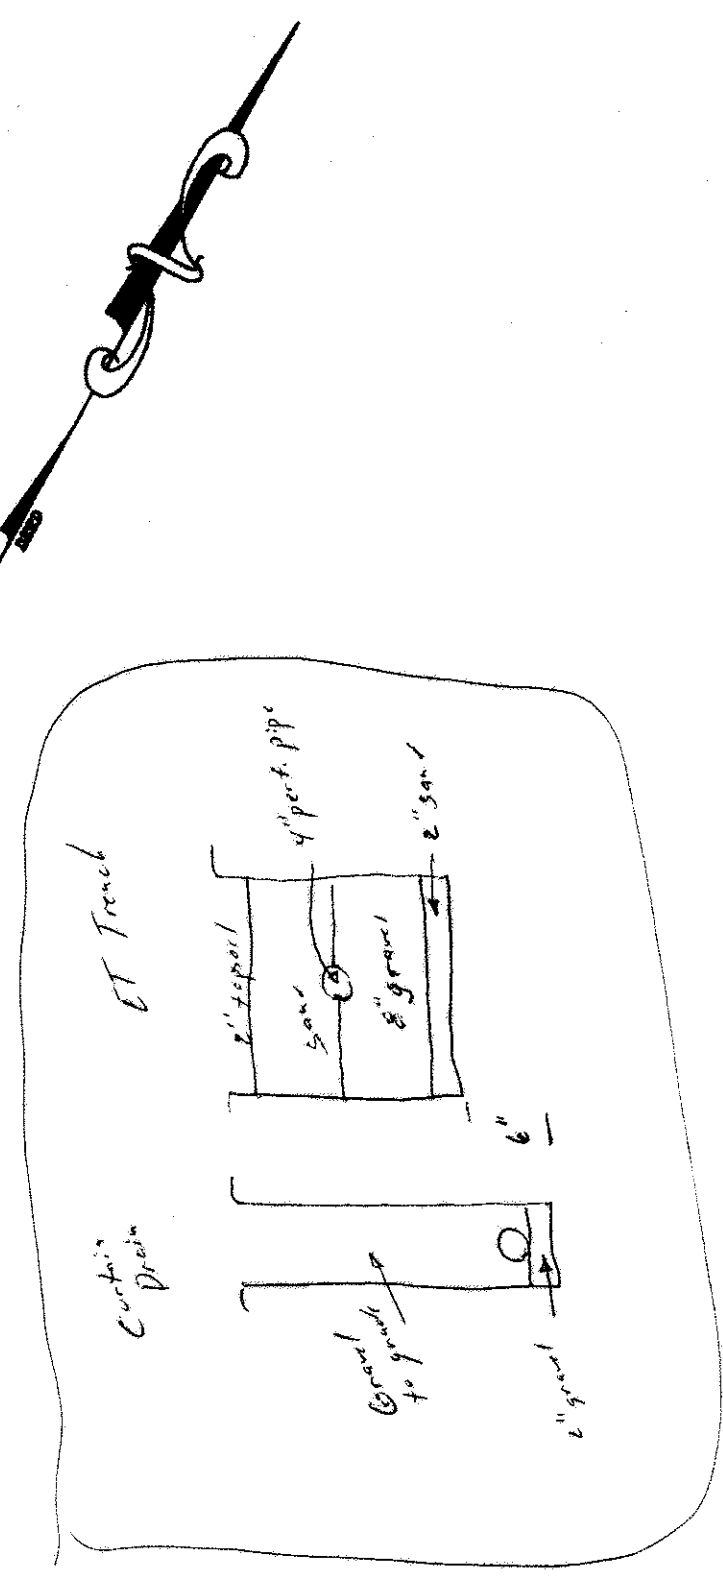

EVAPO-TRANSPARATION TILE FIELD

SOUTH RIDGE ROAD (60')

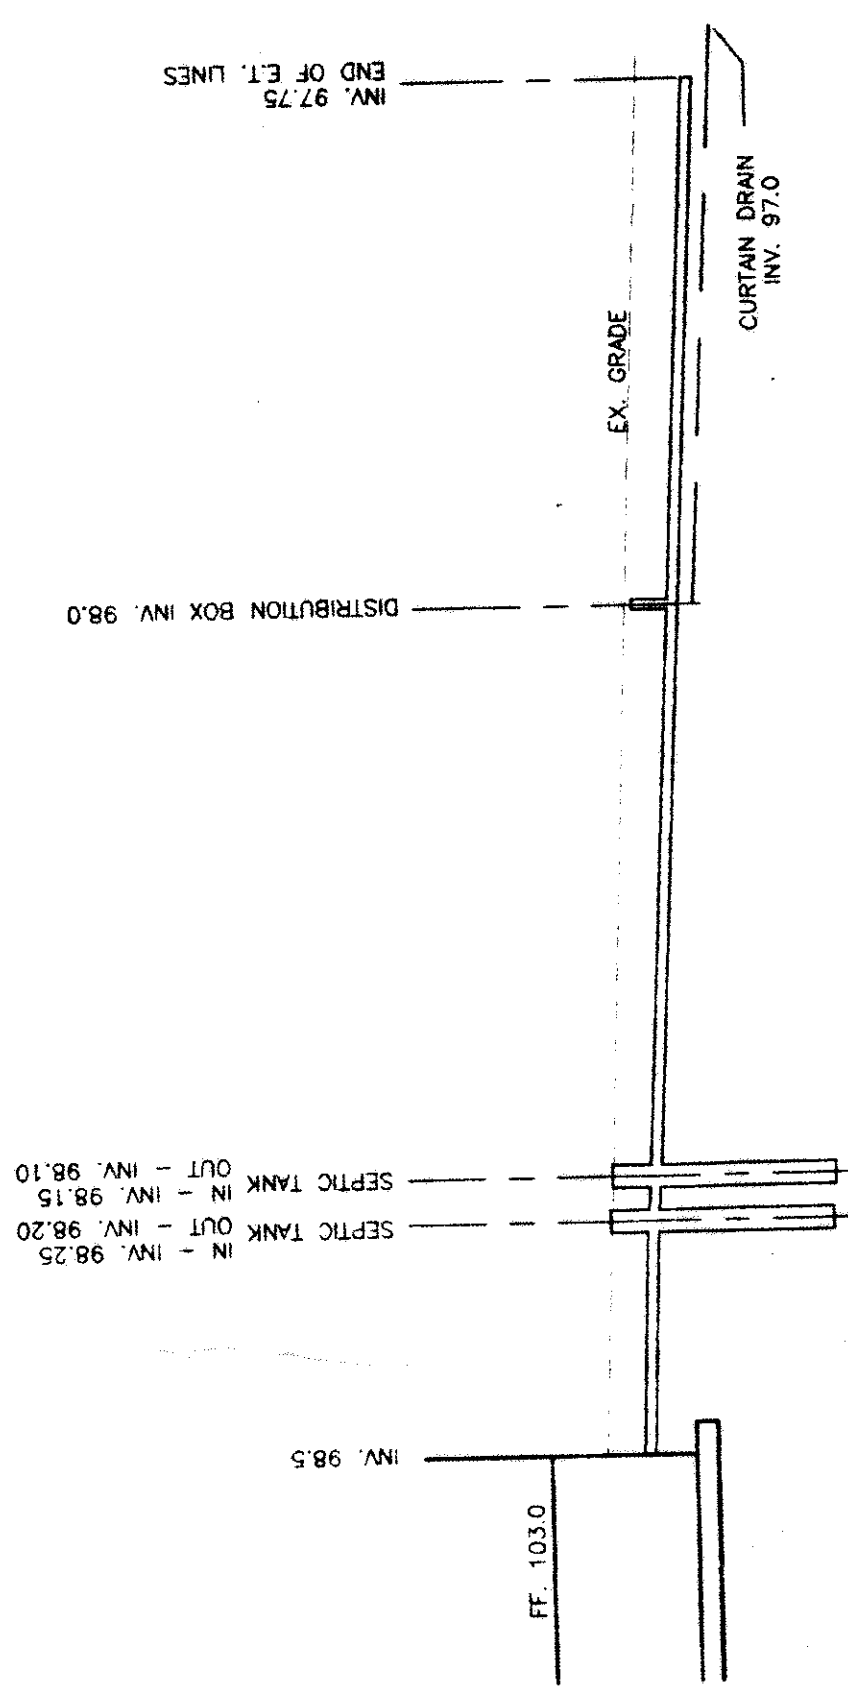

HYDRAULIC PROFILE

SCALE HORIZ. = 1" = 50'
VERT. = 1" = 5'

Reviewed and Accepted
LAKE COUNTY GENERAL HEALTH DISTRICT
Date: 6-28-95
By: [Signature]
JOE LUTZ & S. M. P. H.
Health Commissioner

APPROVED
SEWER LINES & SET BACK
PERRY TOWNSHIP ZONING
PERMIT NO. 2250
ZONING INSPECTOR

Engineering Firm Approved
LAKE COUNTY ENGINEERS, INC.
1000 N. CHILDS, P.O.
LAKE COUNTY, OHIO 43004

6/14 7-3-95
OUT Right of way
Permit is required

ROOF DRAINS
SHALL DISCHARGE
TO SPLASH BLOCKS.

SITE PLAN

LAKE COUNTY, OHIO
for: ROBERT & CHERYL ARNDT
client

subdivision name
No. 43 & 44
lot

- A. To be brought to finished grade
- 1. Septic tank manhole covers
 - 2. 2" filter bar cover
 - 3. Distribution box cover
- B. All roof drains or downspouts
to be discharged into septic tanks
- C. All waste water to be discharged into
septic tanks

LOW YIELD WATER
FIXTURES REQUIRED
ON ALL:
Shower Head
Toilet

GRAPHIC SCALE

I, the undersigned hereby certify that
this topography, indicated by 1' contours
and elevations shown hereon represents an
actual field survey made by me on April 20, 1995,
and that the elevations were taken at appropriate
intervals and that as of that date they existed
as indicated hereon.