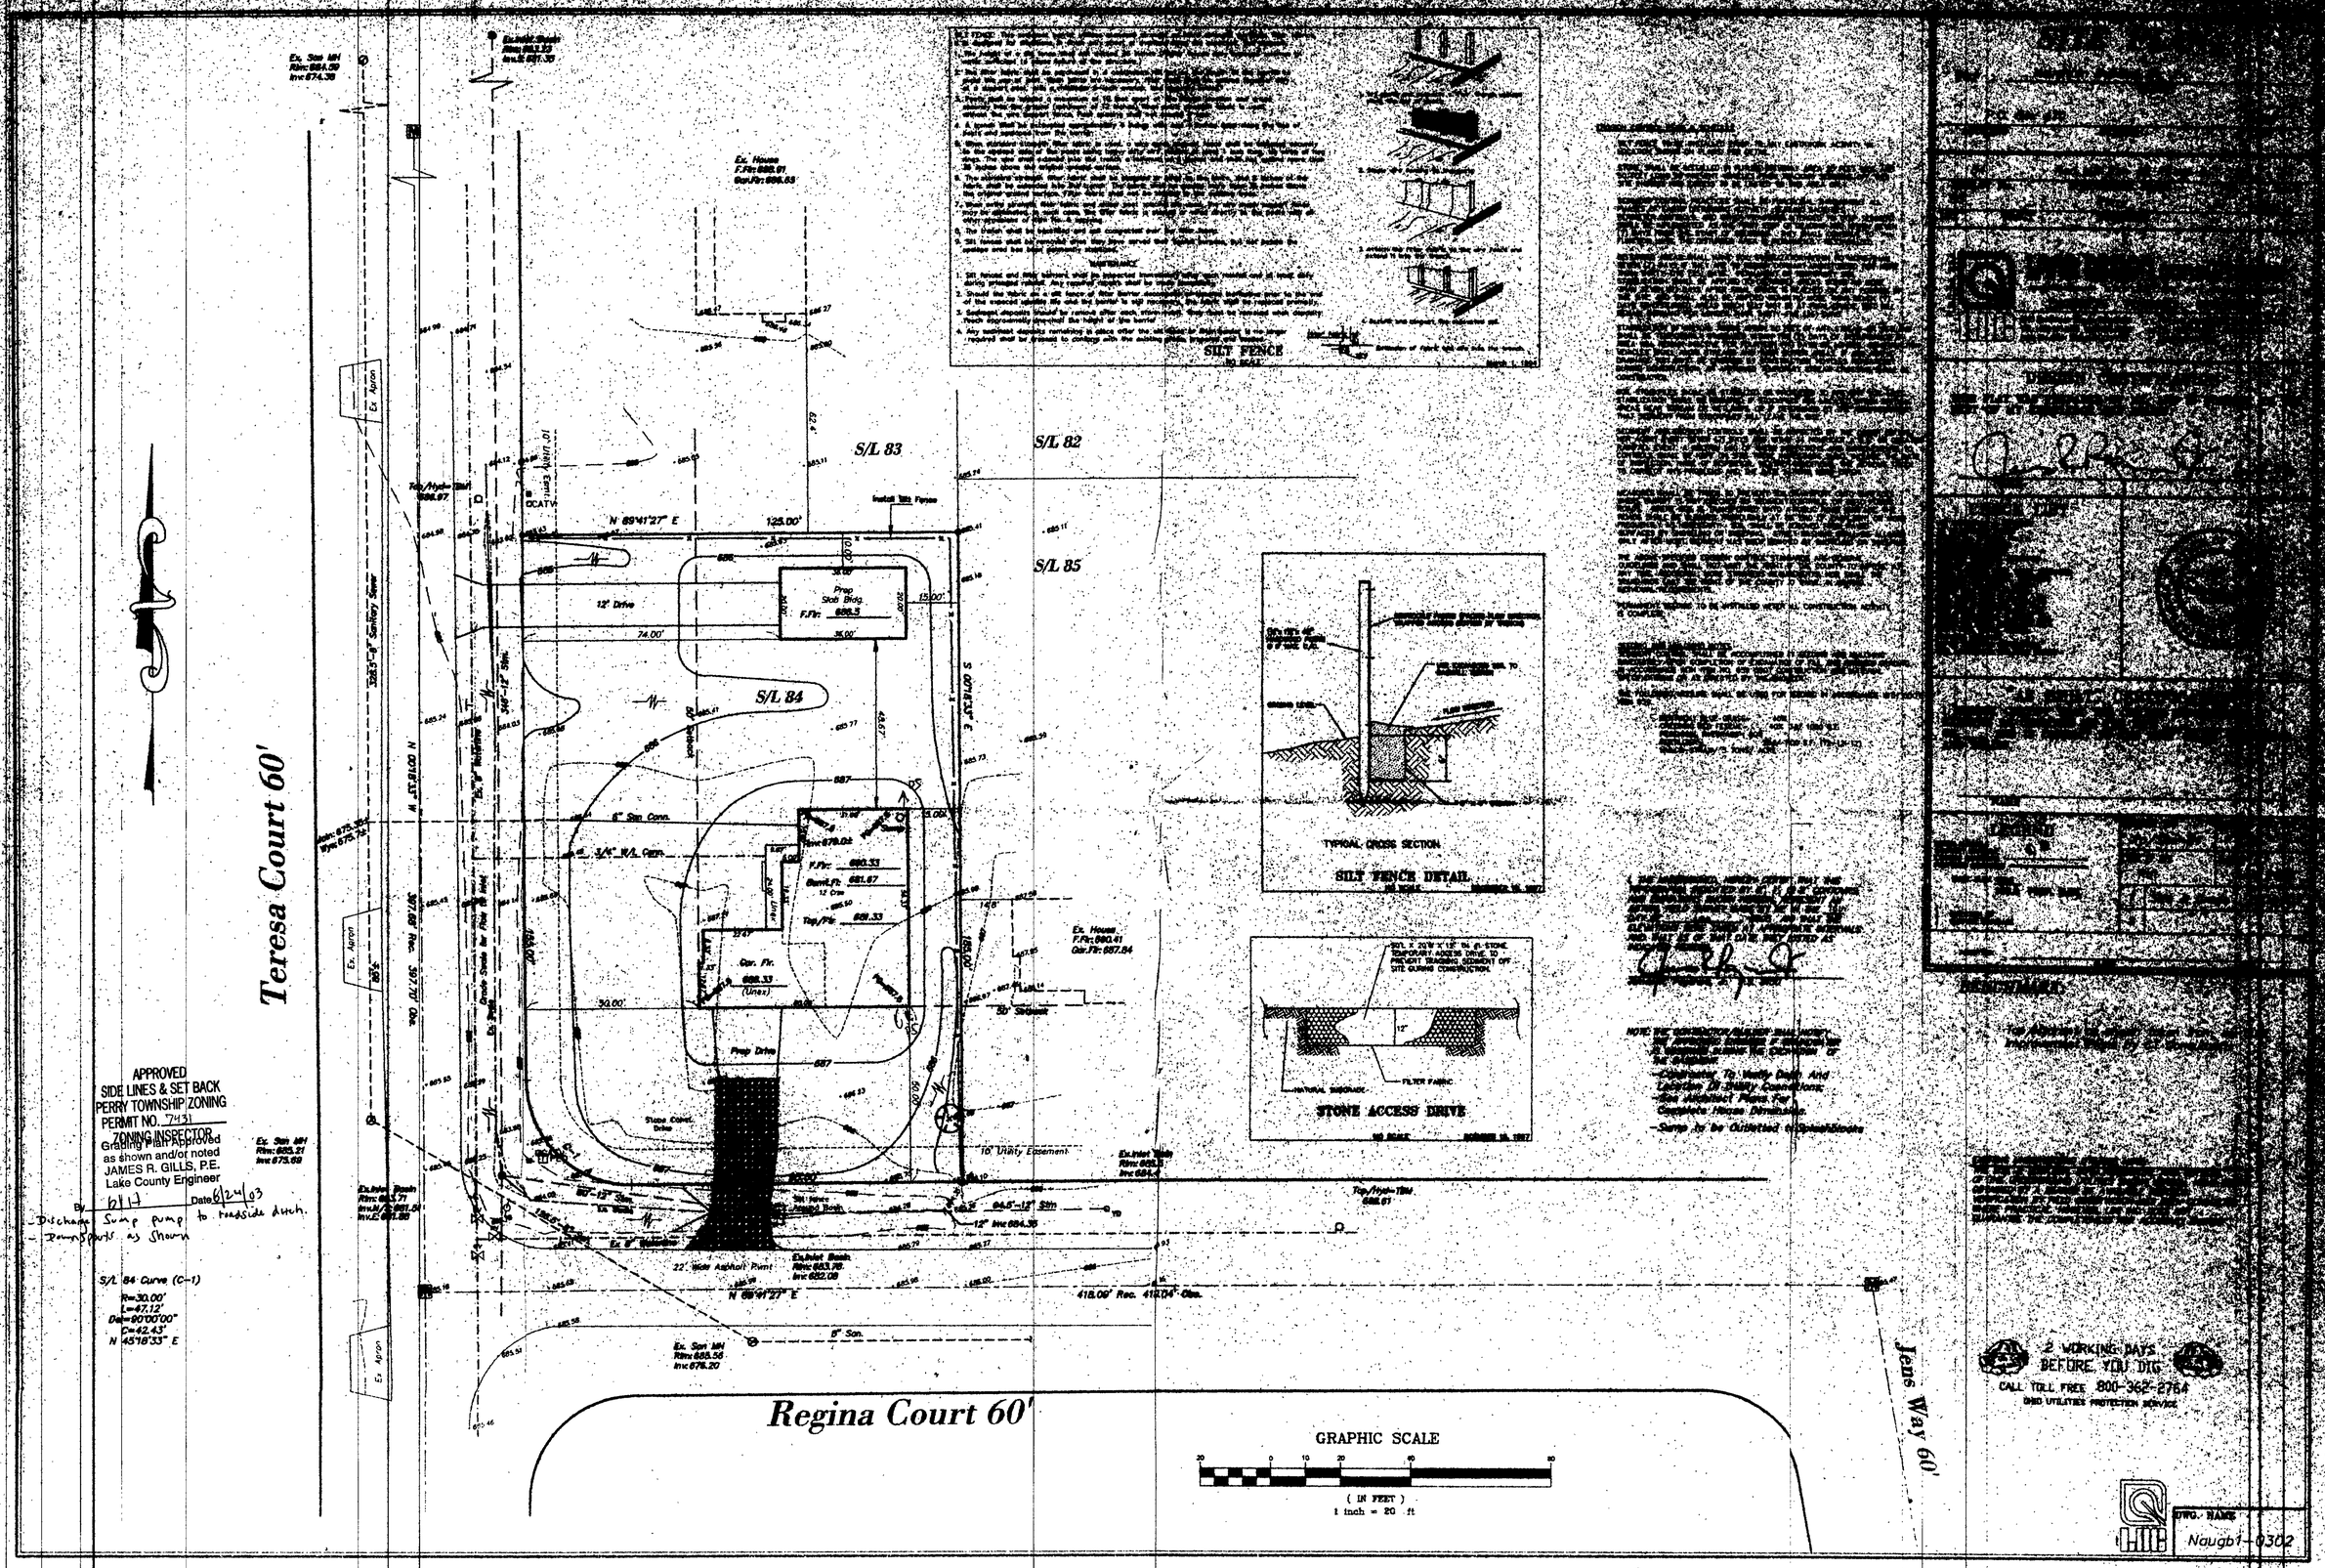

Teresa Court 60'
Regina Court 60'
Jens Way 60'
S/L 82
S/L 83
S/L 84
S/L 85
N 89°41'27" E
125.00'
12' Drive
Prop Slab Bldg.
Prop Drive
Ex. House
Ex. Apron
Ex. Sanitary Sewer
10' Utility Easement
22' Wide Asphalt Pvmt
SILT FENCE
NO SCALE
TYPICAL CROSS SECTION
SILT FENCE DETAIL
NO SCALE
STONE ACCESS DRIVE
NO SCALE
FILTER FABRIC
NATURAL SUBGRADE
APPROVED
SIDE LINES & SET BACK
PERRY TOWNSHIP ZONING
PERMIT NO. 7431
ZONING INSPECTOR
Grading Plan Approved
as shown and/or noted
JAMES R. GILLS, P.E.
Lake County Engineer
By 6/17 Date 6/24/03
- Discharge Sump pump to roadside ditch.
- Downspouts as shown
S/L 84 Curve (C-1)
R=30.00'
L=47.12'
Del=90°00'00"
C=42.43'
N 45°18'33" E
GRAPHIC SCALE
(IN FEET)
1 inch = 20 ft
2 WORKING DAYS
BEFORE YOU DIG
CALL TOLL FREE 800-362-2764
OHIO UTILITIES PROTECTION SERVICE
DWG. NAME
Naugb1-0302