

SEWAGE DISPOSAL PERMIT MUST BE OBTAINED BY A LAKE COUNTY LICENSED INSTALLER BEFORE INSTALLATION IS STARTED.

**LOW YIELD WATER
FIXTURES REQUIRED
ON ALL:
Shower Head
Toilet**

A. To be brought to finished grade

1. Septic tank manhole covers
2. Splitter box cover
3. Distribution box cover

B. No footer drains or downspouts to be discharged into septic tanks

1. All waste water to be discharged into septic tanks

Reviewed and Accepted _____
LAKE COUNTY GENERAL HEALTH DISTRICT
Date 3-24-95 May need a life
JOEL LUCIA, R. S., M. P. H.
Health Commissioner
BY J. Lucia

System is in accordance with overall on-site sewage disposal system plan.

System is different than shown on overall on-site

Reviewed by: Chun-Li Date: 3/22/95
BY Consultants, Inc.



"I, the undersigned hereby certify that the topography indicated by 6", 1" or 2" contours, and elevations shown here represent an actual field survey made by me on the 14th day of June, 1992, and that the elevations were taken at appropriate intervals and that as of that date, there existed as indicated hereon."

Doc No

SCALE 1" = 20'

JOB NO	99-243-02
SHEET	1
OF	1

S/L 2 TURNBURY SUBDIVISION
VOL. 20 - PG. 33 LAKE COUNTY PLATS
PERRY TOWNSHIP LAKE COUNTY OHIO


DATE MARCH 1995
DESIGN BY [Signature]
DRAWN BY [Signature]
APPROVED BY [Signature]

babcock, jones and associates, inc.
CIVIL ENGINEERS - SURVEYORS - LAND PLANNERS
PAINESVILLE OHIO 44077

SITE PLAN
FOR
RICK DOWNING

REV NO.	DESCRIPTION	DATE	BY	CHK'D
1	REVISE GUETAIN DRAIN	3/22/95	JS	

HYDRAULIC PROFILE

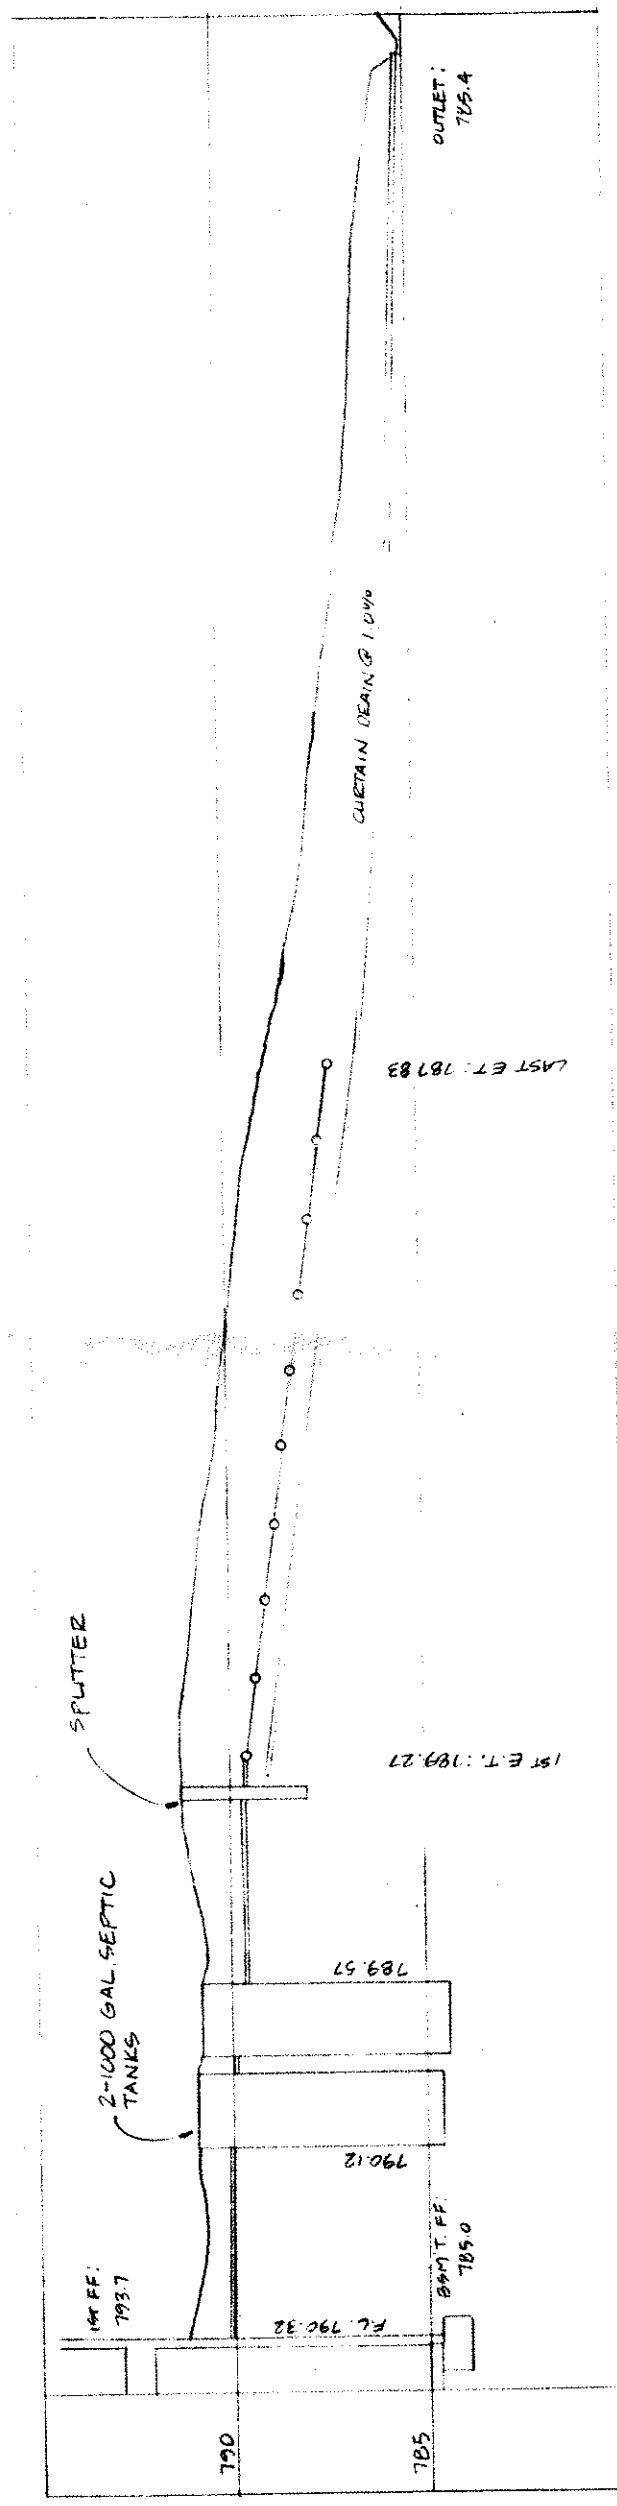

ROOF DRAINS
SHALL DISCHARGE
TO SPLASH BLOCKS.

6/11/11 10:32:25

