



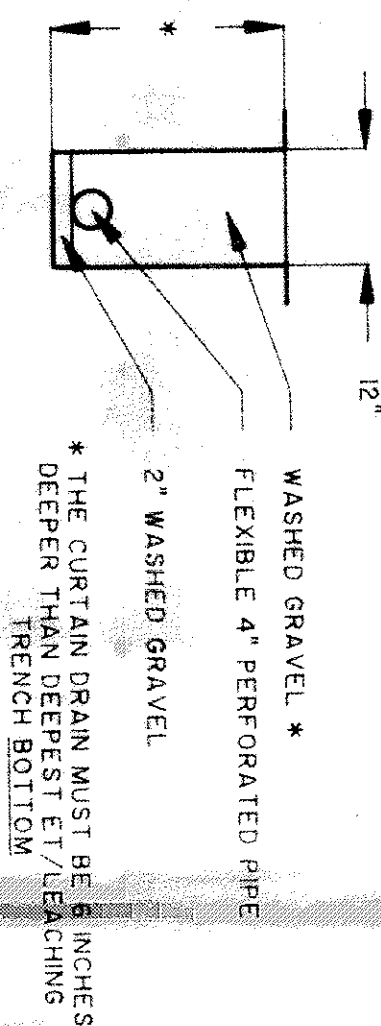


TYPICAL CURTAIN DRAIN CROSS SECTION

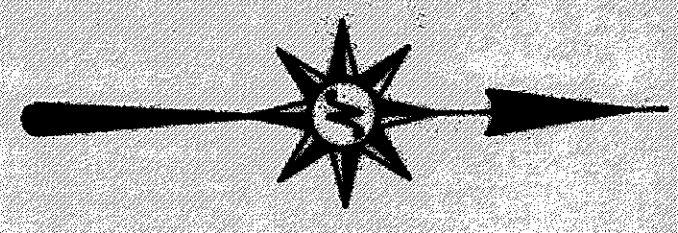

- EXISTING CONTOUR
PROPOSED CONTOUR
- EXISTING ELEVATION
PROPOSED ELEVATION

"I, THE UNDERSIGNED HEREBY CERTIFY THAT THIS TOPOGRAPHY INDICATED BY THE CONTOURS AND ELEVATIONS SHOWN HEREON REPRESENTS AN ACTUAL SURVEY MADE BY ME ON THE 25th DAY OF SEPT., 1966 AND THE ELEVATIONS WERE TAKEN AT APPROPRIATE INTERVALS AND AS OF THAT DAY THEY EXISTED AS INDICATED HEREON.

DAVID W. NOVAK, P.S. No. 7507

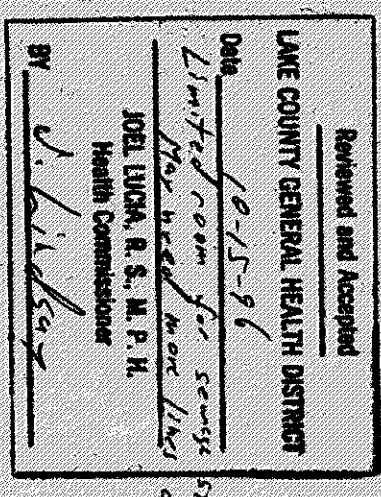

To be brought to finished stage:
 1. Septic pump manhole covers
 2. Slatford box cover
 3. Distribution box covers
 All waste water to be discharged into
 septic tanks

ON ALL
 shower heads
 Toilet

GRAPHIC SCALE


EX. 36. CMP-



Grading Plan Approved
as shown and/or noted
THOMAS P. GILLES, P.E.
Lake County Engineer

By 654 Date 11/1

$$\left(\frac{\text{IN}}{\text{FT}} \right)$$

$$1 \text{ inch} = 30 \text{ ft.}$$

8663 Tyler Boulevard
Mentor, Ohio 44060-4846 729 ac.
(216) 974-7670, (216) 255-5900 FAX.

37222 PARK AVE. WILLOUGHBY, OH 44094

SUBLOT NO. 105, TURNEY ROAD, LEROY

DAVID
W.
NOVAK
S-7507

STATE OF OHIO

REGISTERED
PROFESSIONAL ENGINEER

SITE PLAN SUBLOT NO. 105, TURNER ROAD, LEROY	
SCALES:	
HORIZ. = 1" = 30'	
VERT. = 1" = 5'	
CONTRACT No.	
96081	
SHEET No.	OF
1	1

SHEET NO.		OF	
96081			
CONTRACT NO.			
VERT.: 1" = 3'			
HORZ.: 1" = 30'			