
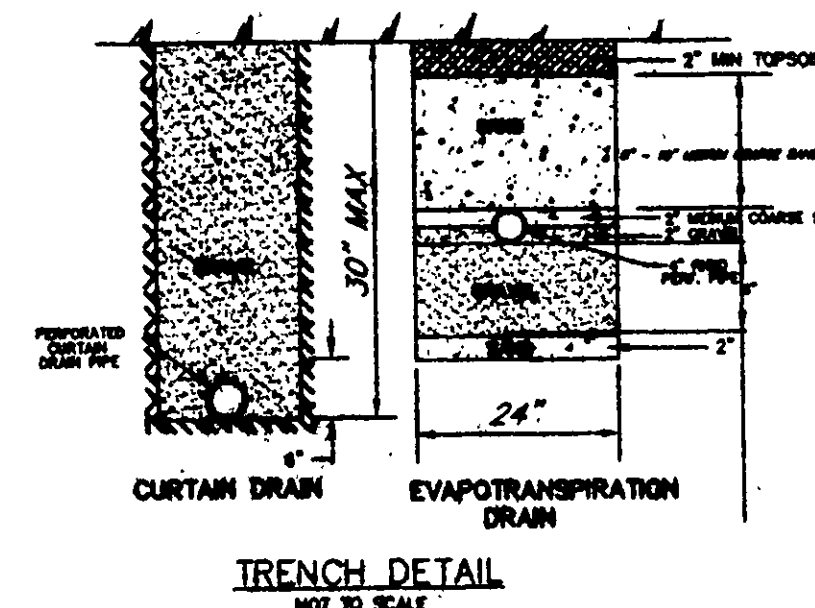


APPROVED
MADISON TOWNSHIP ZONING
DATE 8/20/99
BY 16373

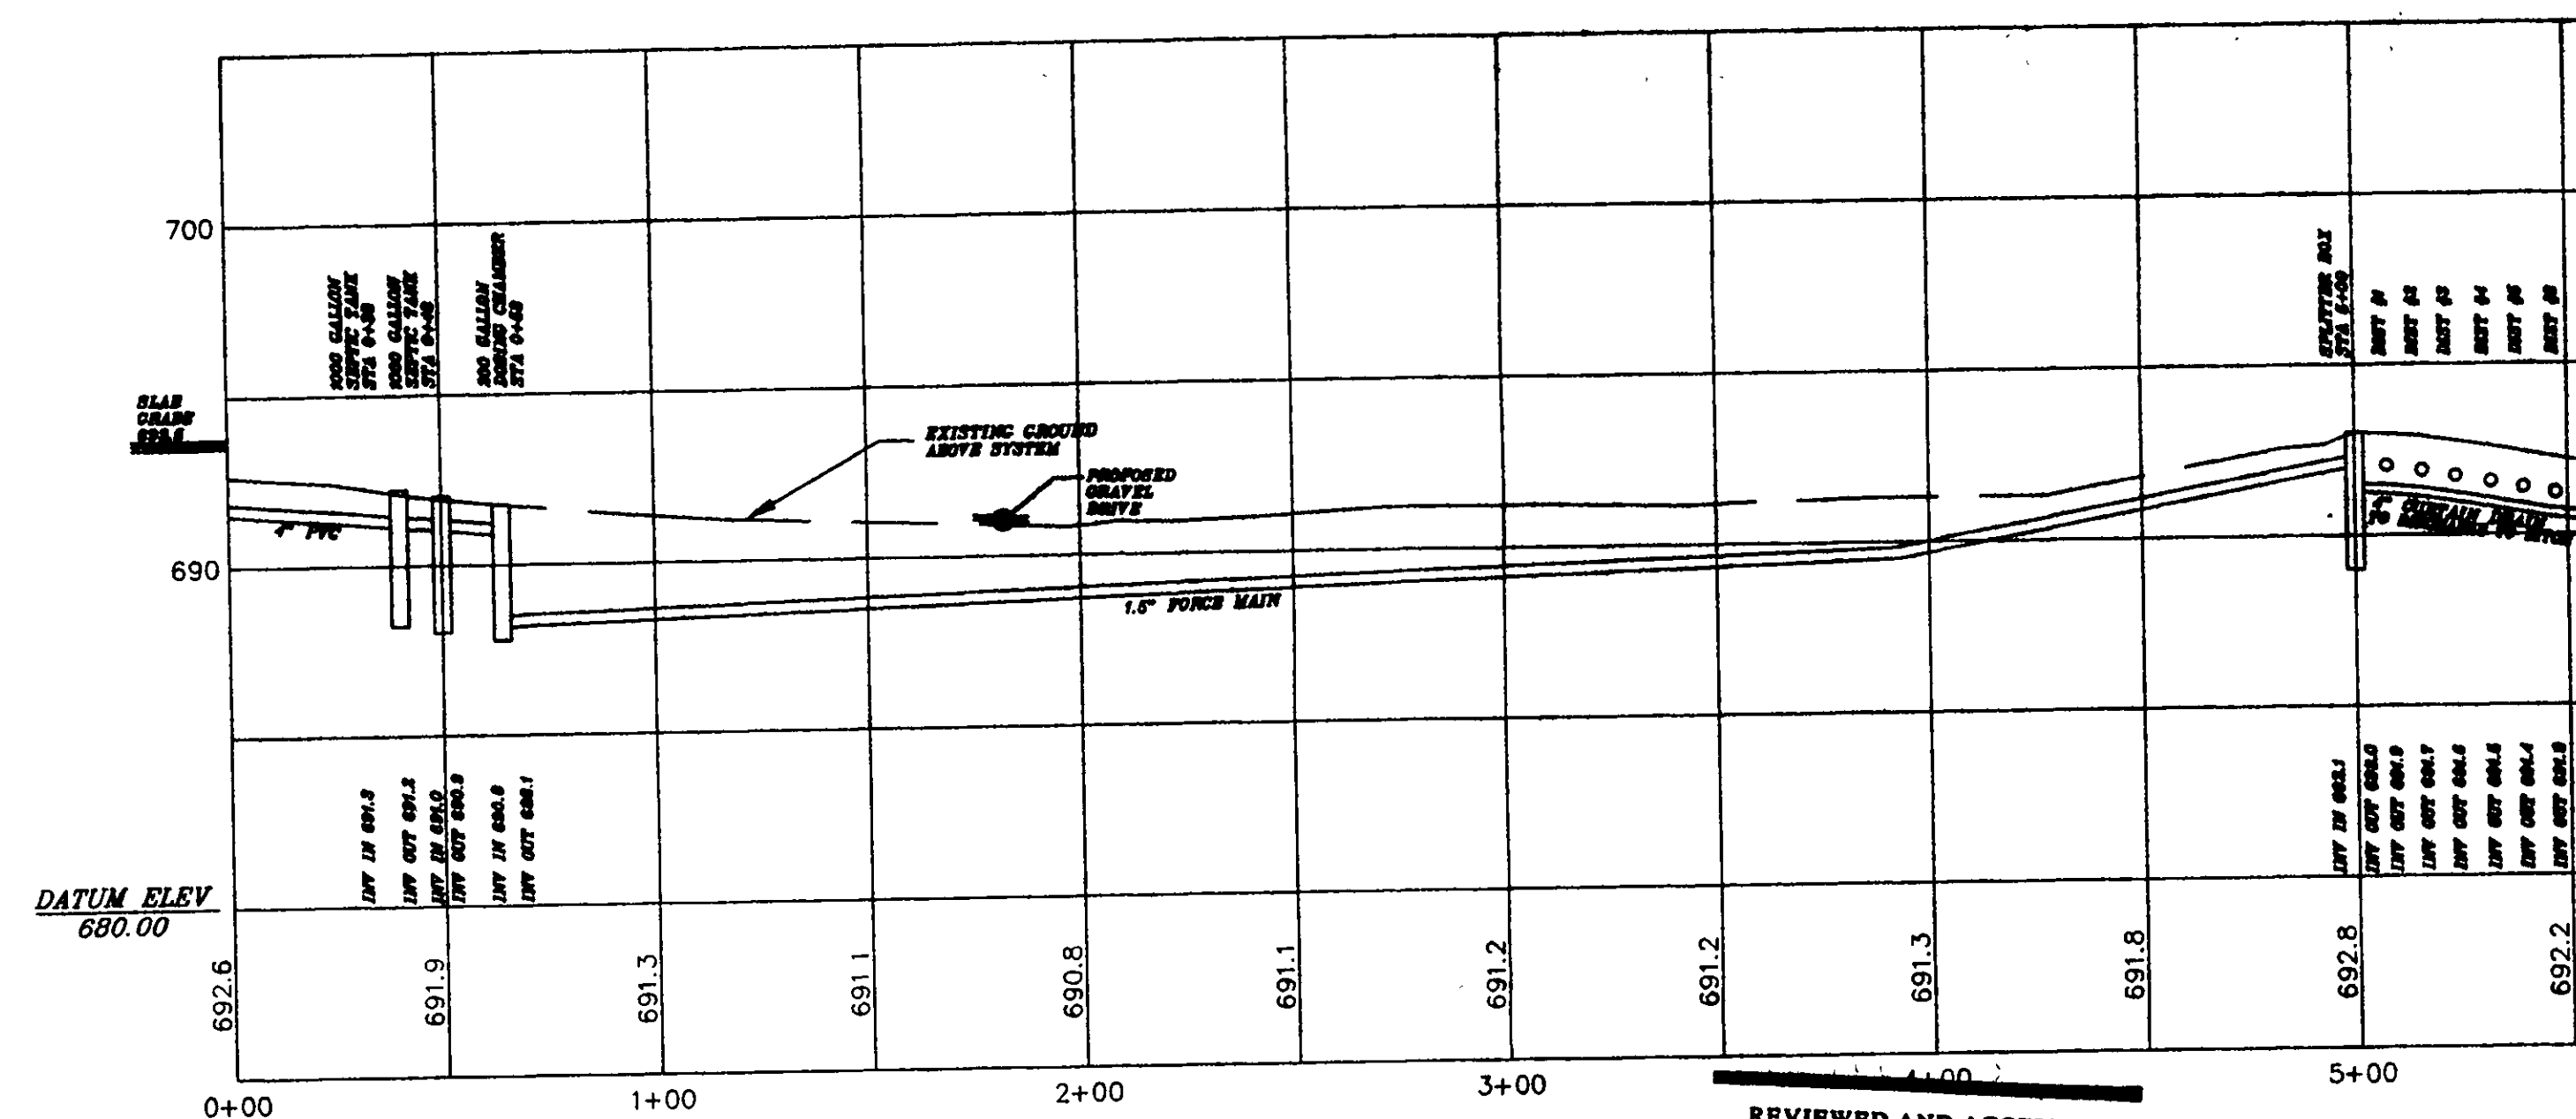

9c R-21
8-13-90

[illegible]


4 MIDDLE RIDGE Rd

SEPTIC PROFILE
HORIZONTAL SCALE: 1" = 40'
VERTICAL SCALE: 1" = 5'

REVIEWED AND ACCEPTED
LAKE COUNTY GENERAL
HEALTH DISTRICT

Date 8-17-99 BY Mark B. Brown


SEWAGE DISPOSAL PERMIT MUST BE OBTAINED BY A LAKE COUNTY LICENSED INSTALLER BEFORE INSTALLATION IS STARTED.

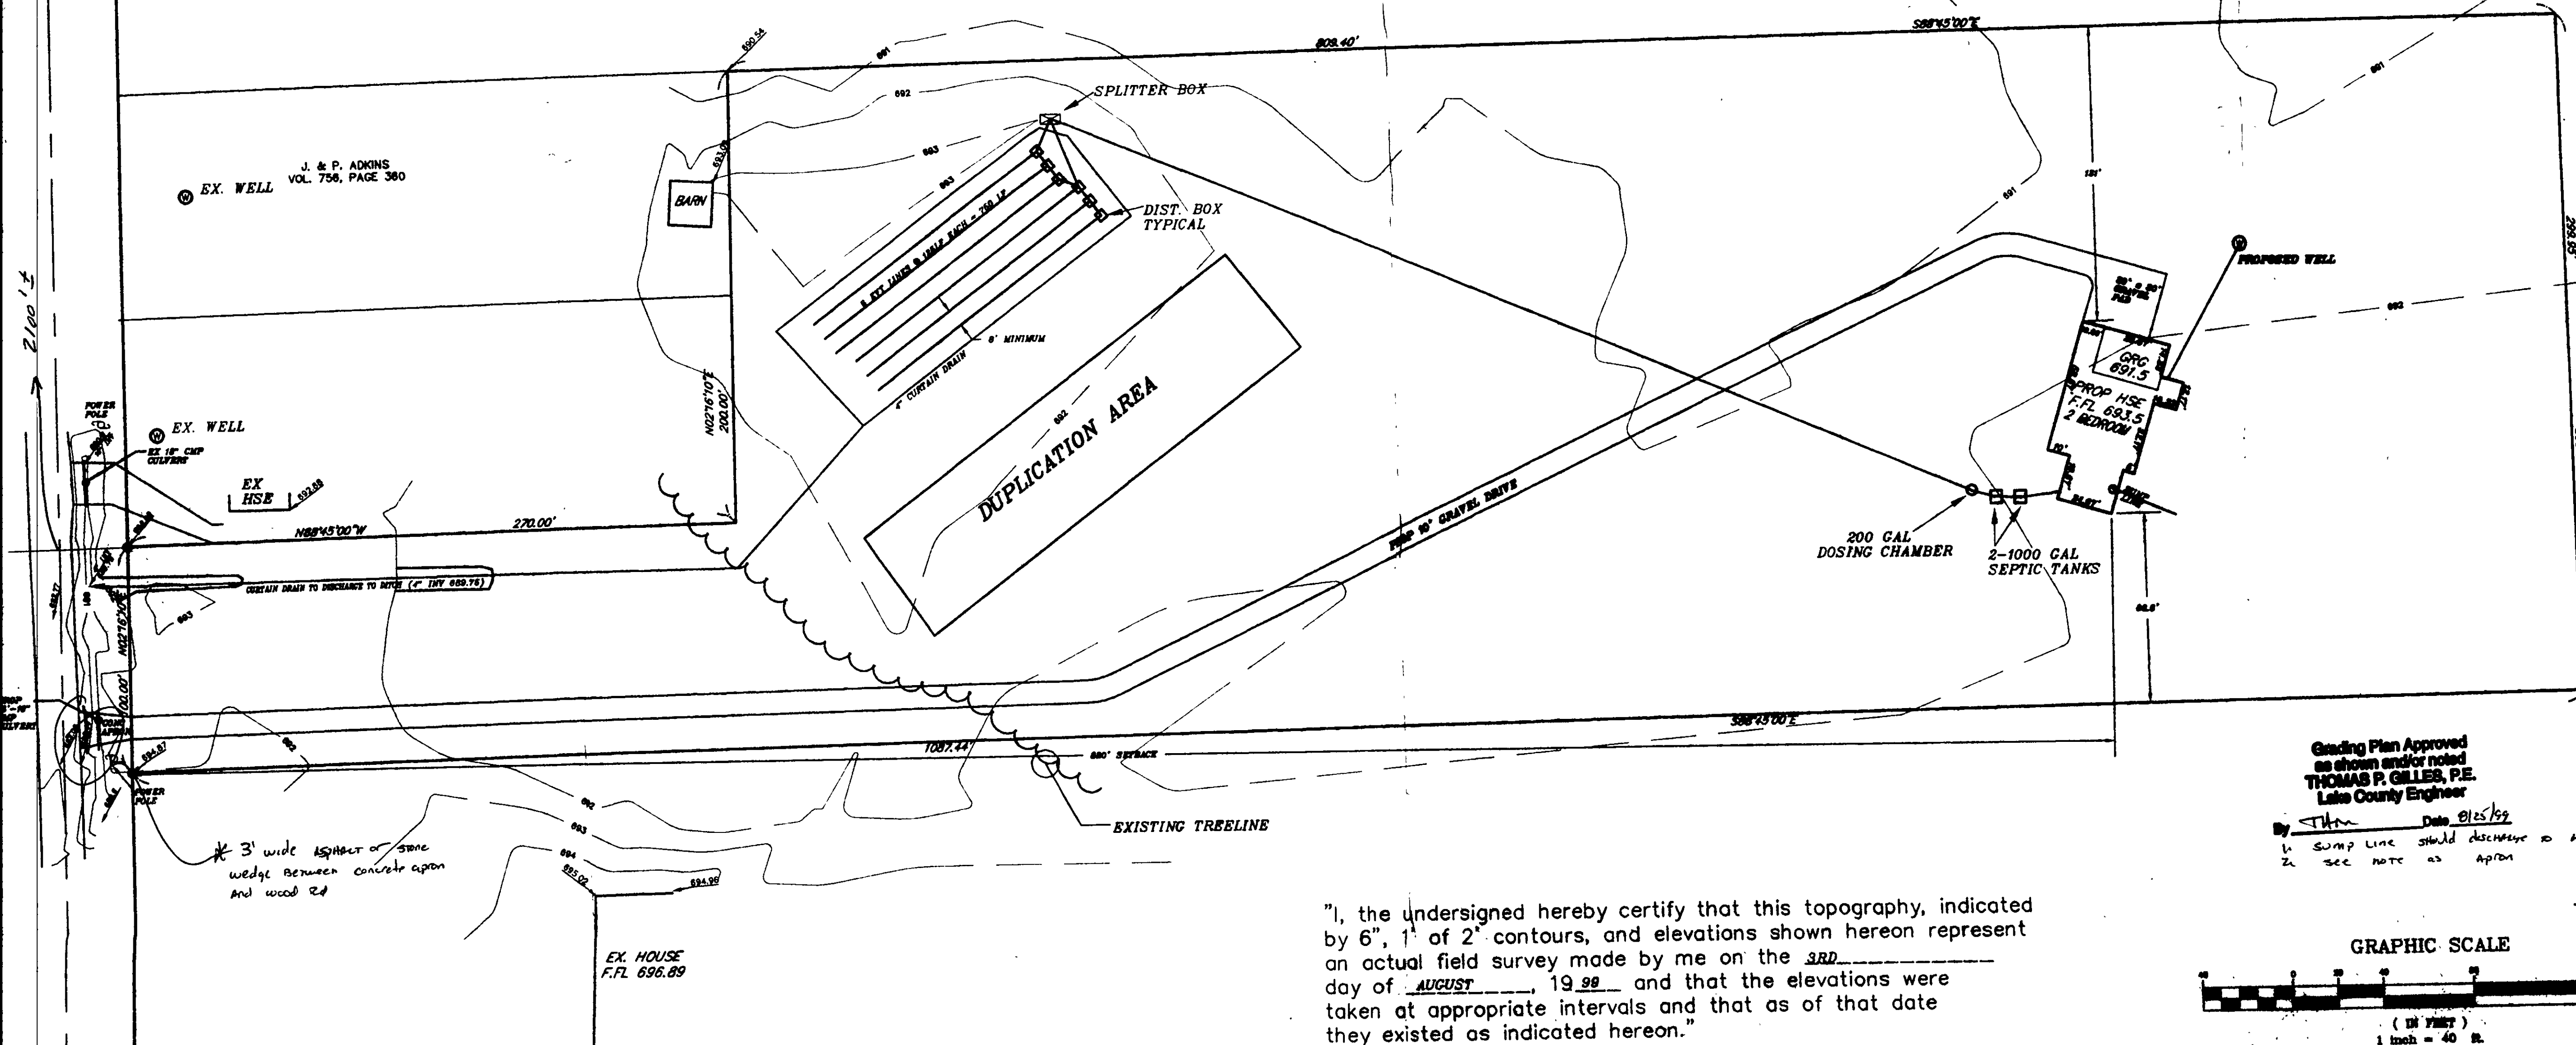

**Grading Plan Approved
as shown and/or noted
THOMAS P. GILLES, P.E.
Lake County Engineer**

By Thm Date 01/25/99
1. Sump line should discharge to a water
2. see note as apron

GRAPHIC SCALE

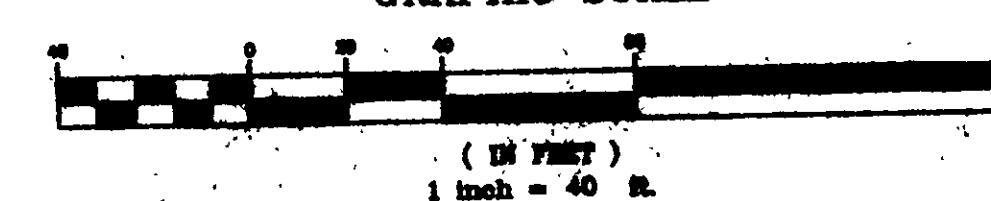

"I, the undersigned hereby certify that this topography, indicated by 6", 1" of 2" contours, and elevations shown hereon represent an actual field survey made by me on the 3RD day of AUGUST, 1999 and that the elevations were taken at appropriate intervals and that as of that date they existed as indicated hereon."

St. R. R.
Name

P.E # 63332
Reg#

SITE PLAN FOR:

SCOTT ANGUS
WOOD ROAD
TOWNSHIP OF MADISON
LAKE COUNTY, OHIO

CALL 1-800-875-5263 FOR MORE INFORMATION

440-639-9850

5

STANDARD

ENT. 304E

DATE: 8/9/99

AZT-639