


SITE PLAN

VILLAGE OF PERRY, LAKE COUNTY, OHIO
FOR: LYDIA ERKKILA AND THOMAS H. ERKKILA

OWNER ADDRESS


DEED BOOK 55 PAGE 242

PERM PARCEL 4A-44D-39 STREET GREEN

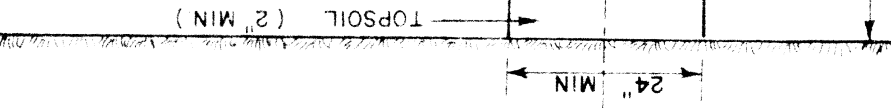

Grading Plan Approved
as shown and/or noted
THOMAS P. GILES, P.E.
Lake County Engineer

Date 5.8.87

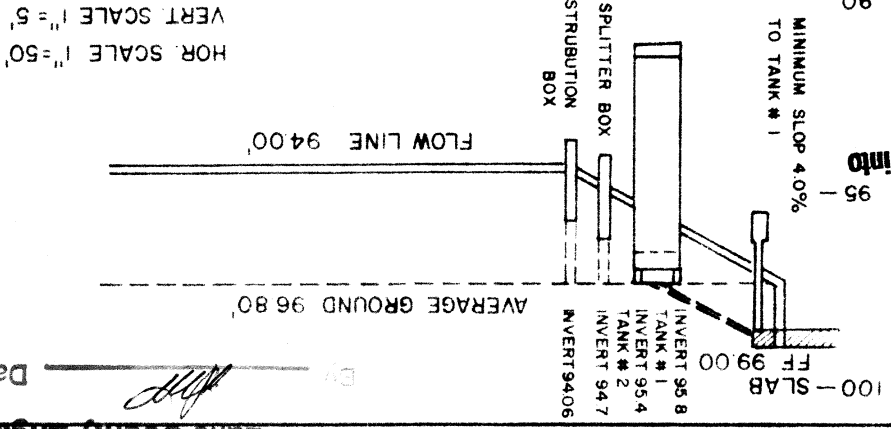

REMARKS
ALL BOUNDARY DATA SHOWN WAS OBTAINED FROM (DEEDS, RECORDED
DIVISION PLAT OR OTHER PUBLIC RECORDS)
DESIGN CERTIFICATION
THIS PLAT WAS PREPARED BY ME, AND
IS CORRECT TO THE BEST OF MY
KNOWLEDGE AND BELIEF
SURVEYOR
DOUGLAS P. McLAUGHLIN
STATE OF OHIO
REGISTRATION NO. 6688

Reviewed and Accepted
LAKE COUNTY GENERAL HEALTH DISTRICT
5-8-87
JULIE LUCIA, R.S., M.P.H.
Health Commissioner
BY: [Signature]
SEWAGE DISPOSAL PERMIT MUST BE
OBTAINED BY A LAKE COUNTY LICENSED
INSTALLER BEFORE INSTALLATION IS
STARTED.


3.0' MAX
6\"/>

1. Septic tank manhole covers
To be brought to finished grade
2. Splitter box cover
3. Distribution box cover
4. Vent Pipes
5. No 100' or drains or downspouts
to be discharged into septic tanks
6. All waste water to be discharged into
septic tanks

LOW YIELD WATER
FIXTURES REQUIRED
ON ALL:
Shower Head
Toilet

EXISTING DITCH

GREEN ROAD 60'

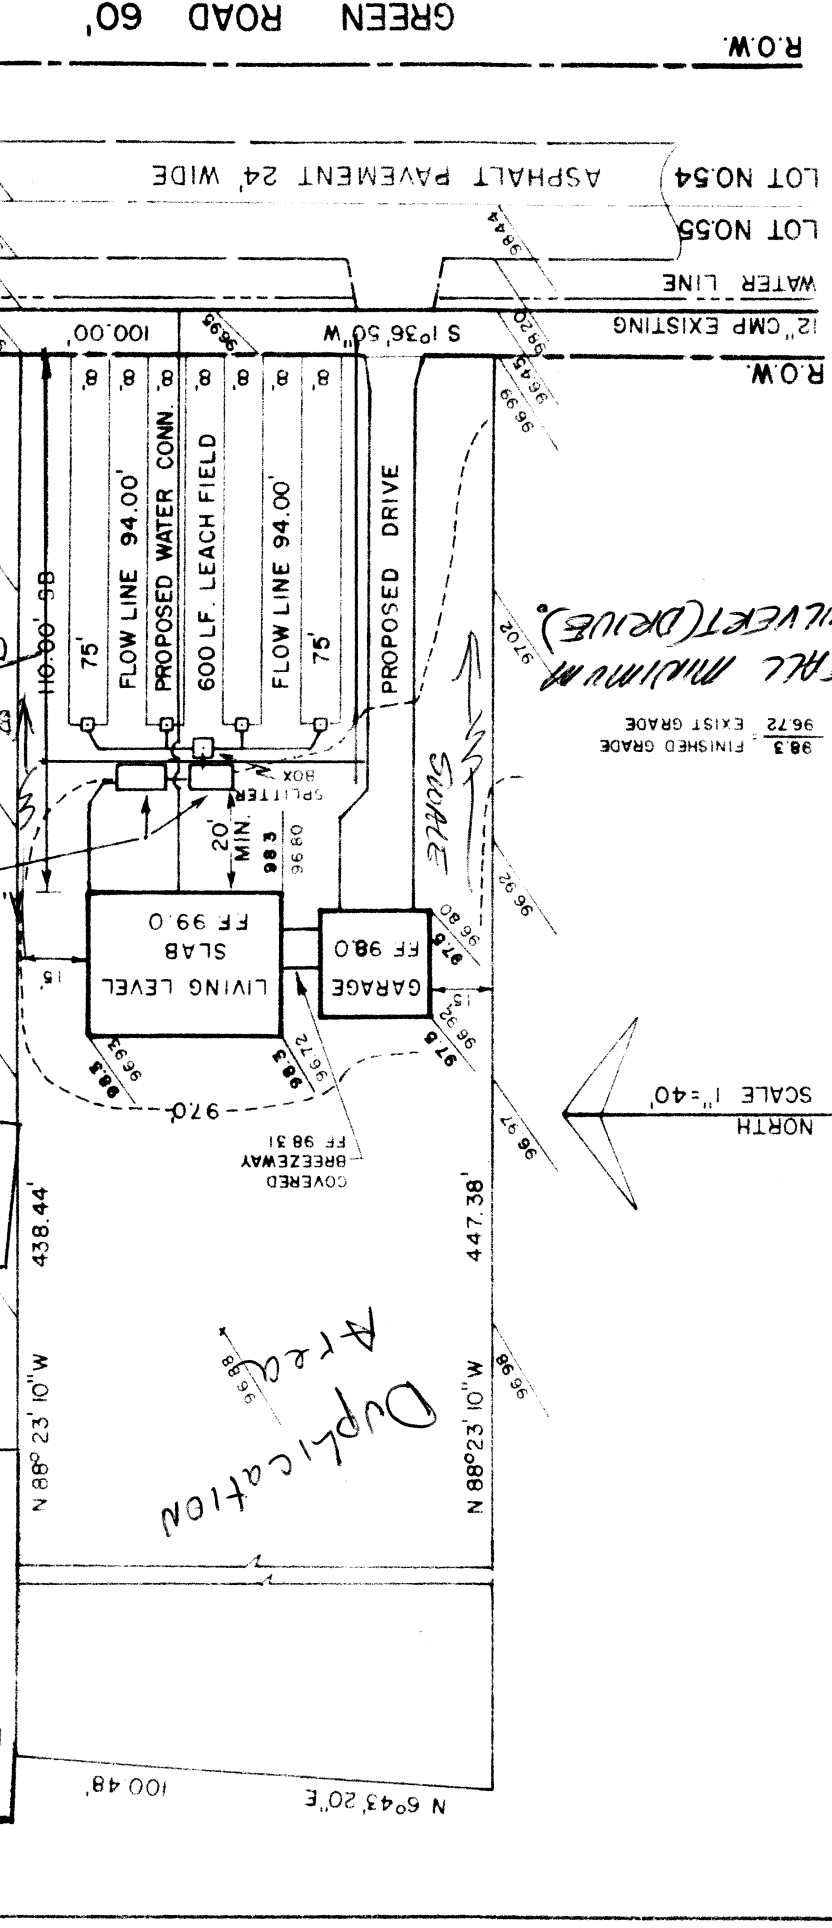

Duplication
Area

Note: 12\"/>

98.3 FINISHED GRADE
96.72 EXIST GRADE