

NOTE:
AN ALTERNATE SOURCE OF
POWER SHALL BE PROVIDED
FOR THE SUMP PUMP ON ALL
UNITS THAT REQUIRE SUMP
PUMPS

I HEREBY CERTIFY THAT THE CIRCLED
INFORMATION IS EXISTING AS OBTAINED ON
THE SITE _____ AND IS
CORRECT TO THE BEST OF MY KNOWLEDGE
AND BELIEF.


DATE _____ NAME _____

SEE IMPROVEMENT PLANS FOR THE LANDING
AT DUGAN'S FARM CONDO, PHASE 3, FOR
EROSION CONTROL AND GRADING ITEMS.


DRIVEWAYS SHALL BE 6" THICK AND HAVE
3' FLARES ON EACH SIDE.

APPROVED
☒ AS NOTED
☐ AS SUBMITTED
☒ NOT APPROVE


000.00 = SPOT ELEVATIONS

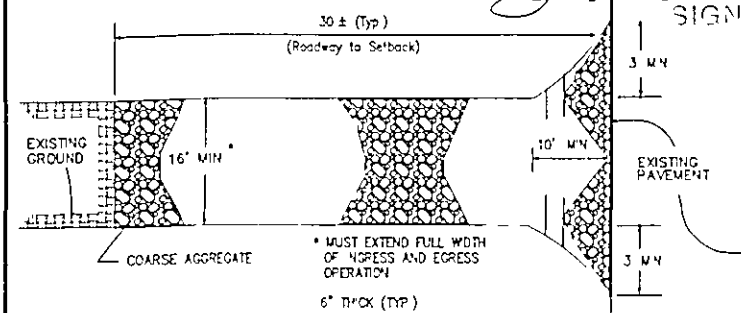

NO SCALE

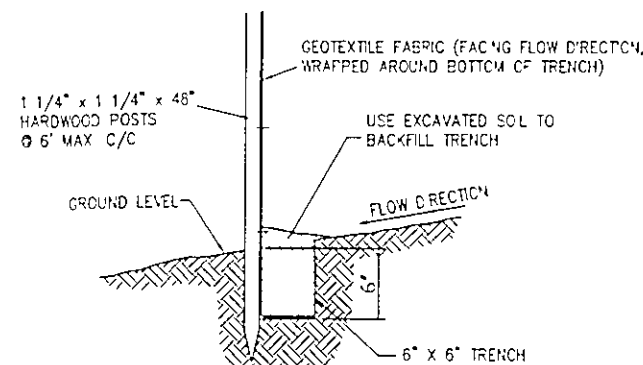

SILT FENCE
TYPICAL CROSS SECTION

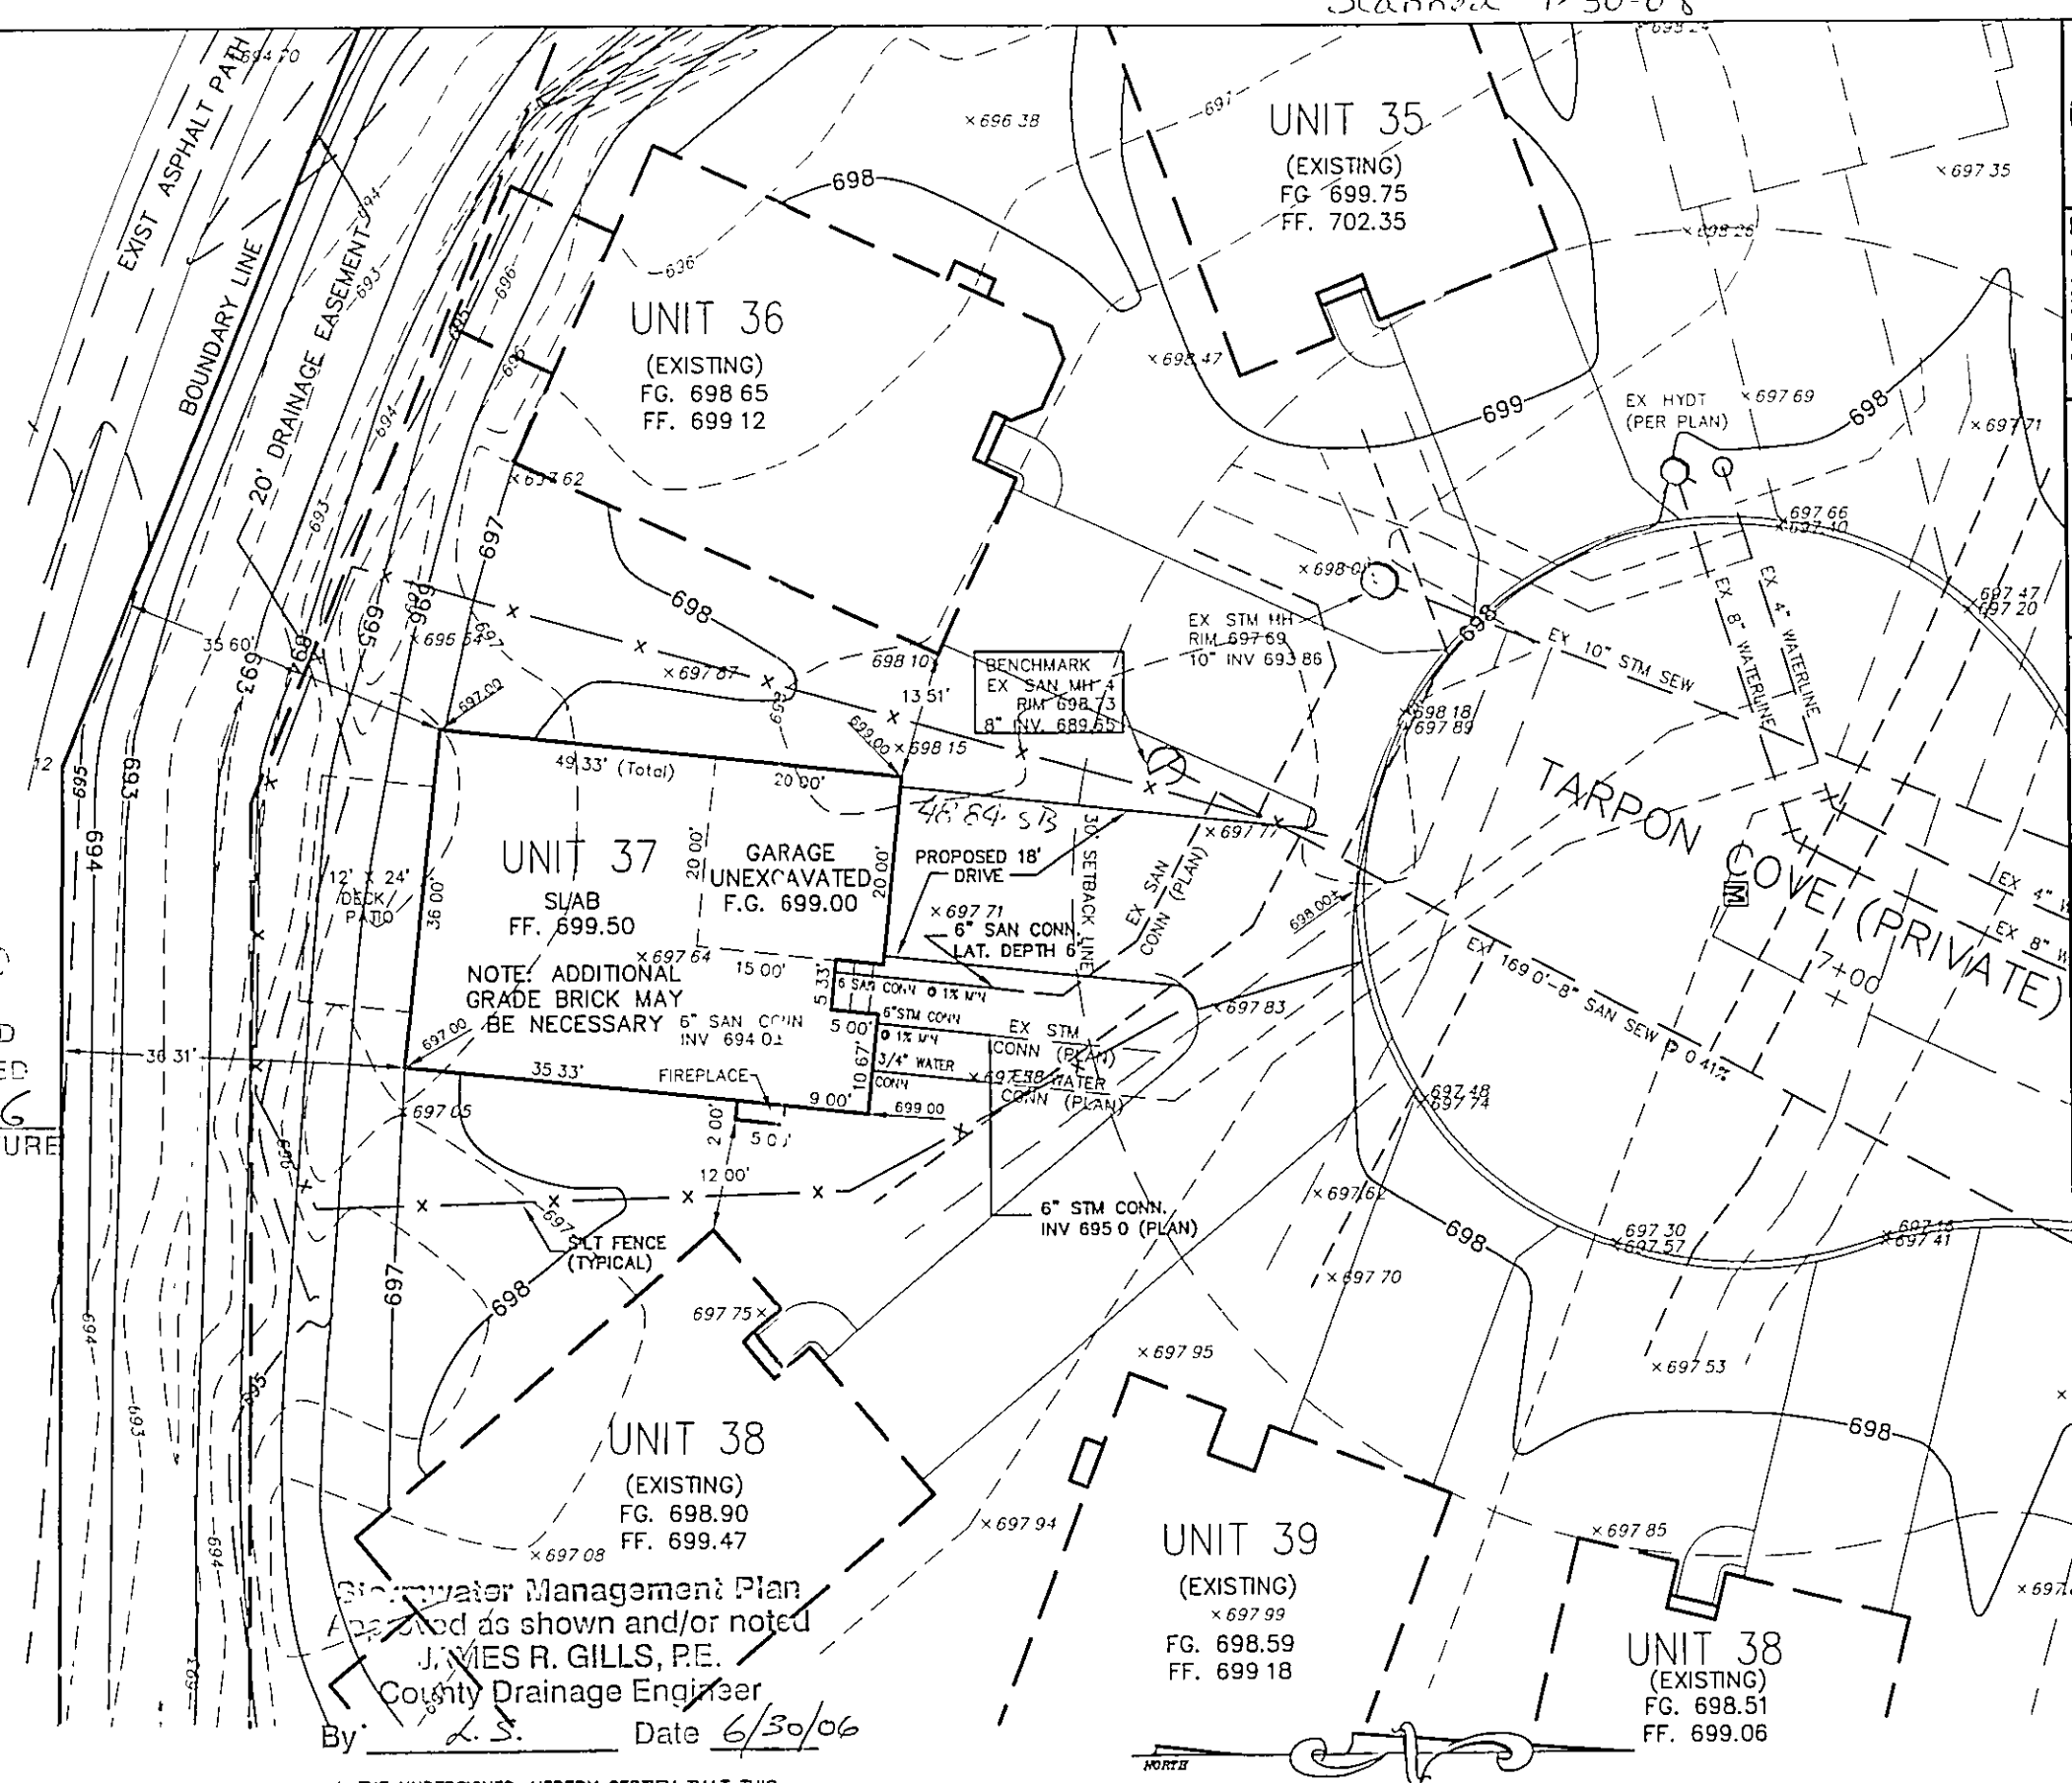

DUSTIN R. KEENEY, P.E. # 65515

OHIO UTILITIES PROTECTION SERVICE
NON-MEMBERS MUST BE CALLED DIRECT

EXISTING UNDERGROUND UTILITIES NOTE:
THE SIZE AND LOCATION, BOTH HORIZONTAL AND VERTICAL OF THE UNDERGROUND UTILITIES SHOWN HEREON, HAVE BEEN OBTAINED BY A SEARCH OF AVAILABLE RECORDS. VERIFICATION BY FIELD OBSERVATION HAS BEEN CONDUCTED WHERE PRACTICAL. HOWEVER, POLARIS ENGINEERING & SURVEYING, INC. DOES NOT GUARANTEE THE COMPLETENESS NOR ACCURACY THEREOF.

