


3/4 40
Vacant

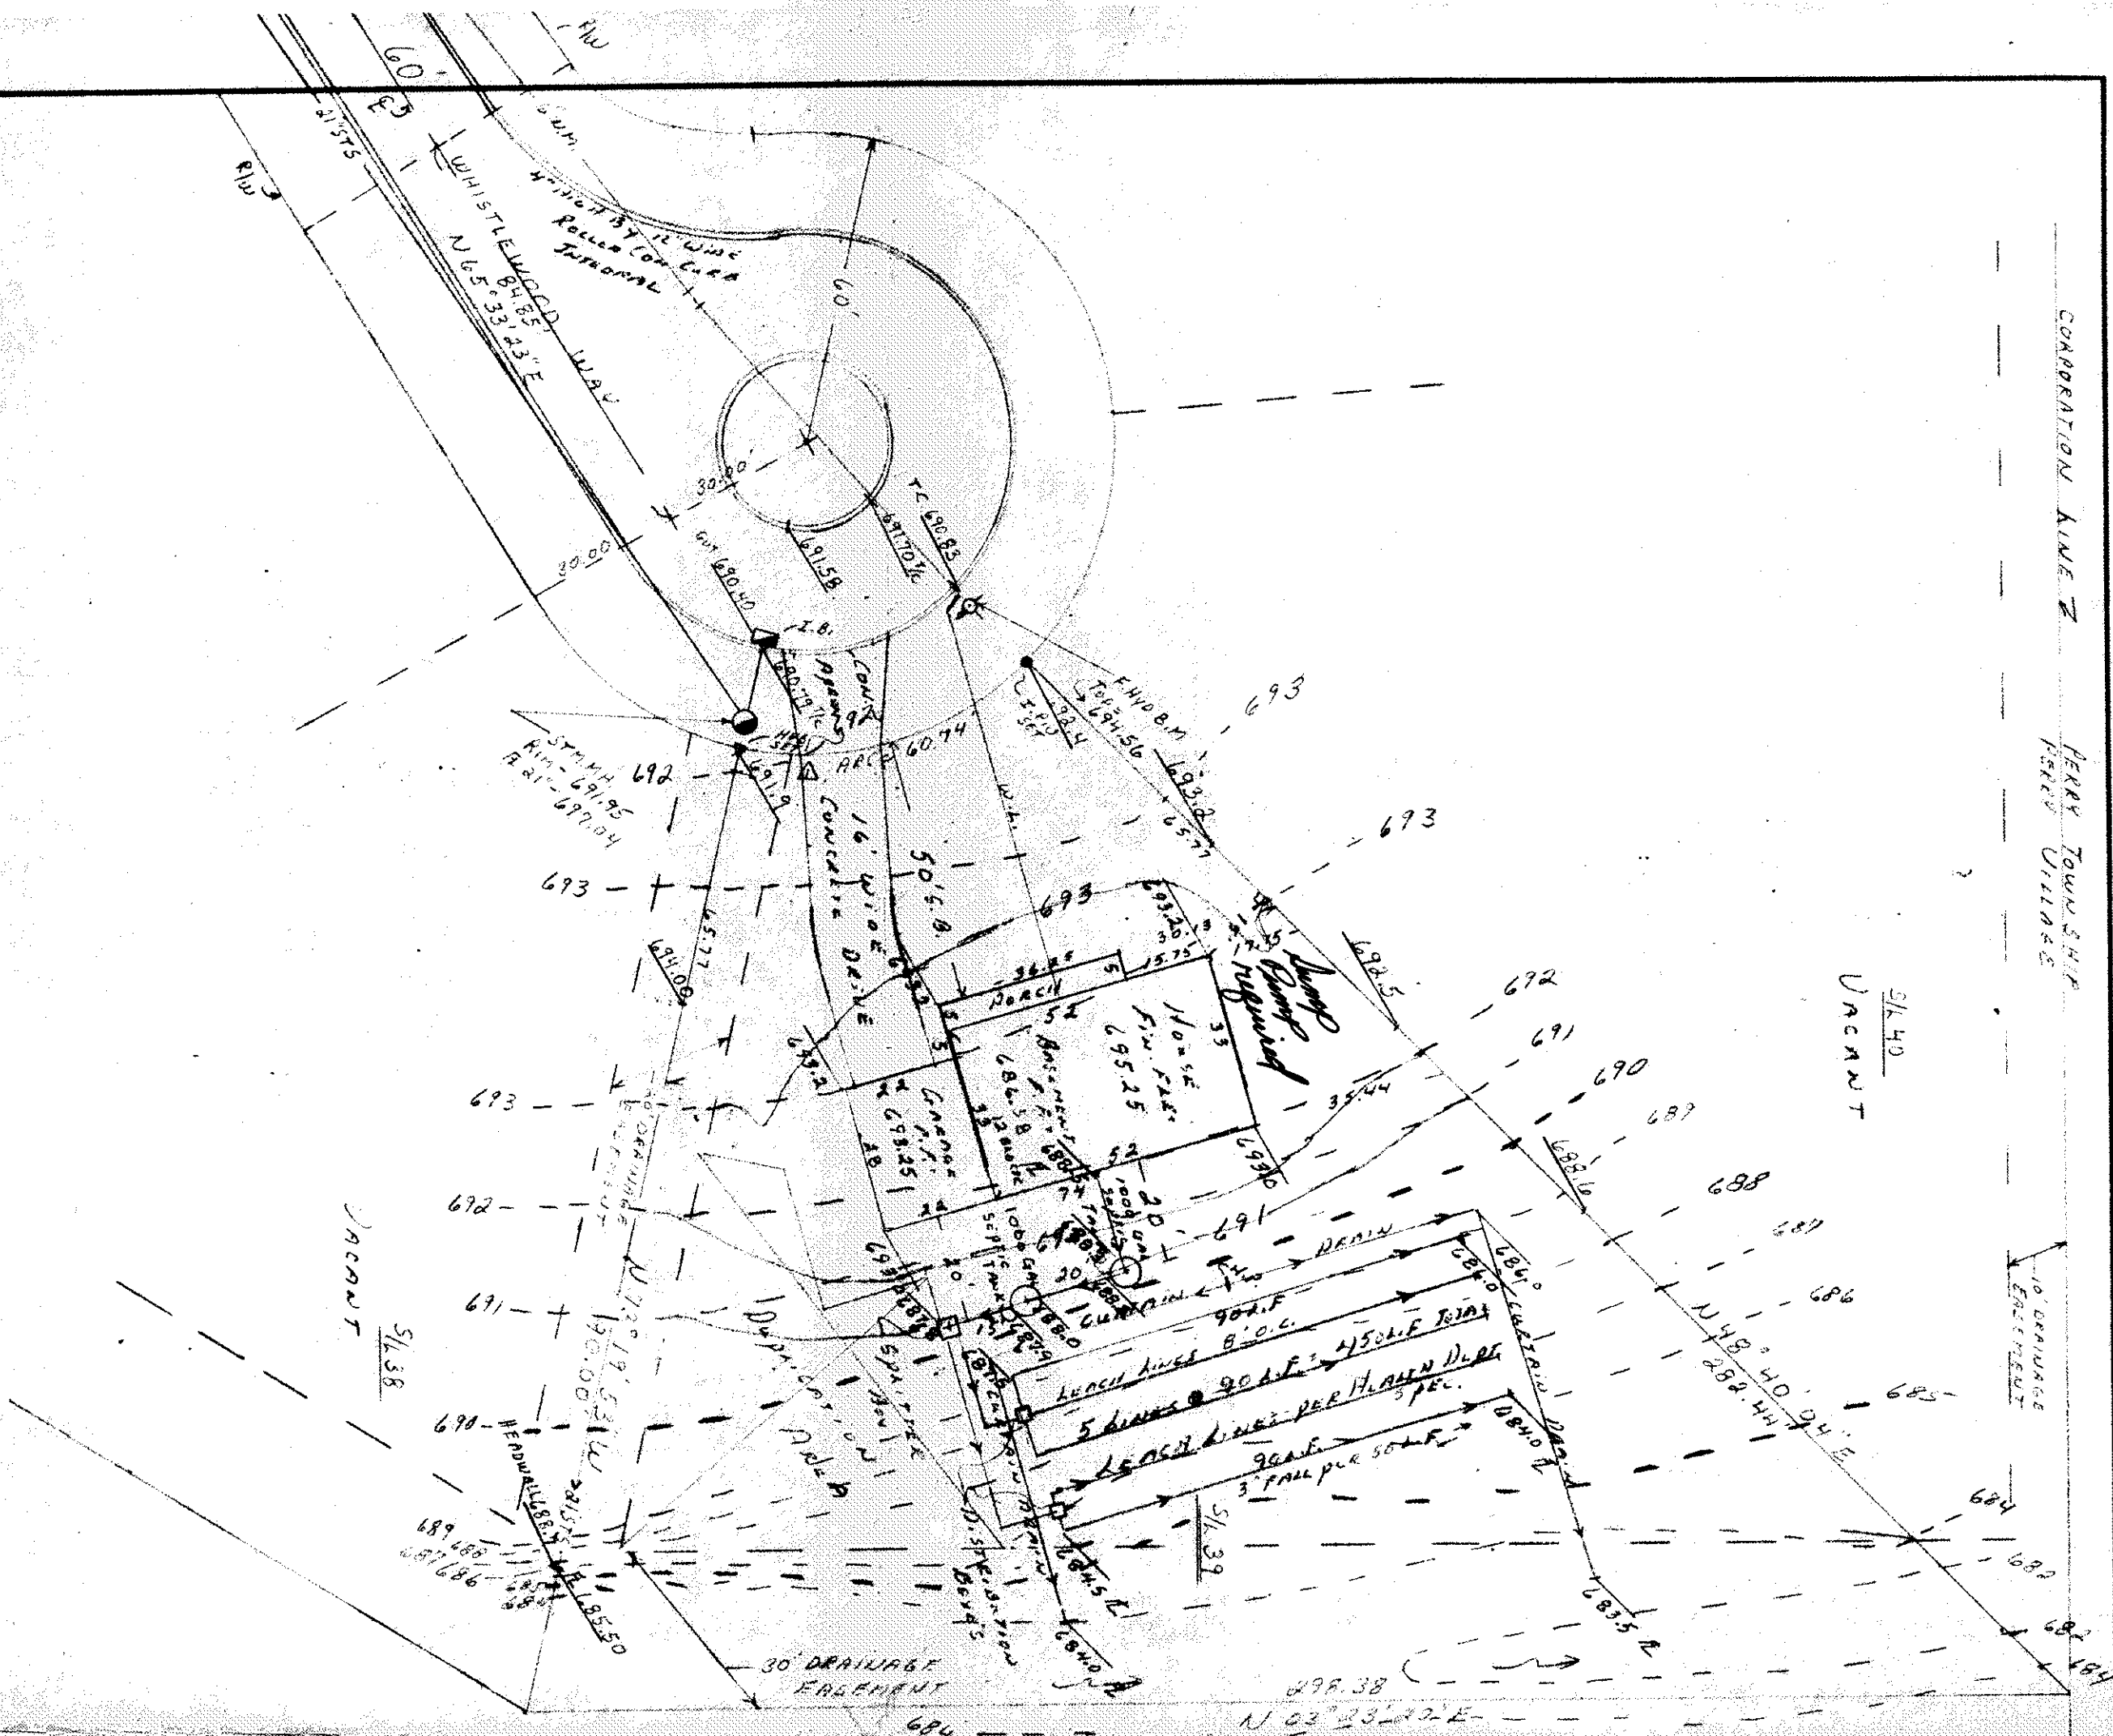

Blue Curve DATA

$ARC = 60.74$ CHORD = 58.18'

RADIUS = 60.00' Δ = 58° 00' 03"

CH B E A R I A S = 512° 20' 05" E

EXISTING CONTOUR
PROPOSED CONTOUR

EXISTING ELEVATION	PROPOSED ELEVATION
100.00	
100.00	


DIRECTION OF SURFACE DRAINAGE

BENCH MARK - TOP OF EXISTING FIRE

HYDRANT - FRONT OF 50810739/40 ELEV. = 694.56

THIS PLAT WAS PREPARED BY ME AND IS
CORRECT TO THE BEST OF MY KNOWLEDGE


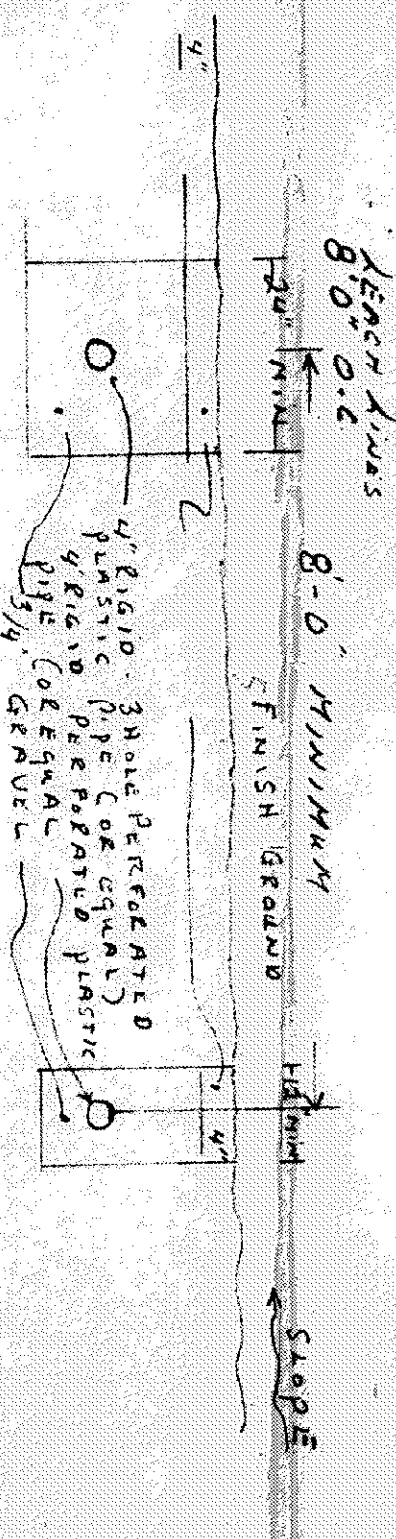


HENCH LINTS
 per inch CO. HEATH DAPT SPECIES
 CURTAIN DRAIN TRENCH
 • TYPICAL SECTION •
 NO SCALE

Note: Kim has shown more on sapic system to finish around 6 months

313 Foning Hermit

Grading Plan Approved
as shown and/or noted
THOMAS P. GILLES, P.E.
Lake County Engineer

By John A. Kelly Date 2/28/83

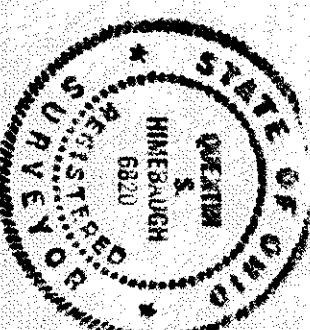

SITE PLAN - SUBLOT 39 - WHISTLEWOOD WAY

RUSTIC VILLAGE NO 2 - PERRY VILLAGE, OHIO

DATE: 9-1-88

PLAN PREPARED BY CVENTIN HINES 04/17

WILKOWICH, OHIO	946-1761	88-100
-----------------	----------	--------