



DATE	REVISIONS	BY
12/6/19	UPDATE PER REVIEW COMMENTS	M.A.

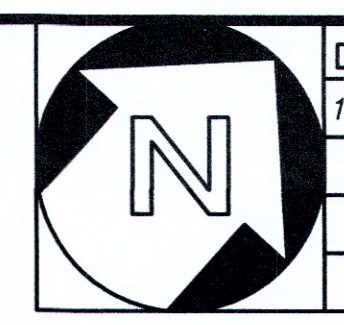

- KEY:**
- UTILITY EASEMENT TO BENEFIT P.P.N. 29-A-004-G-00-024-0 (PARCEL 1 TRACT "I" & "II")
 - PARKING EASEMENT TO BENEFIT P.P.N. 29-A-004-G-00-024-0 (PARCEL 1 TRACT "I" & "II")

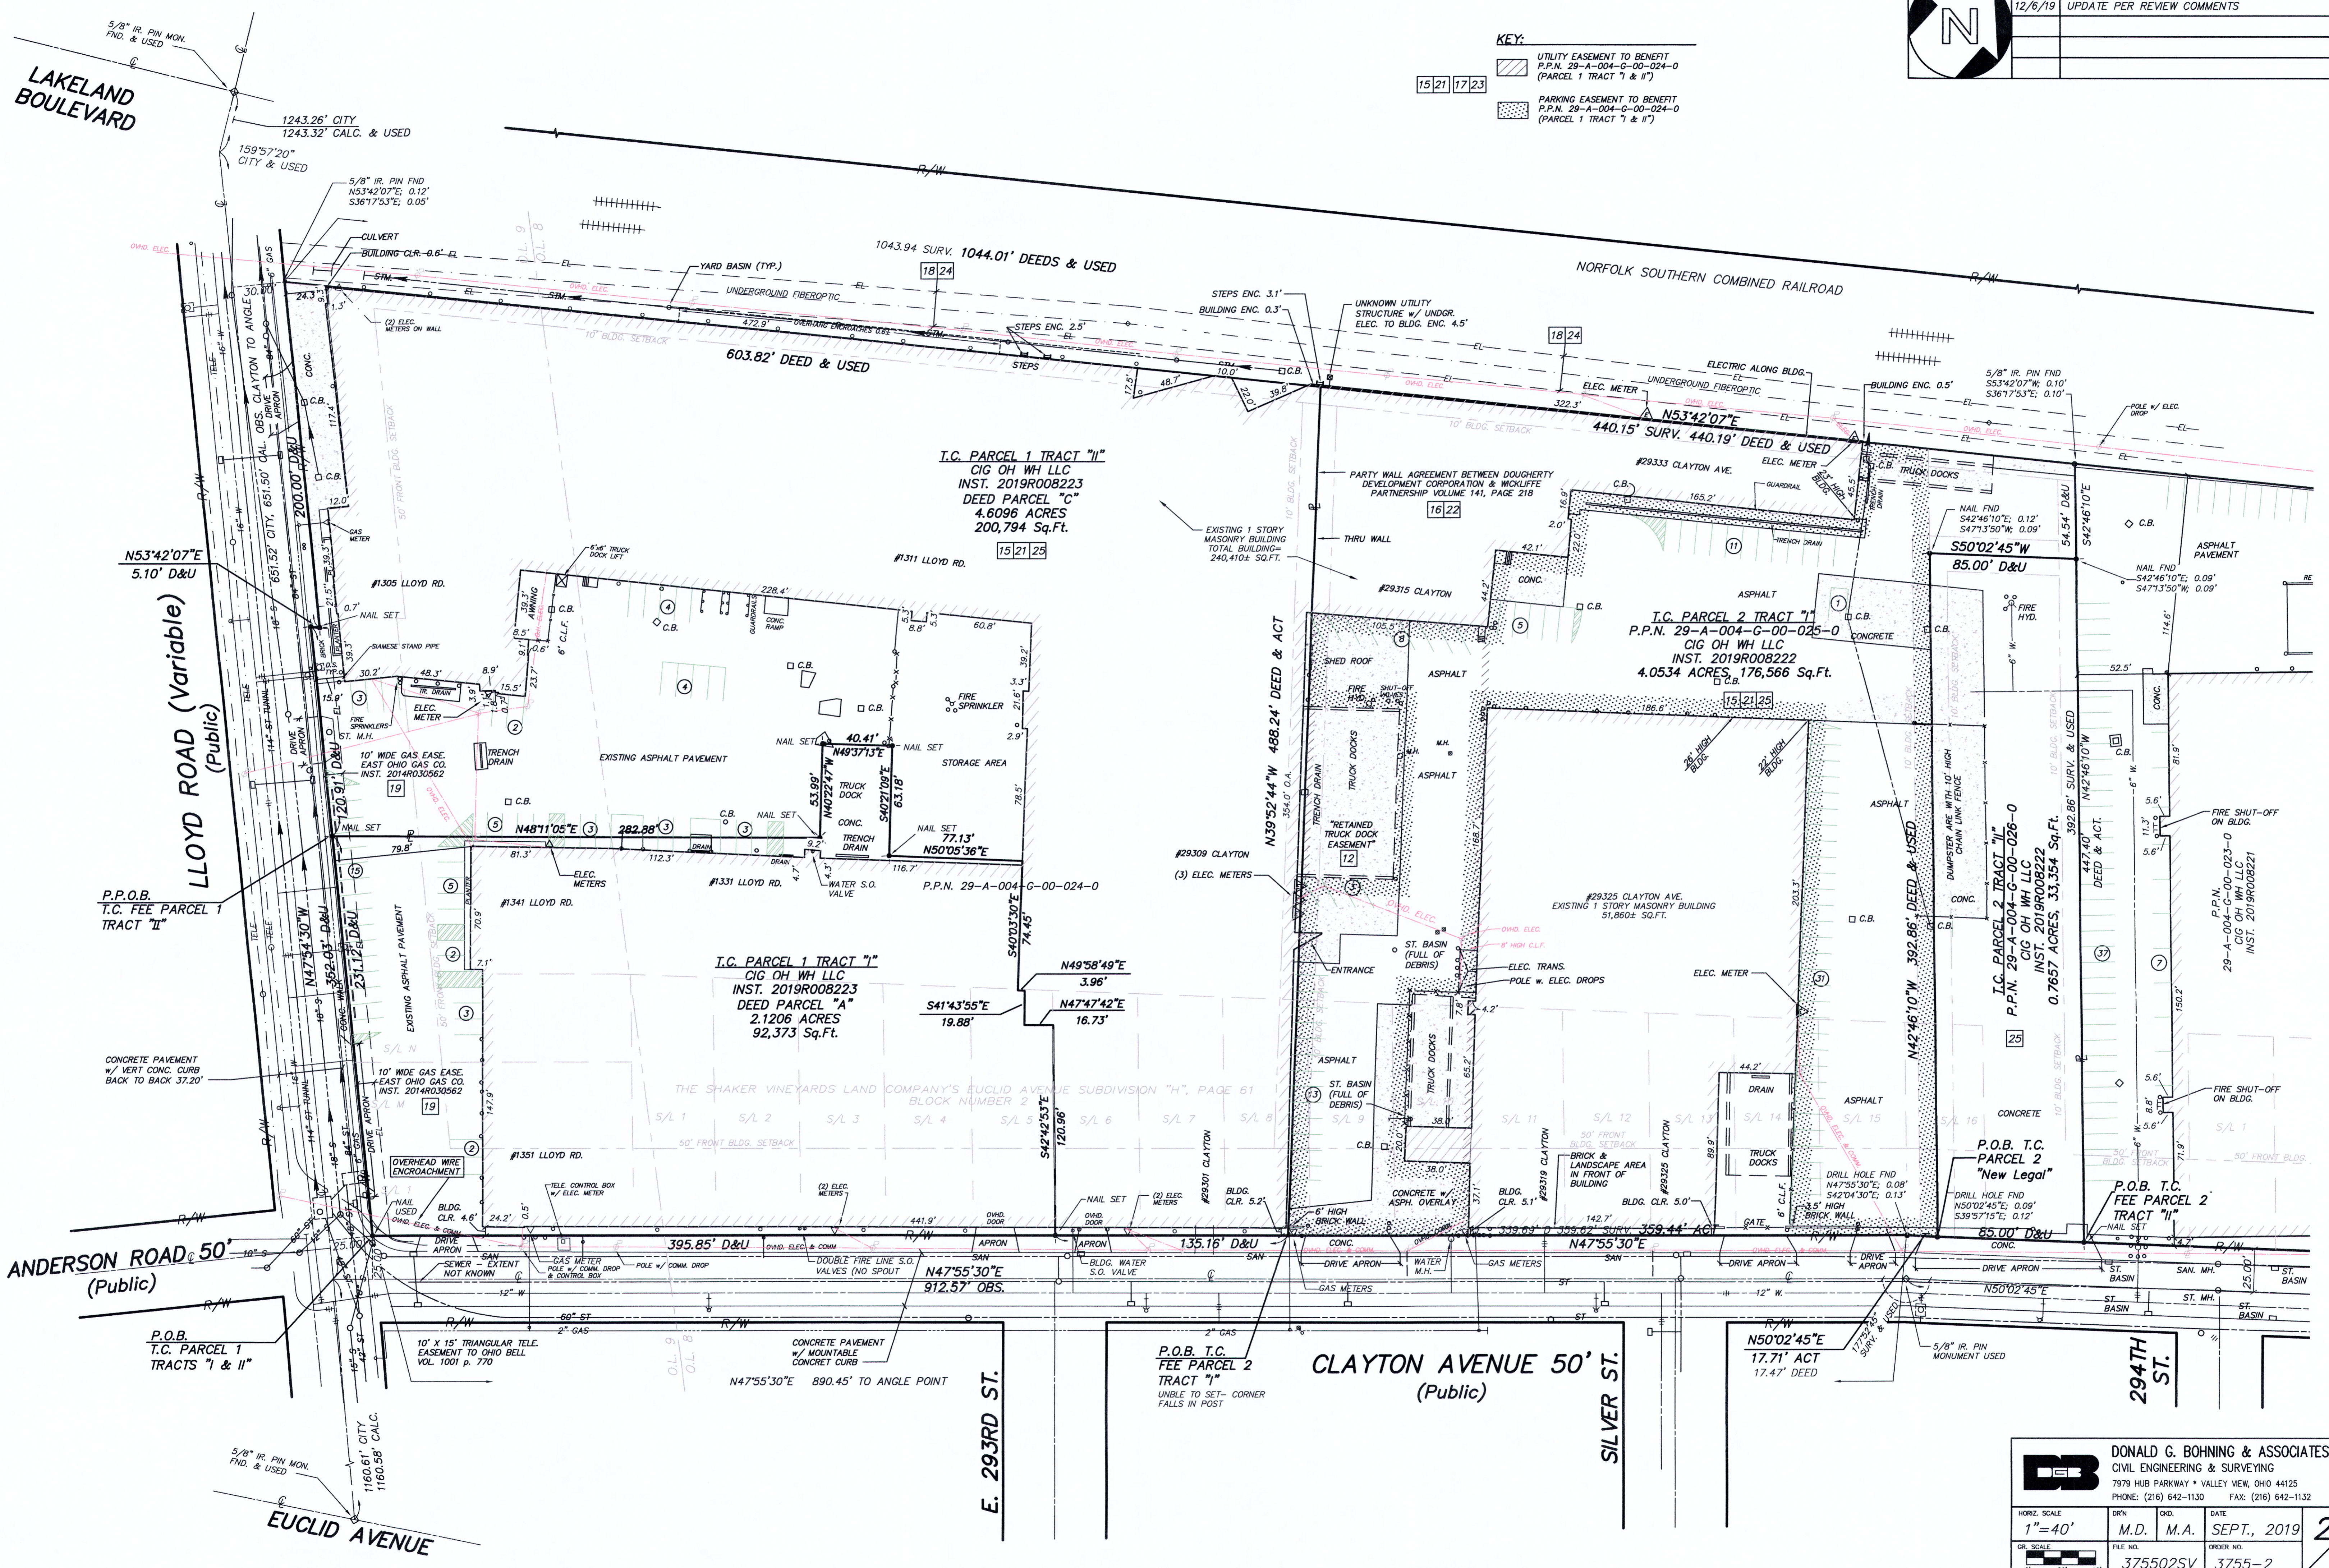

DB DONALD G. BOHNING & ASSOCIATES, INC.
 CIVIL ENGINEERING & SURVEYING
 7979 HUB PARKWAY • VALLEY VIEW, OHIO 44125
 PHONE: (216) 642-1130 FAX: (216) 642-1132

HORIZ. SCALE	DRN	OKD.	DATE	2
1"=40'	M.D.	M.A.	SEPT., 2019	
GR. SCALE	FILE NO.	ORDER NO.		2
1"=20'	375502SV	3755-2		