


FHWA REGION	STATE	PROJECT
5	OHIO	

168
171


LAKE COUNTY
LAK-2-0.00

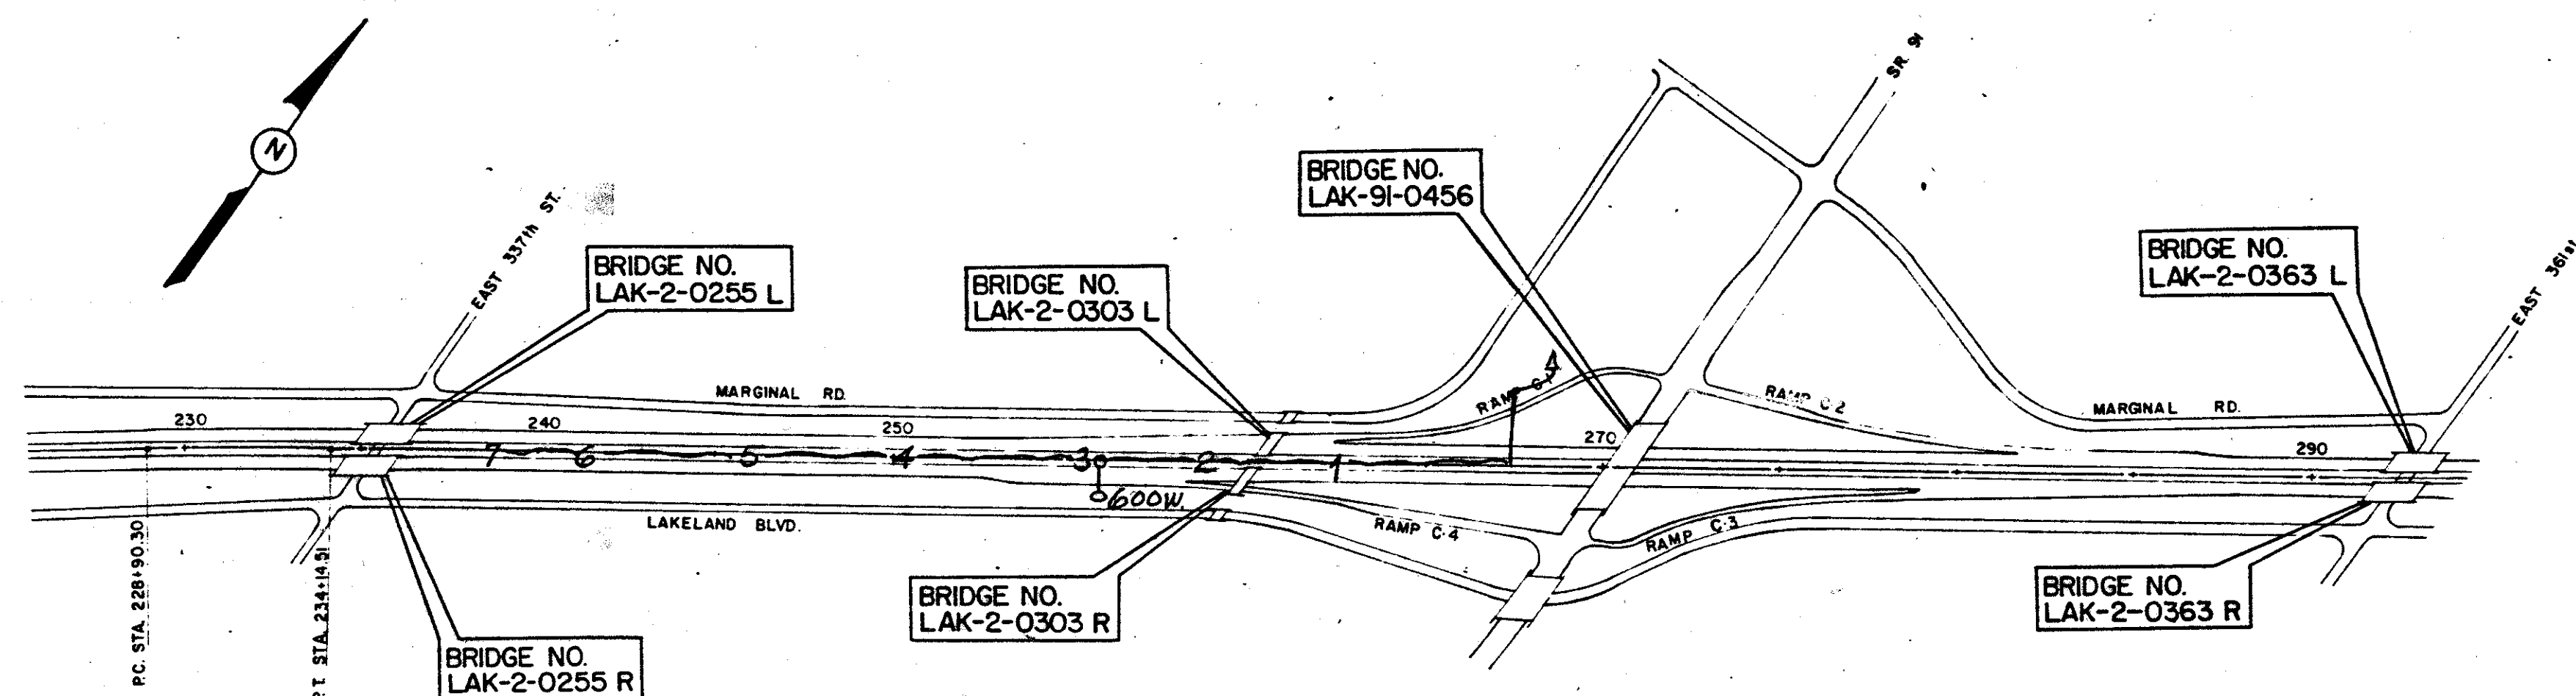

Power Service RNO 269+65 Lt. Ramp C-1

Circuit A3

21 Lights @ 400W. each = 8,400
 1 Sign @ 600W. = 600
 Total Ballast Loss = 1,800
 Total Circuit Watts = 10,800

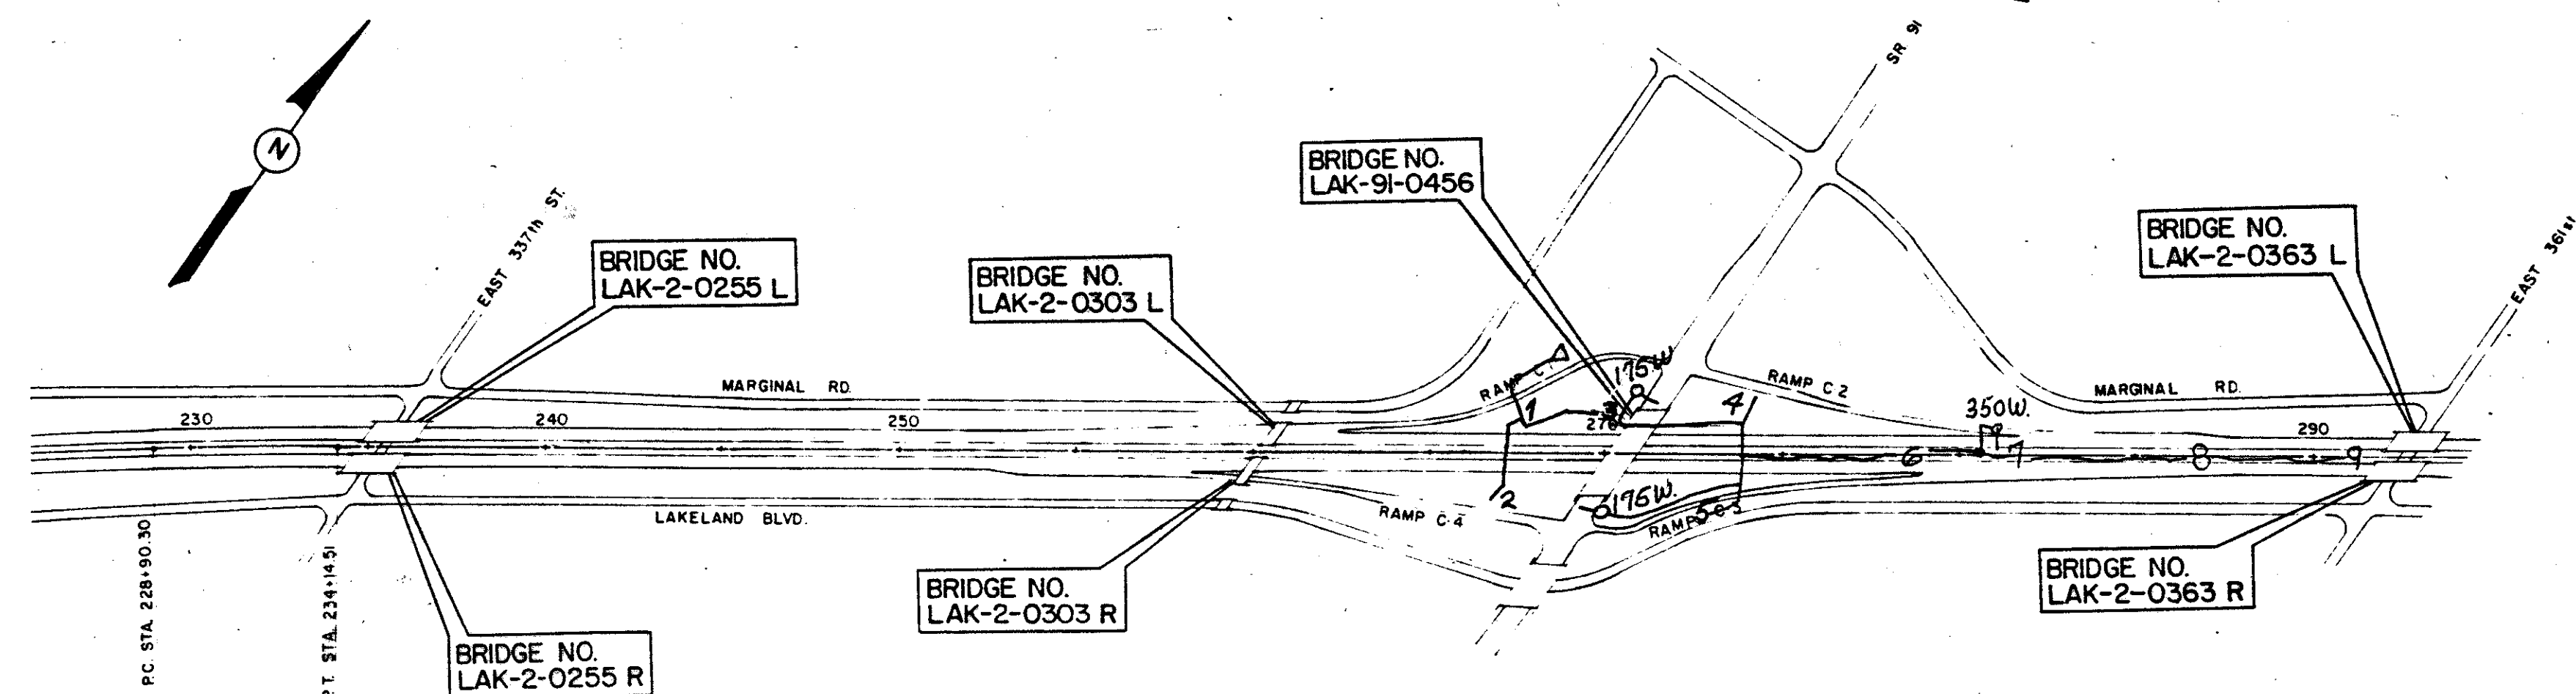

Power Service RNO 269+65 Lt. Ramp C-1

Circuit B3

32 Lights @ 400W. each = 12,800
 2 Signs @ 175W. = 350
 1 sign @ 350W. = 350
 Total Ballast Loss = 2,730
 Total Circuit Watts = 16,230

SCALE IN FEET
 0 20 40 60