


FED. RD. DIVISION	STATE	PROJECT	FISCAL YEAR
2	OHIO		

124
394

LAKE COUNTY
LAK-2 - 0.00
LIMITED ACCESS

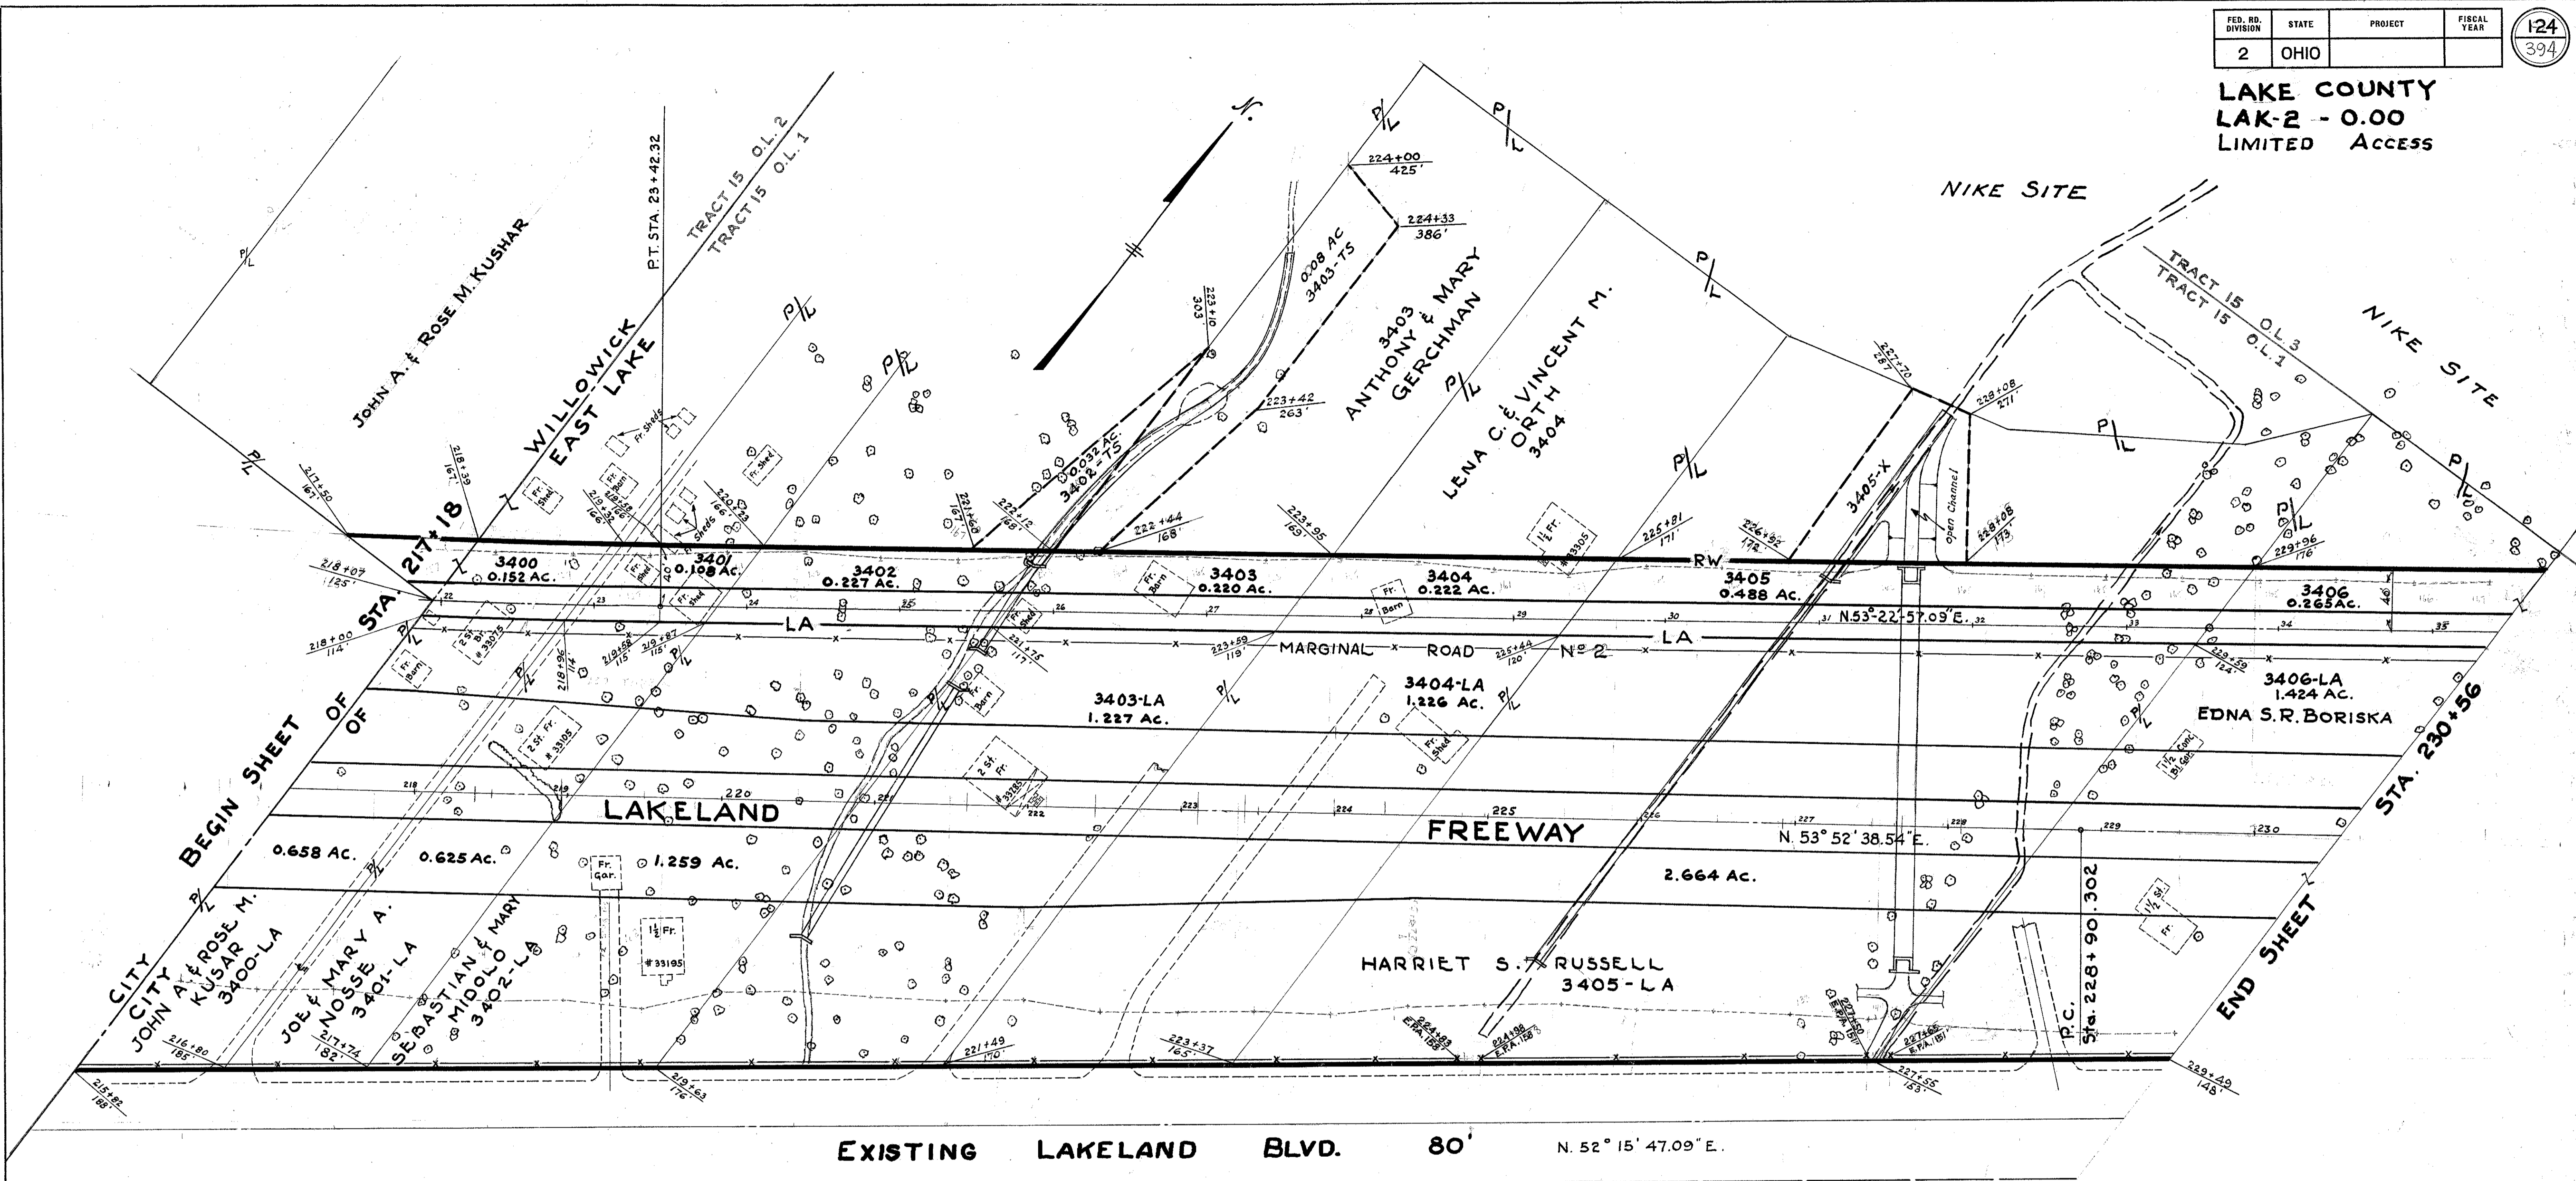

REV. 8-18-60 Parcel 3402 TS & 3403 TS ADDED

2780 LIN. FT. 55-18 FENCE TYPE "C" Scale: 1" = 50'