J:\DWGS\963241\9IMPC.DGN SHEET NO. 3

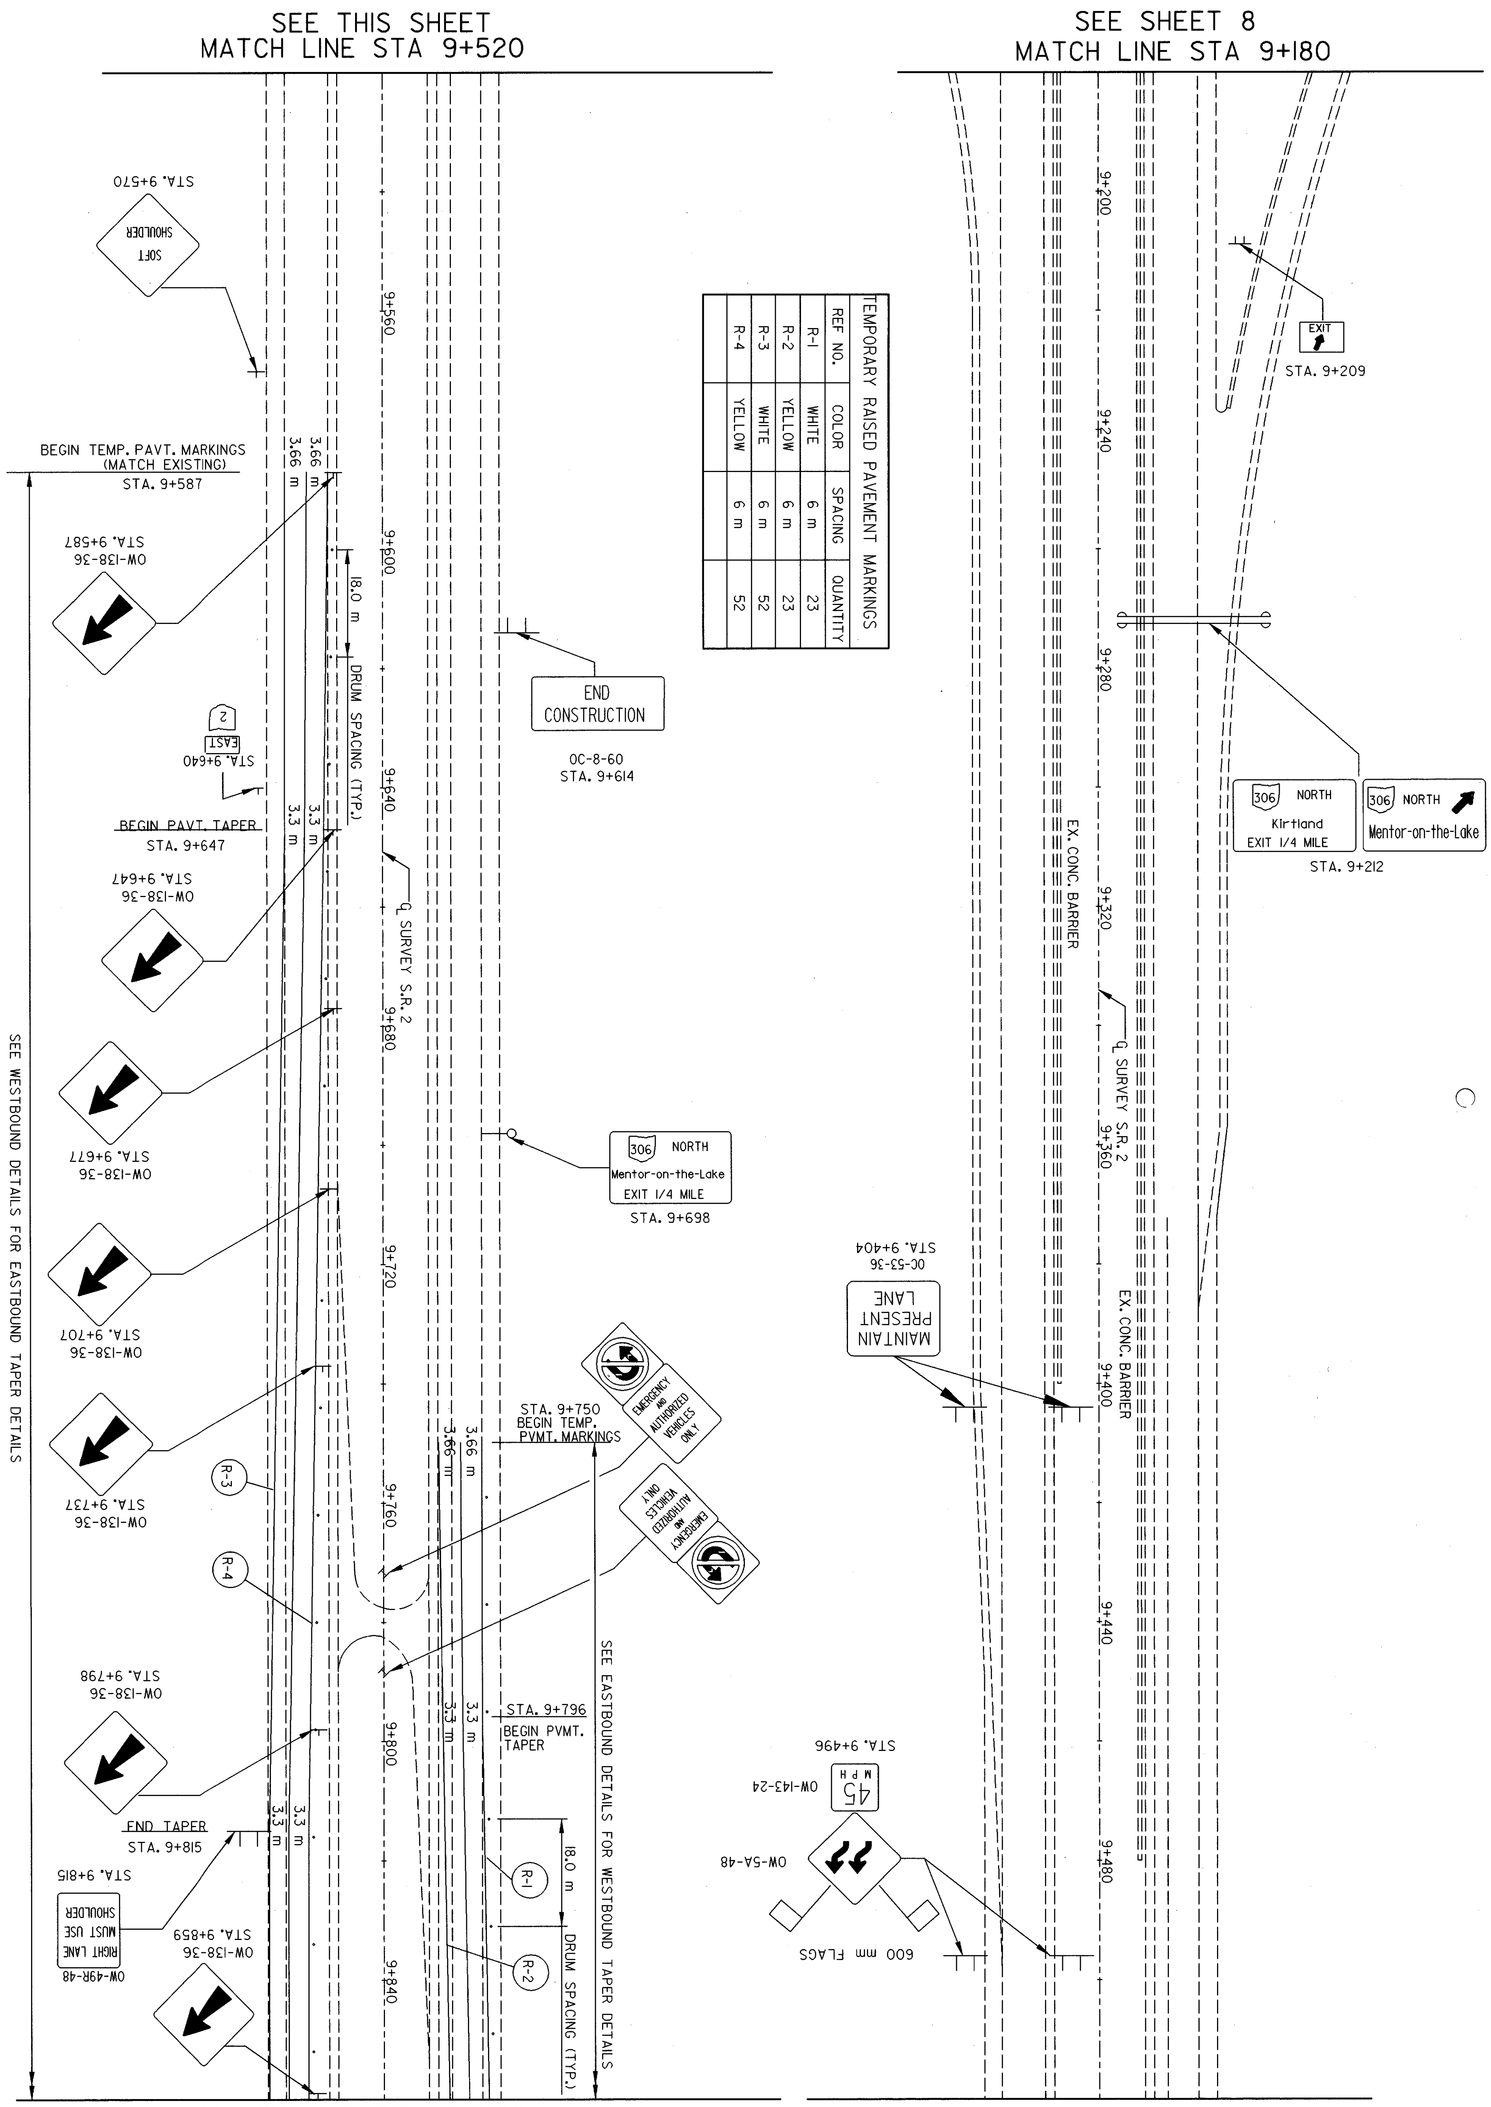

TEMPORARY RAISED PAVEMENT MARKINGS			
REF. NO.	COLOR	SPACING	QUANTITY
R-1	WHITE	6 m	23
R-2	YELLOW	6 m	23
R-3	WHITE	6 m	52
R-4	YELLOW	6 m	52

AS-BUILT DRAWINGS 11/97

9/43	LAK-2-12.231	MAINTENANCE OF TRAFFIC - PHASE I STA. 9+180 TO STA. 9+860	CALCULATED / CHECKED	10 0 5 10 HORIZONTAL SCALE IN METERS NORTH