


SEE SHEET II

SEE THIS SHEET
MATCH LINE STA 10+200

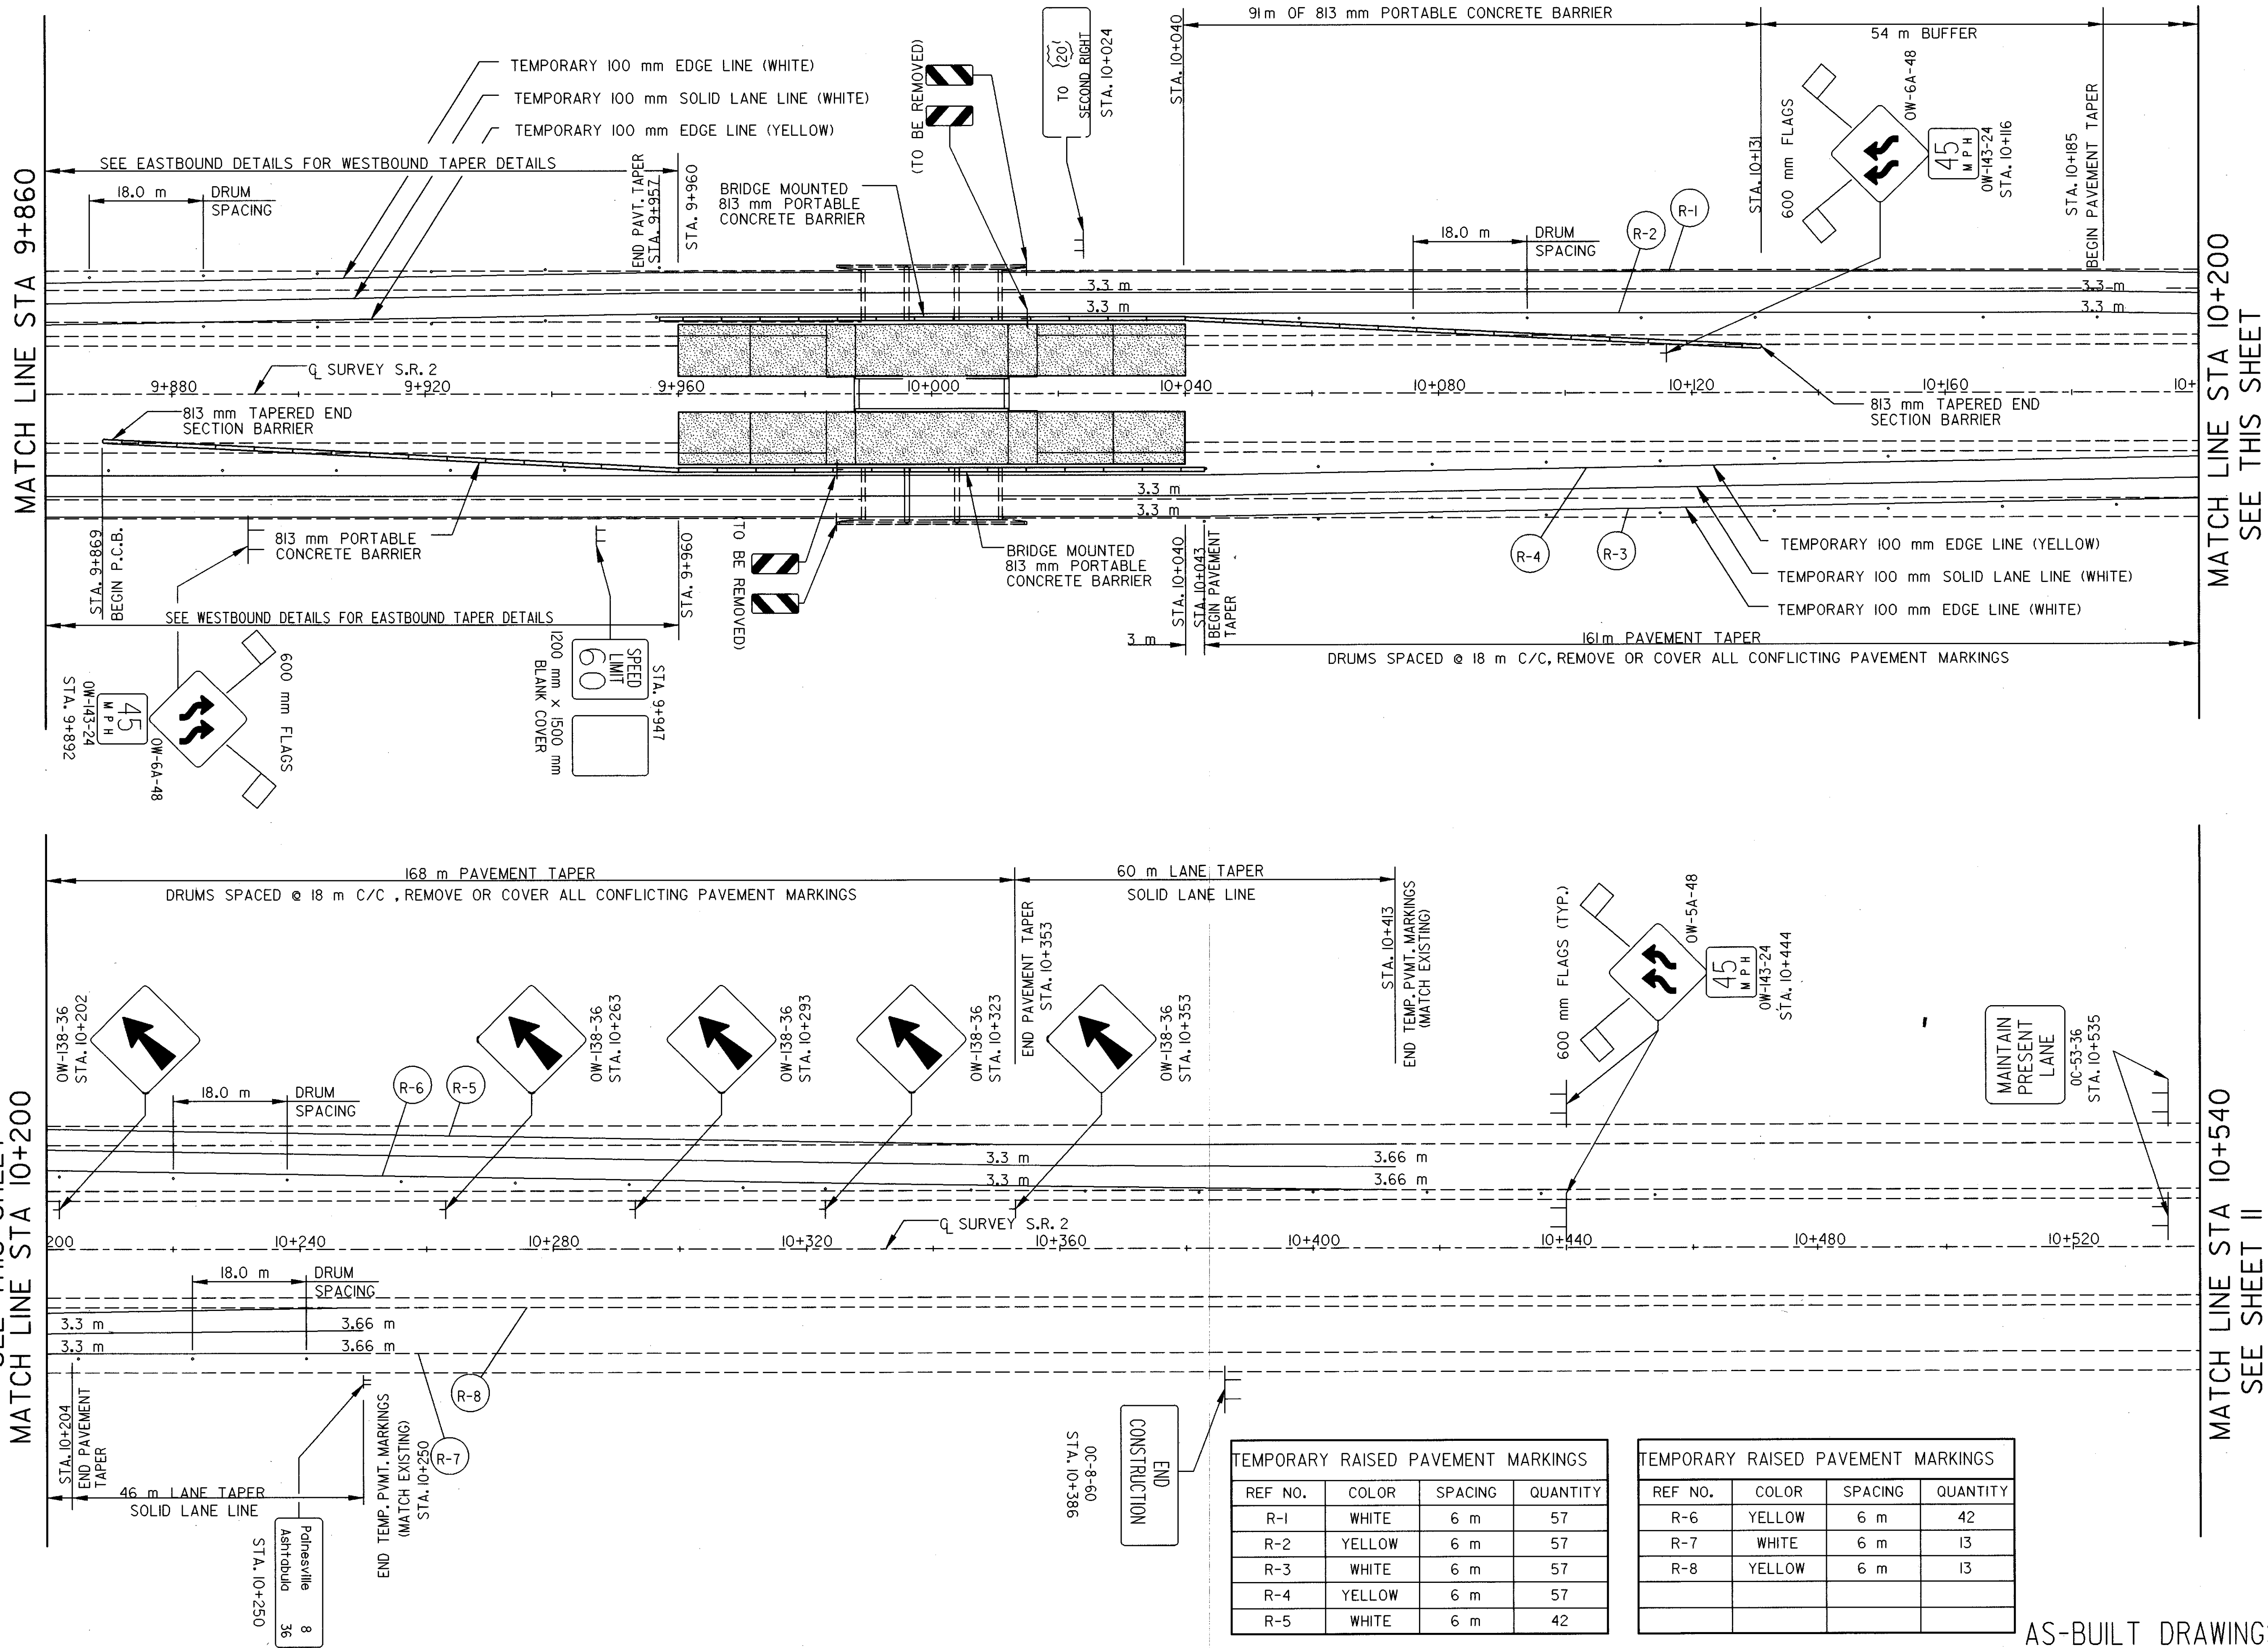

REF NO.	COLOR	SPACING	QUANTITY
R-1	WHITE	6 m	57
R-2	YELLOW	6 m	57
R-3	WHITE	6 m	57
R-4	YELLOW	6 m	57
R-5	WHITE	6 m	42

REF NO.	COLOR	SPACING	QUANTITY
R-6	YELLOW	6 m	42
R-7	WHITE	6 m	13
R-8	YELLOW	6 m	13