


SEE THIS SHEET
MATCH LINE STA 8+520

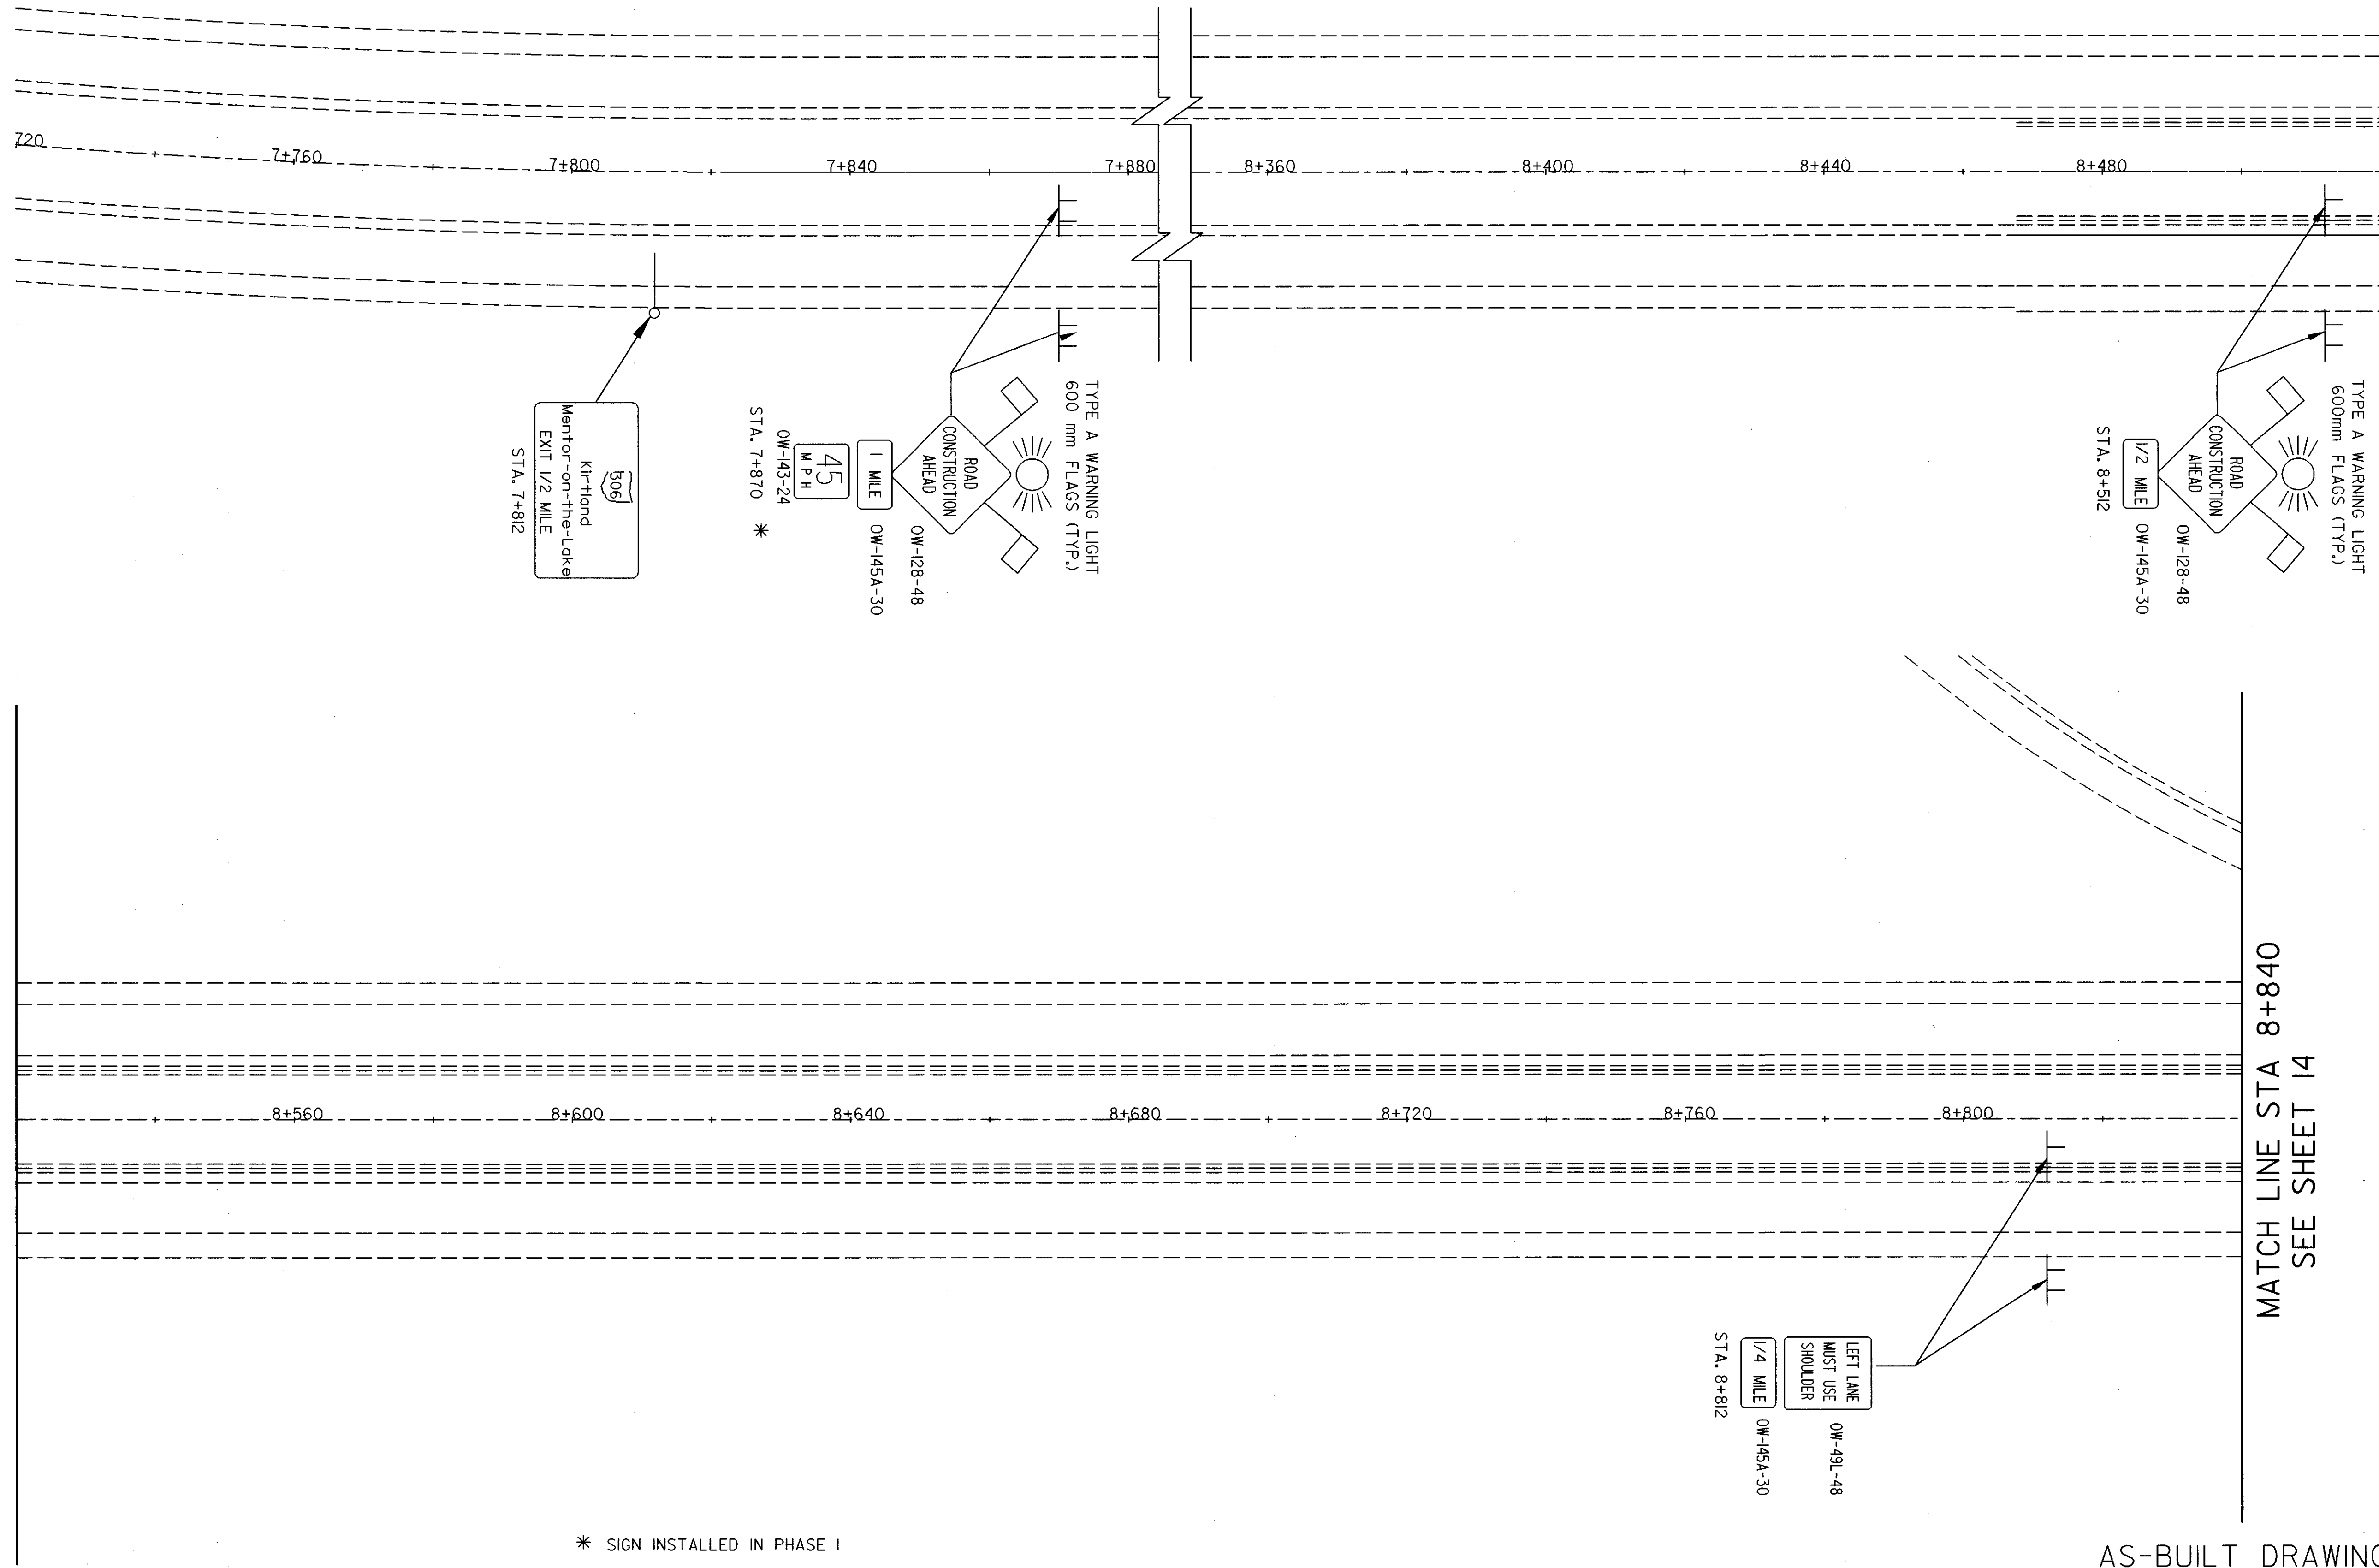

* SIGN INSTALLED IN PHASE I

<p>NORTH</p>	
<p>HORIZONTAL SCALE IN METERS</p>	
CALCULATED	CHECKED

MAINTENANCE OF TRAFFIC - PHASE 2
STA. 7+870 TO STA. 8+840