J:\DWGS\963241X\MPG.DGN SHEET NO. 2

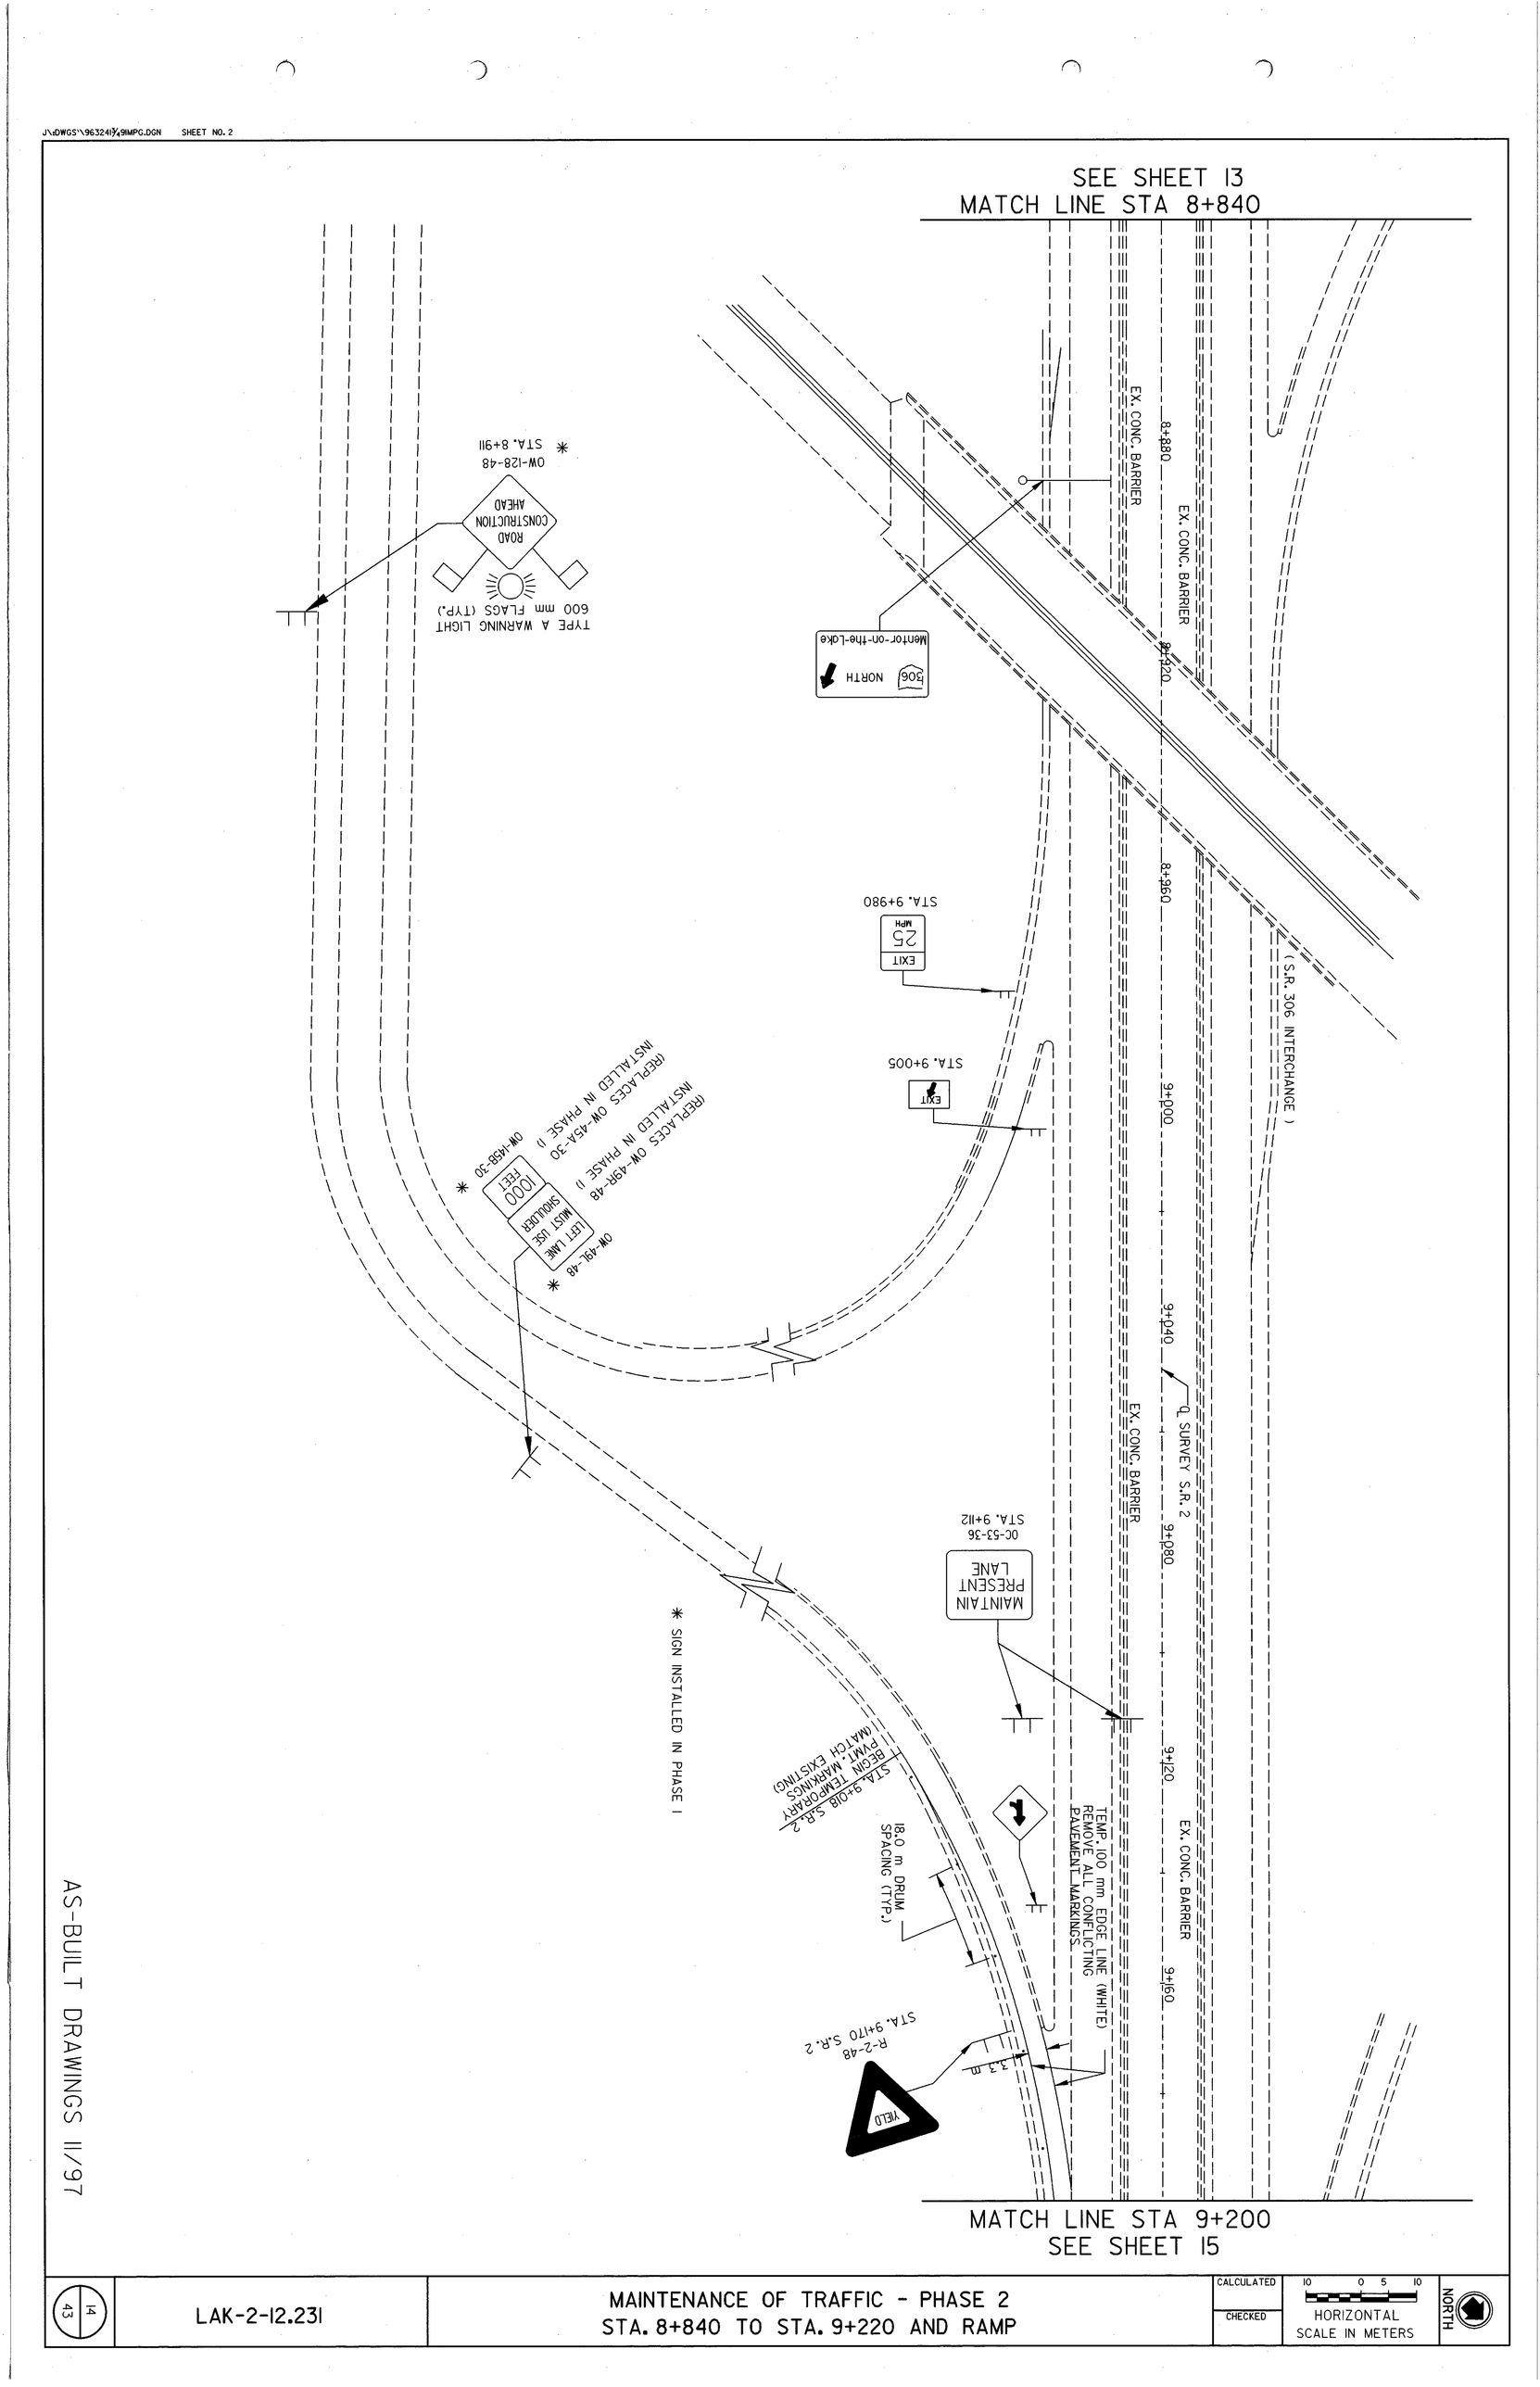

AS-BUILT DRAWINGS 11/97

14 / 43	LAK-2-12.231	MAINTENANCE OF TRAFFIC - PHASE 2 STA. 8+840 TO STA. 9+220 AND RAMP	CALCULATED CHECKED	10 0 5 10 HORIZONTAL SCALE IN METERS NORTH