


SEE SHEET 14
MATCH LINE STA 9+200

SEE THIS SHEET
MATCH LINE STA 9+560

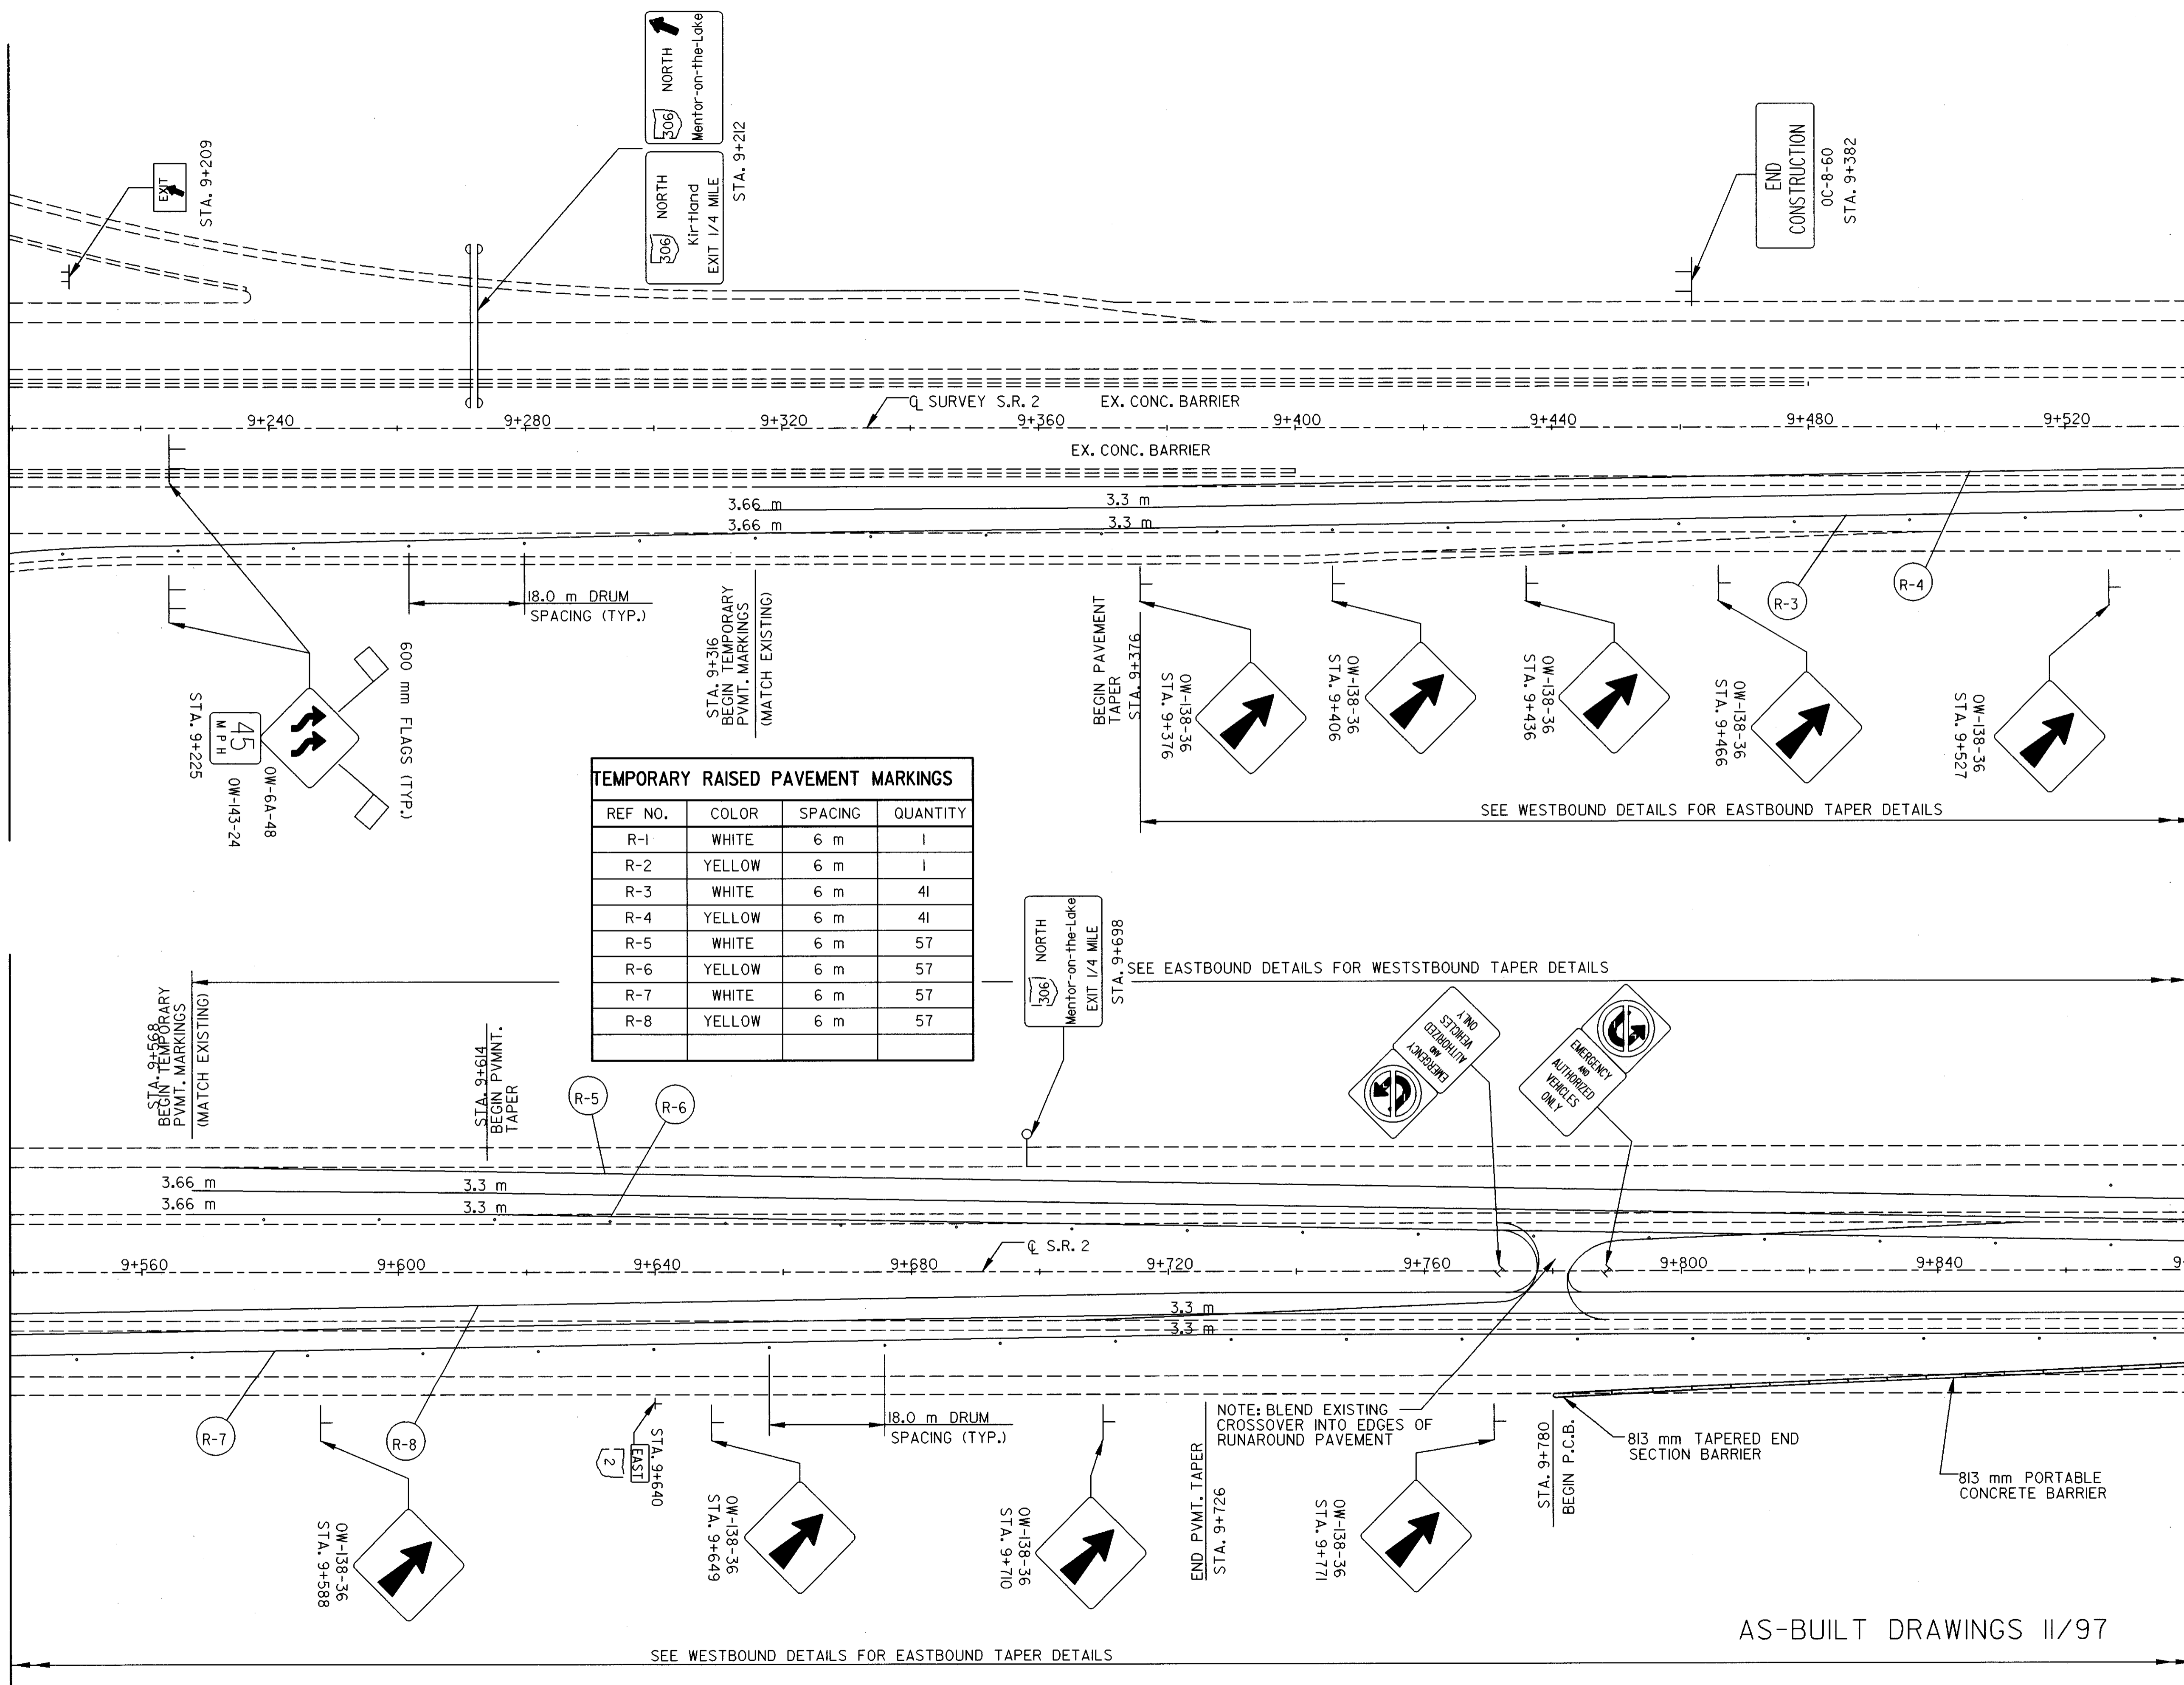


TEMPORARY RAISED PAVEMENT MARKINGS

REF NO.	COLOR	SPACING	QUANTITY
R-1	WHITE	6 m	1
R-2	YELLOW	6 m	1
R-3	WHITE	6 m	41
R-4	YELLOW	6 m	41
R-5	WHITE	6 m	57
R-6	YELLOW	6 m	57
R-7	WHITE	6 m	57
R-8	YELLOW	6 m	57

MATCH LINE STA 9+560
SEE THIS SHEET

MATCH LINE STA 9+880
SEE SHEET 16

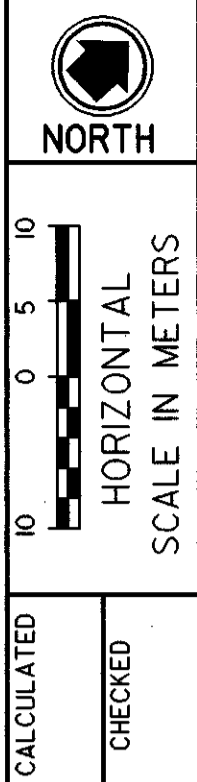

CALCULATED
CHECKED

MAINTENANCE OF TRAFFIC - PHASE 2
STA. 9+220 TO STA. 9+880