


SEE SHEET 16  
MATCH LINE STA 10+560

SEE THIS SHEET  
MATCH LINE STA 10+900

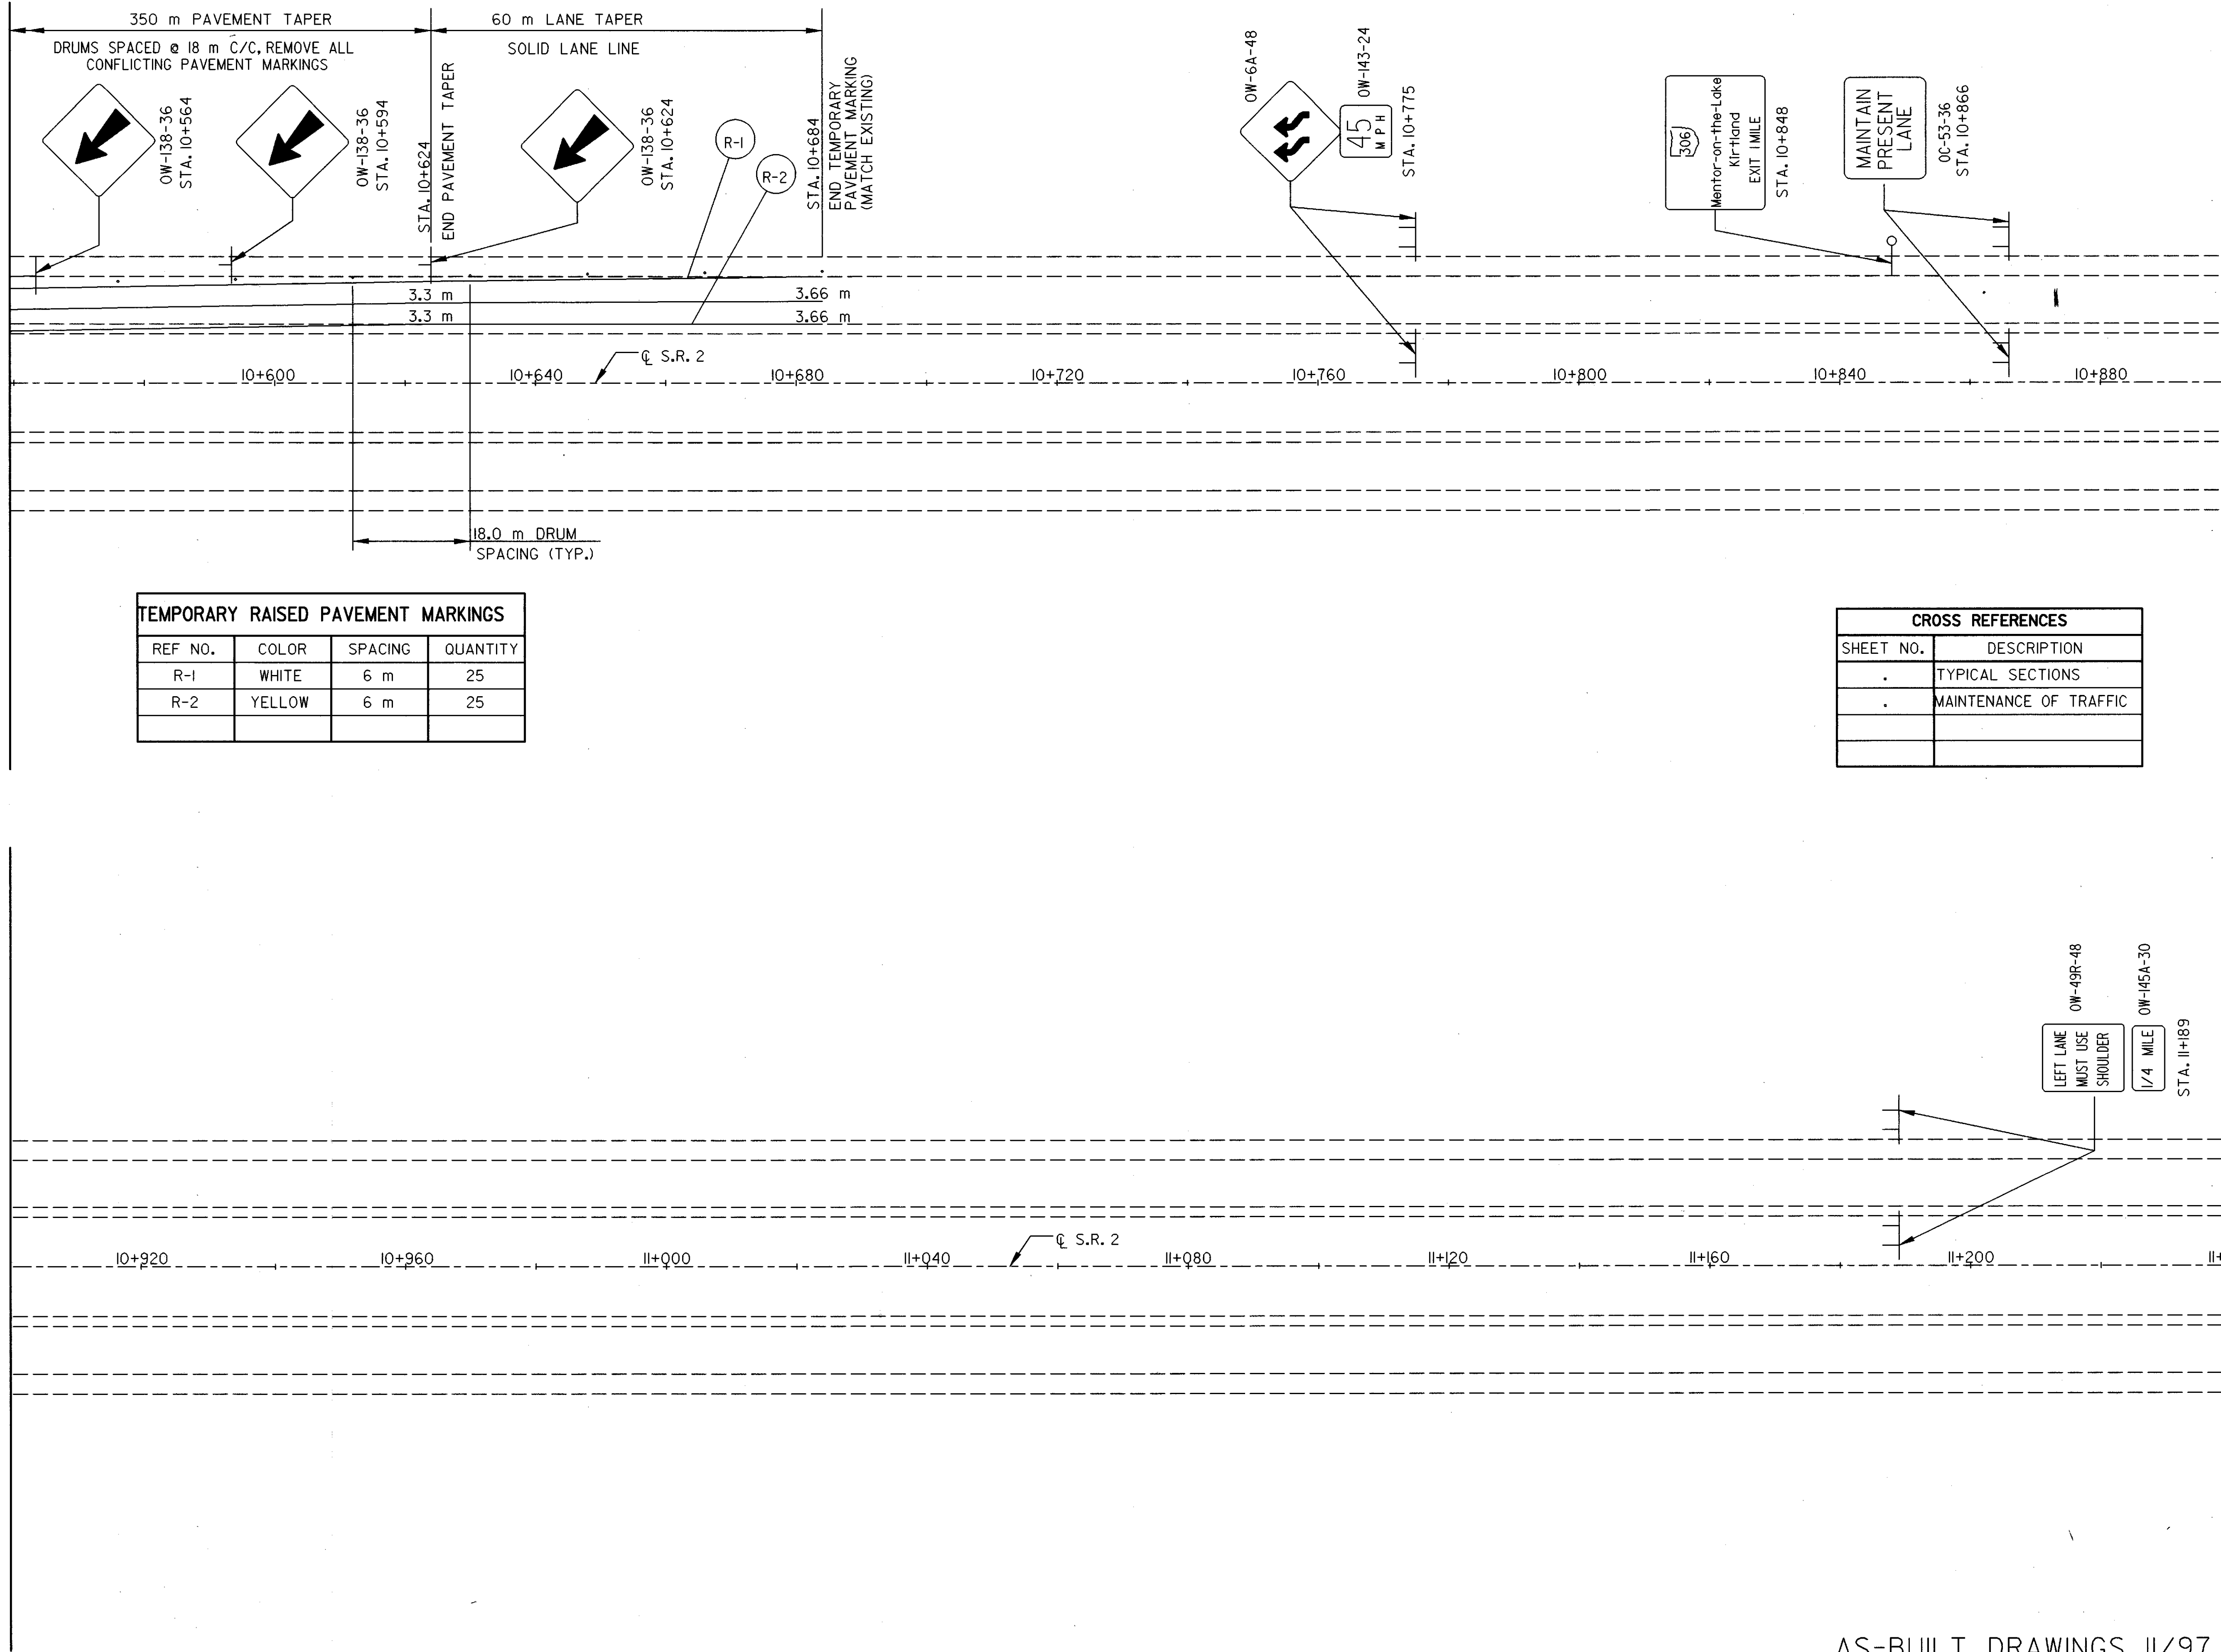

TEMPORARY RAISED PAVEMENT MARKINGS			
REF NO.	COLOR	SPACING	QUANTITY
R-1	WHITE	6 m	25
R-2	YELLOW	6 m	25

CROSS REFERENCES	
SHEET NO.	DESCRIPTION
	TYPICAL SECTIONS
	MAINTENANCE OF TRAFFIC

MATCH LINE STA 10+900  
SEE THIS SHEET

MATCH LINE STA 11+240  
SEE SHEET 18



MAINTENANCE OF TRAFFIC - PHASE 2  
STA. 10+560 TO STA. 11+240