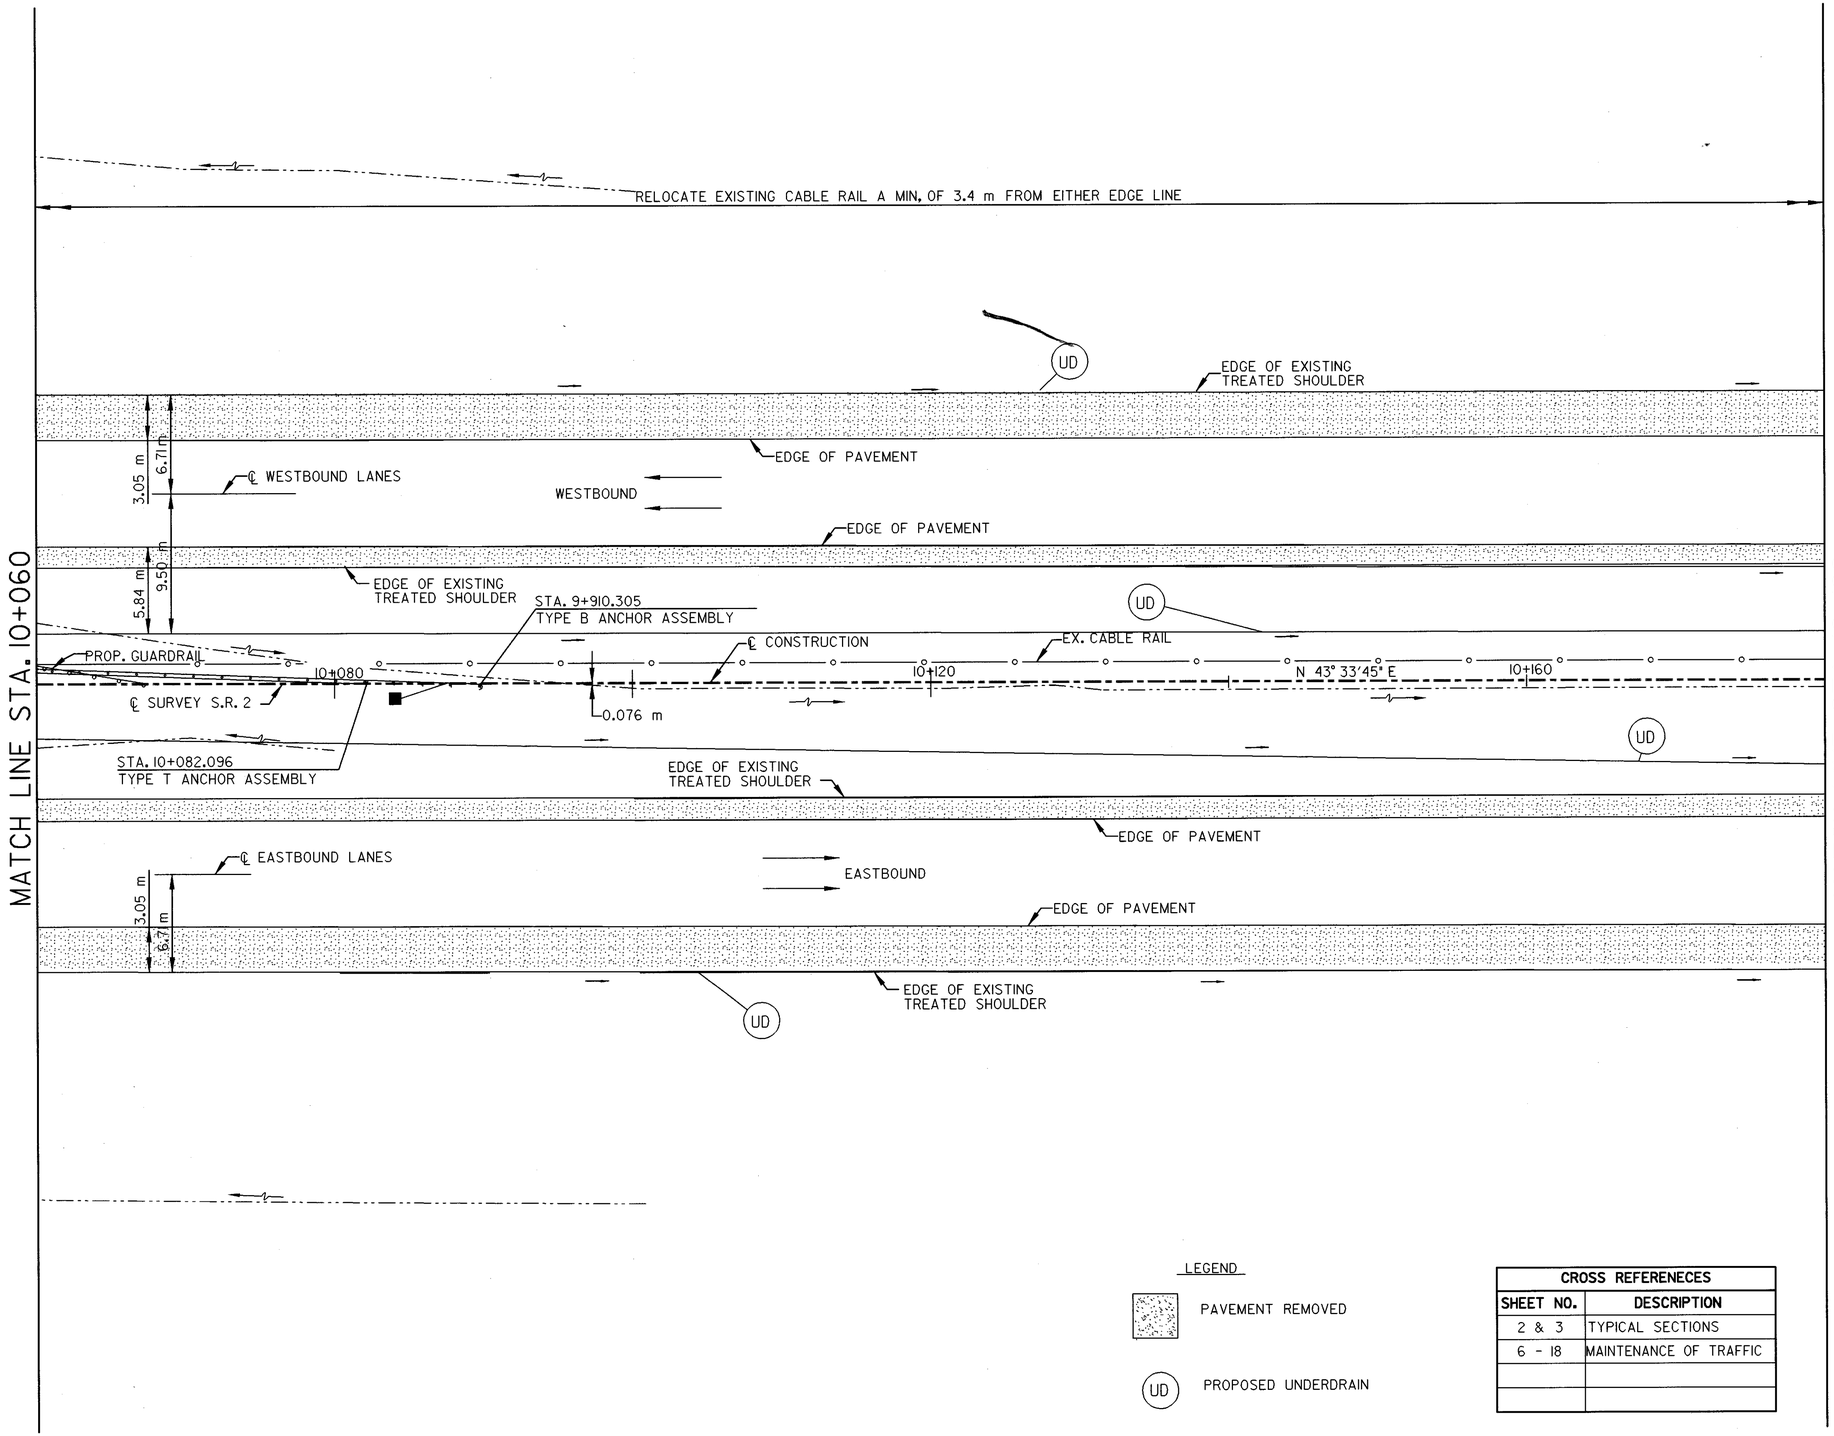

LEGEND

PAVEMENT REMOVED

UD PROPOSED UNDERDRAIN

CROSS REFERENECES	
SHEET NO.	DESCRIPTION
2 & 3	TYPICAL SECTIONS
6 - 18	MAINTENANCE OF TRAFFIC

AS-BUILT DRAWINGS 11/97

NORTH

HORIZONTAL SCALE IN METERS
5 2.5 0 5

CALCULATED

CHECKED

PLAN SHEET
STA. 9+360 TO STA. 9+480

LAK-2-12.231

26
43

J:\DWGS\1963249\GNGPHLOGN DATE: NOV. 12, 1997 TIME: 4:45 PM