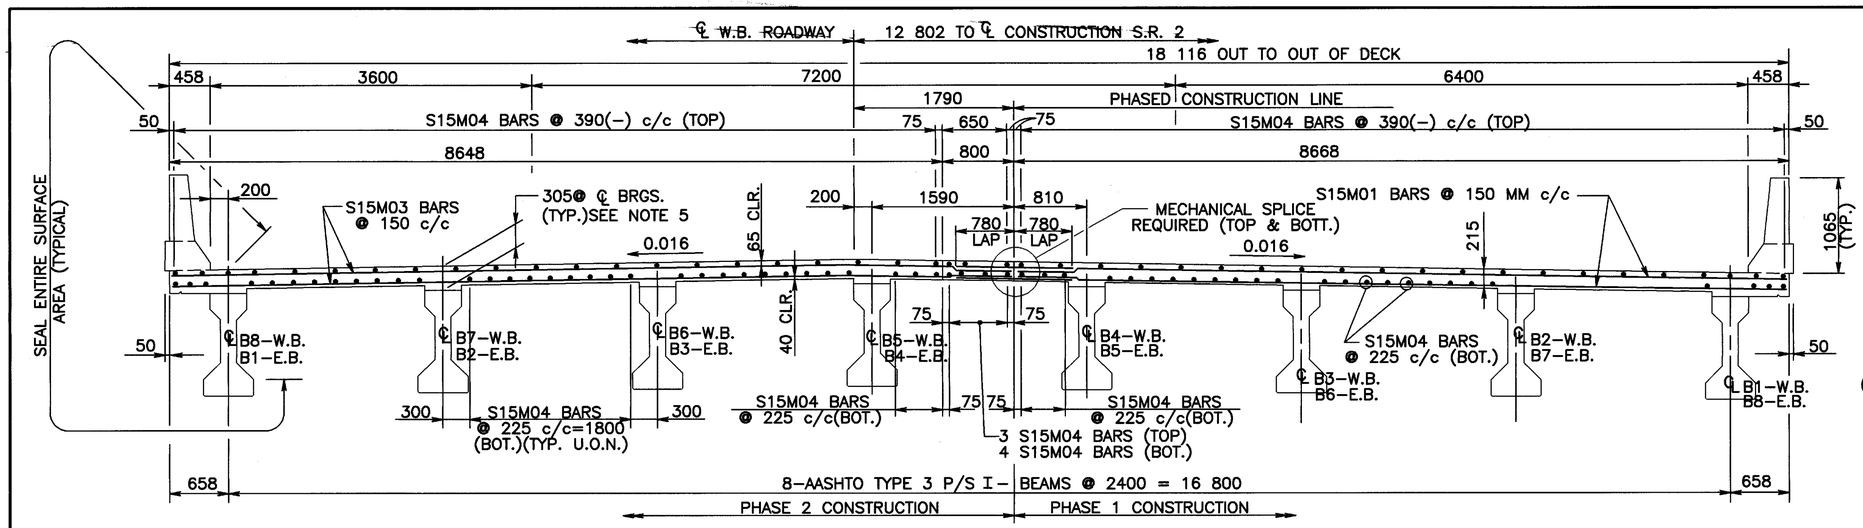

TYPICAL DECK SECTION

(LEFT BRIDGE SHOWN, RIGHT BRIDGE OPPOSITE HAND)

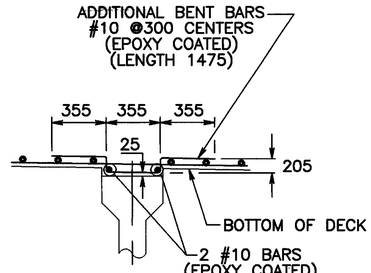

HAUNCH REINFORCING DETAIL

(END 20' OF PHASE 2 INTERIOR BEAMS ONLY)

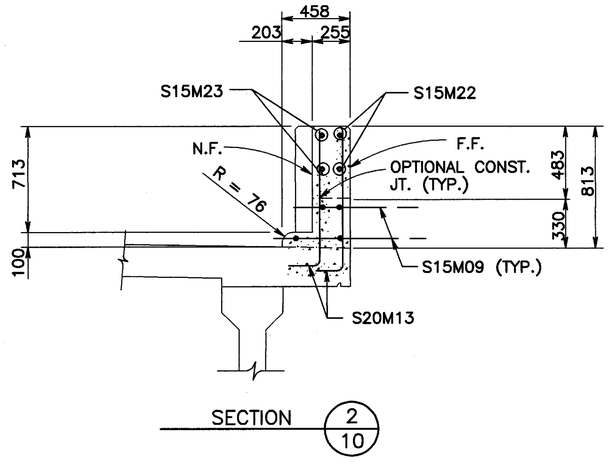

SECTION 2/10

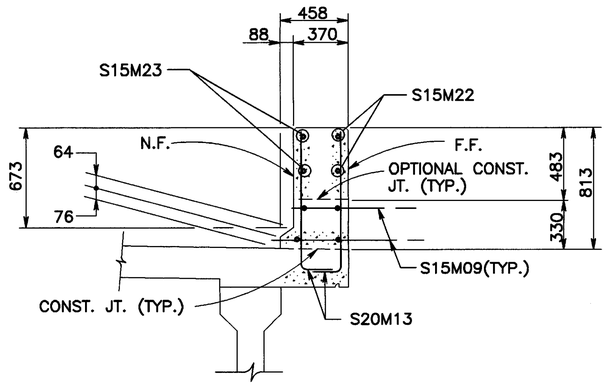

SECTION 3/10

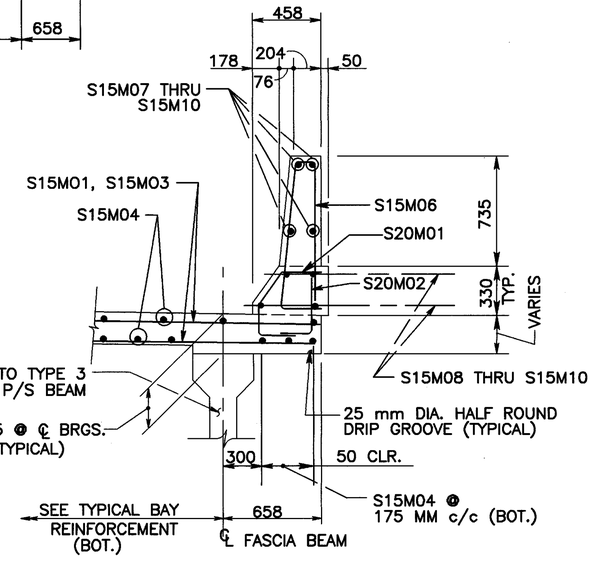

TYPICAL OVERHANG

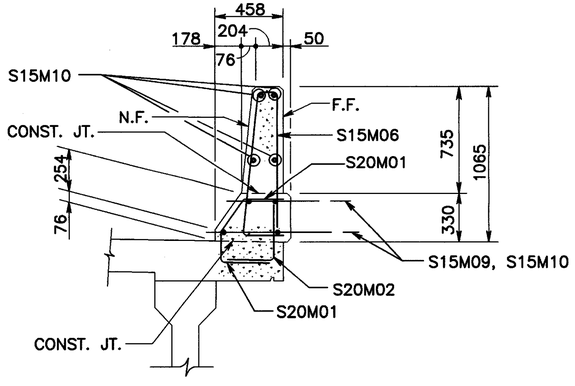

SECTION 5/10

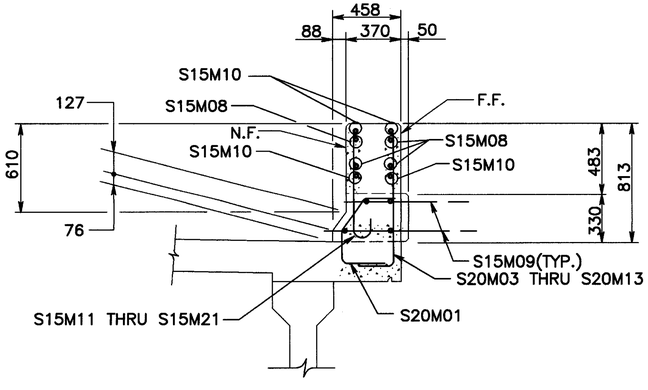

SECTION 4/10

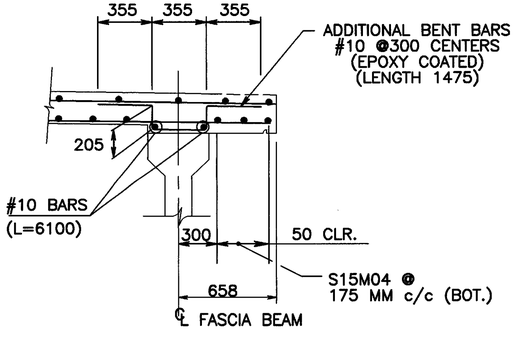

HAUNCH REINFORCING DETAIL

(END 20' OF PHASE 2 FASCIA BEAMS ONLY)

LEGEND

N.F. = NEAR FACE
F.F. = FAR FACE
E.F. = EACH FACE

NOTES:

1.) ALL DIMENSIONS ARE IN MILLIMETERS.
2.) SEE SHEET 2/13 FOR GENERAL NOTES.
3.) SEE SHEET 11/13 FOR REINFORCING STEEL.
4.) SEE SHEETS 12/13, 13/13 FOR SCREED ELEVATIONS.
5.) SEE SHEET 9/13 FOR CAMBER DIAGRAM SHOWING ANTICIPATED DECK THICKNESS OVER BEAMS.
6.) SEE SHEET 10/13 FOR DECK PLAN AND TRANSITION BARRIER PLAN AND ELEVATION.

AS–BUILT DRAWINGS 11/97

DESIGN AGENCY
Gannett Fleming Corddry & Carpenter
ENGINEERS AND PLANNERS
BLENDONVIEW OFFICE PARK
5015 PINE CREEK DR., COLUMBUS, OHIO 43081

DESIGNED JR
DRAWN WSM
CHECKED JR
REVIEWED
DATE
REVISED
REVISED
STRUCTURE FILE NUMBER 4300912(L) 4300920(R)

DECK SECTION
BRIDGE NO. LAK – 2 – 12.231
S.R. 2 OVER NEWELL CREEK

LAK–2–12.231
(L. AND R.)

11/13

41/43

FILE: e:\projects\31339\600\lk2dks11.dgn
DATE: 05-Feb-98 14:25