FED. AID PROJECT	STATE	ROUTE		40
2	OHIO			384

LAKE COUNTY
LAK-2-14.22

FOR ACCESS ROAD DETAILS
SEE SHEETS NO. 243 - 245

FOR SOD QUANTITY
SEE SHEET NO. 41

FOR SOD QUANTITY
SEE SHEET NO. 41

FOR LOCATION OF 6" (M-6.4(h)(c)),
SEE CROSS-SECTIONS.

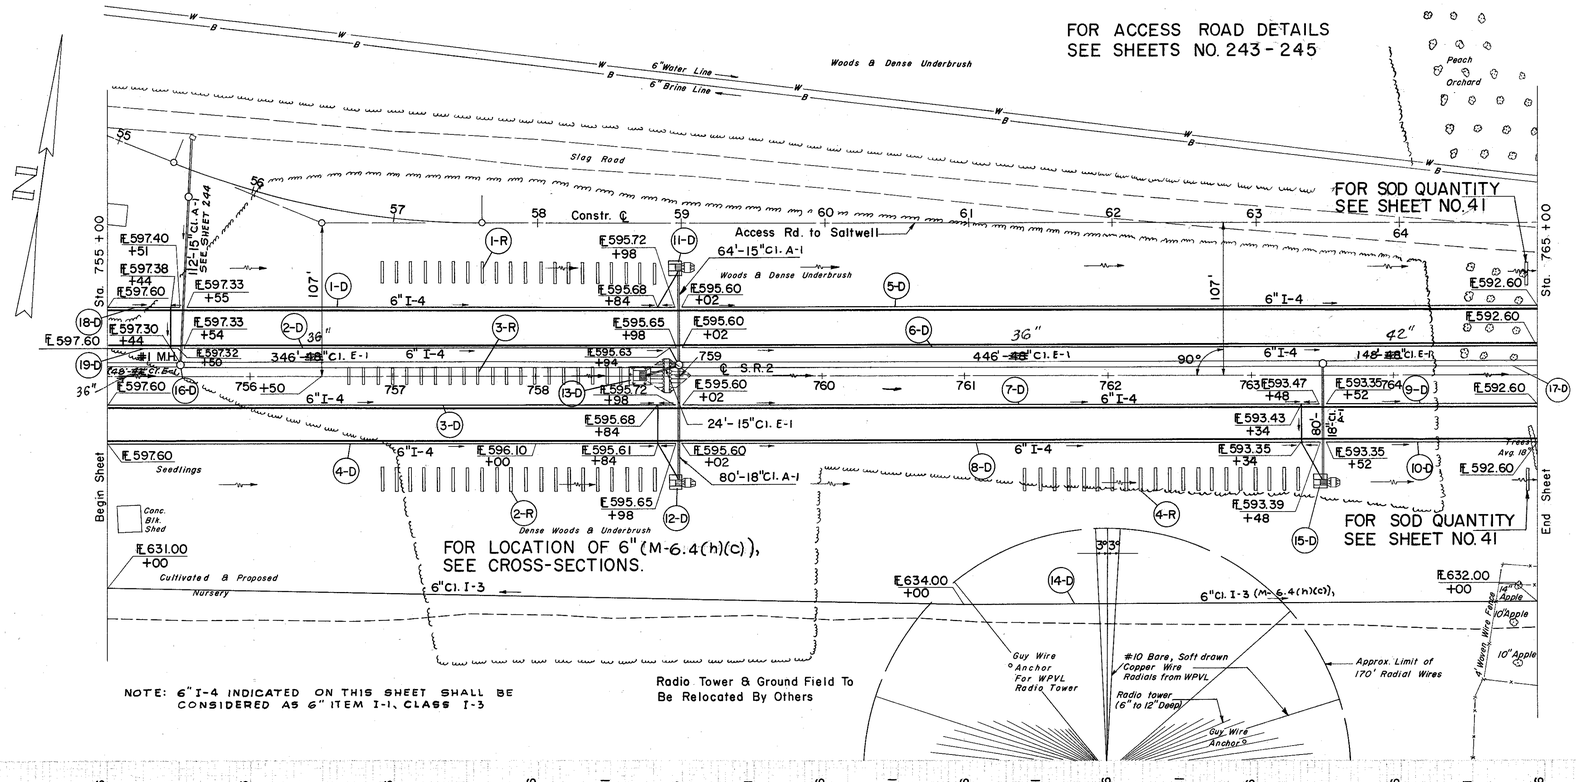

NOTE: 6" I-4 INDICATED ON THIS SHEET SHALL BE CONSIDERED AS 6" ITEM I-1, CLASS I-3

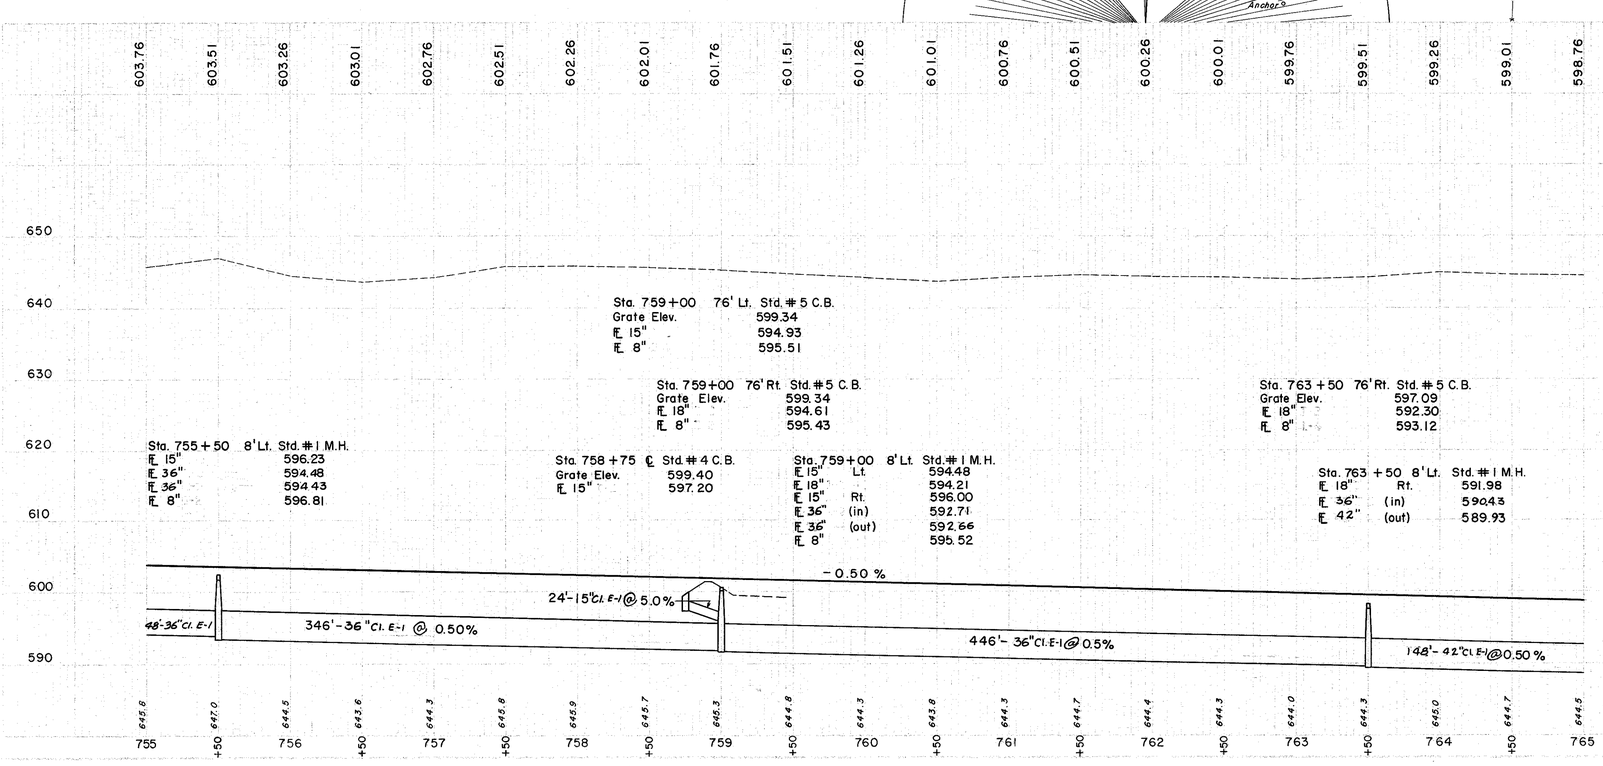

(D) DRAINAGE

REF. NO.	STATION FROM	STATION TO	S I D E	PIPE CL. E-1 42"	PIPE CL. A-1 15"	PIPE CL. A-1 18"	6" PIPE CLASS I-3 DEEP M-6.4(h)(c)	8" CL. F-1. PIPE 60° BEND	I-5 FOR CL. I-3 PIPE 8" 6"x8" 60° TEE	8" 6"x8" 60° WYE	8" 6"x8" INCR. TEE	I-8 STD. #1 M.H. EA.	STD. #4 C.B.	STD. #5 C.B.
1-D	755+65	758+98	Lt.			357	10							3
2-D	755+54	758+98	Lt.			344	10							3
3-D	755+00	758+98	Rt.		22	394		10		1			1	
4-D	755+00	758+98	Rt.		16	394								
5-D	759+02	765+00	Lt.			598								
6-D	759+02	765+00	Lt.			598								
7-D	759+02	763+48	Rt.		22	442		10		1				
8-D	759+02	763+48	Rt.		16	442								
9-D	763+52	765+00	Rt.			148								
10-D	763+52	765+00	Rt.			148								
11-D	759+00		Lt.			64	80							
12-D	759+00		Rt.											
13-D	758+75		℄	24										
14-D	755+00	765+00	Rt.				1000							
15-D	763+50		Rt.			80								
16-D	755+00	763+50	Lt.	840										
17-D	763+50	765+00	Lt.		148									
18-D	755+00	755+51	Lt.											
19-D	755+00	755+50	Lt.		22		47	10						
		TOTAL		24	8	106	46	1						
				840		64	3,958	50	3	2	3	2	1	3
				148		160	1,000							

(R) ROADWAY

REF. NO.	STATION FROM	STATION TO	S I D E	L-10 SODDING S.Y.
1-R	759+00		Lt.	56
2-R	759+00		Rt.	56
3-R	758+75		℄	54
4-R	763+50		Rt.	56
		TOTAL		222

EXCAVATION	346,398 C.Y.
EMBANKMENT	0 C.Y.
ENBANKMENT 20	0 C.Y.

Rev. 6-23-61

STA. 755+00 TO STA. 765+00

Drainage Only - LGL-4-1-60