


SEEDING
END SQ.
WIDTH YDS.

LAKE COUNTY
LAK-2-14.22

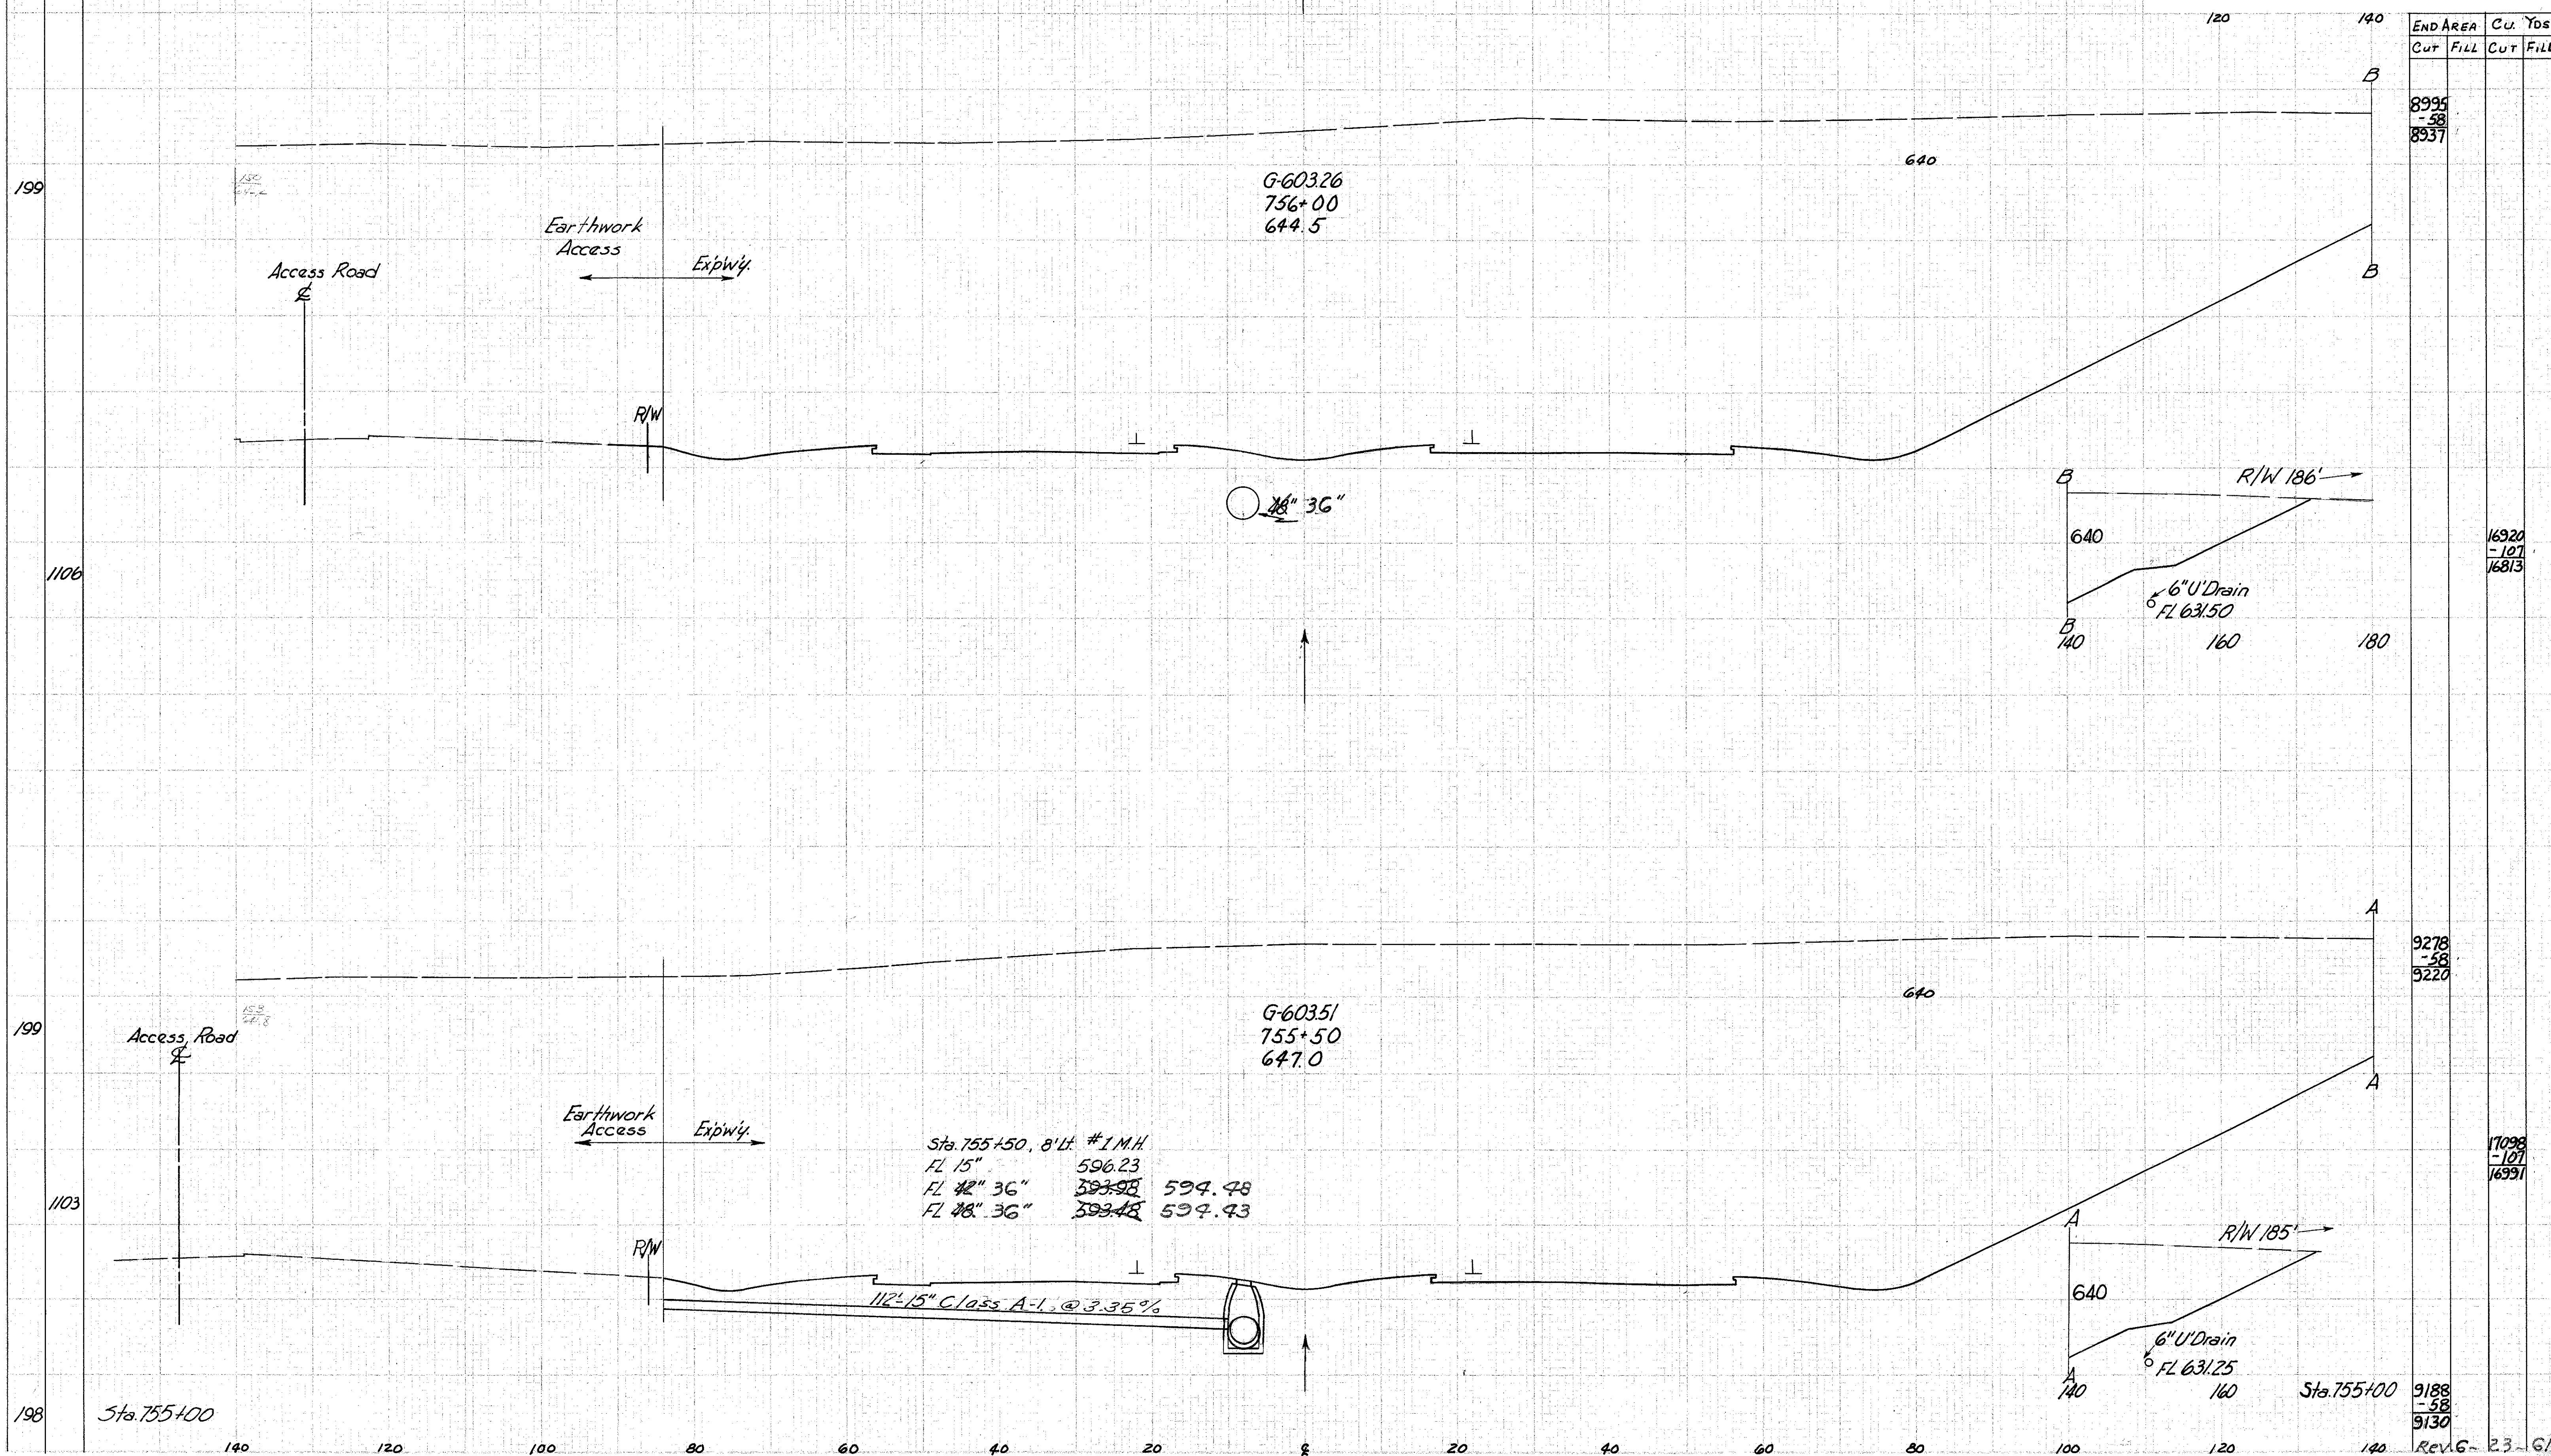

END AREA		Cu. Yds.	
Cut	Fill	Cut	Fill
8995	-58		
8937			

16920	-107
16813	

9278	-58
9220	

17098	-107
16991	

9188	-58
9130	

Sta. 755+50, 8' Lt. #1 M.H.
 FL 15" 596.23
 FL 42" 36" ~~593.98~~ 594.48
