


Seeding
End Width
Sq. Yds.

LAKE COUNTY
LAK-2-14.22

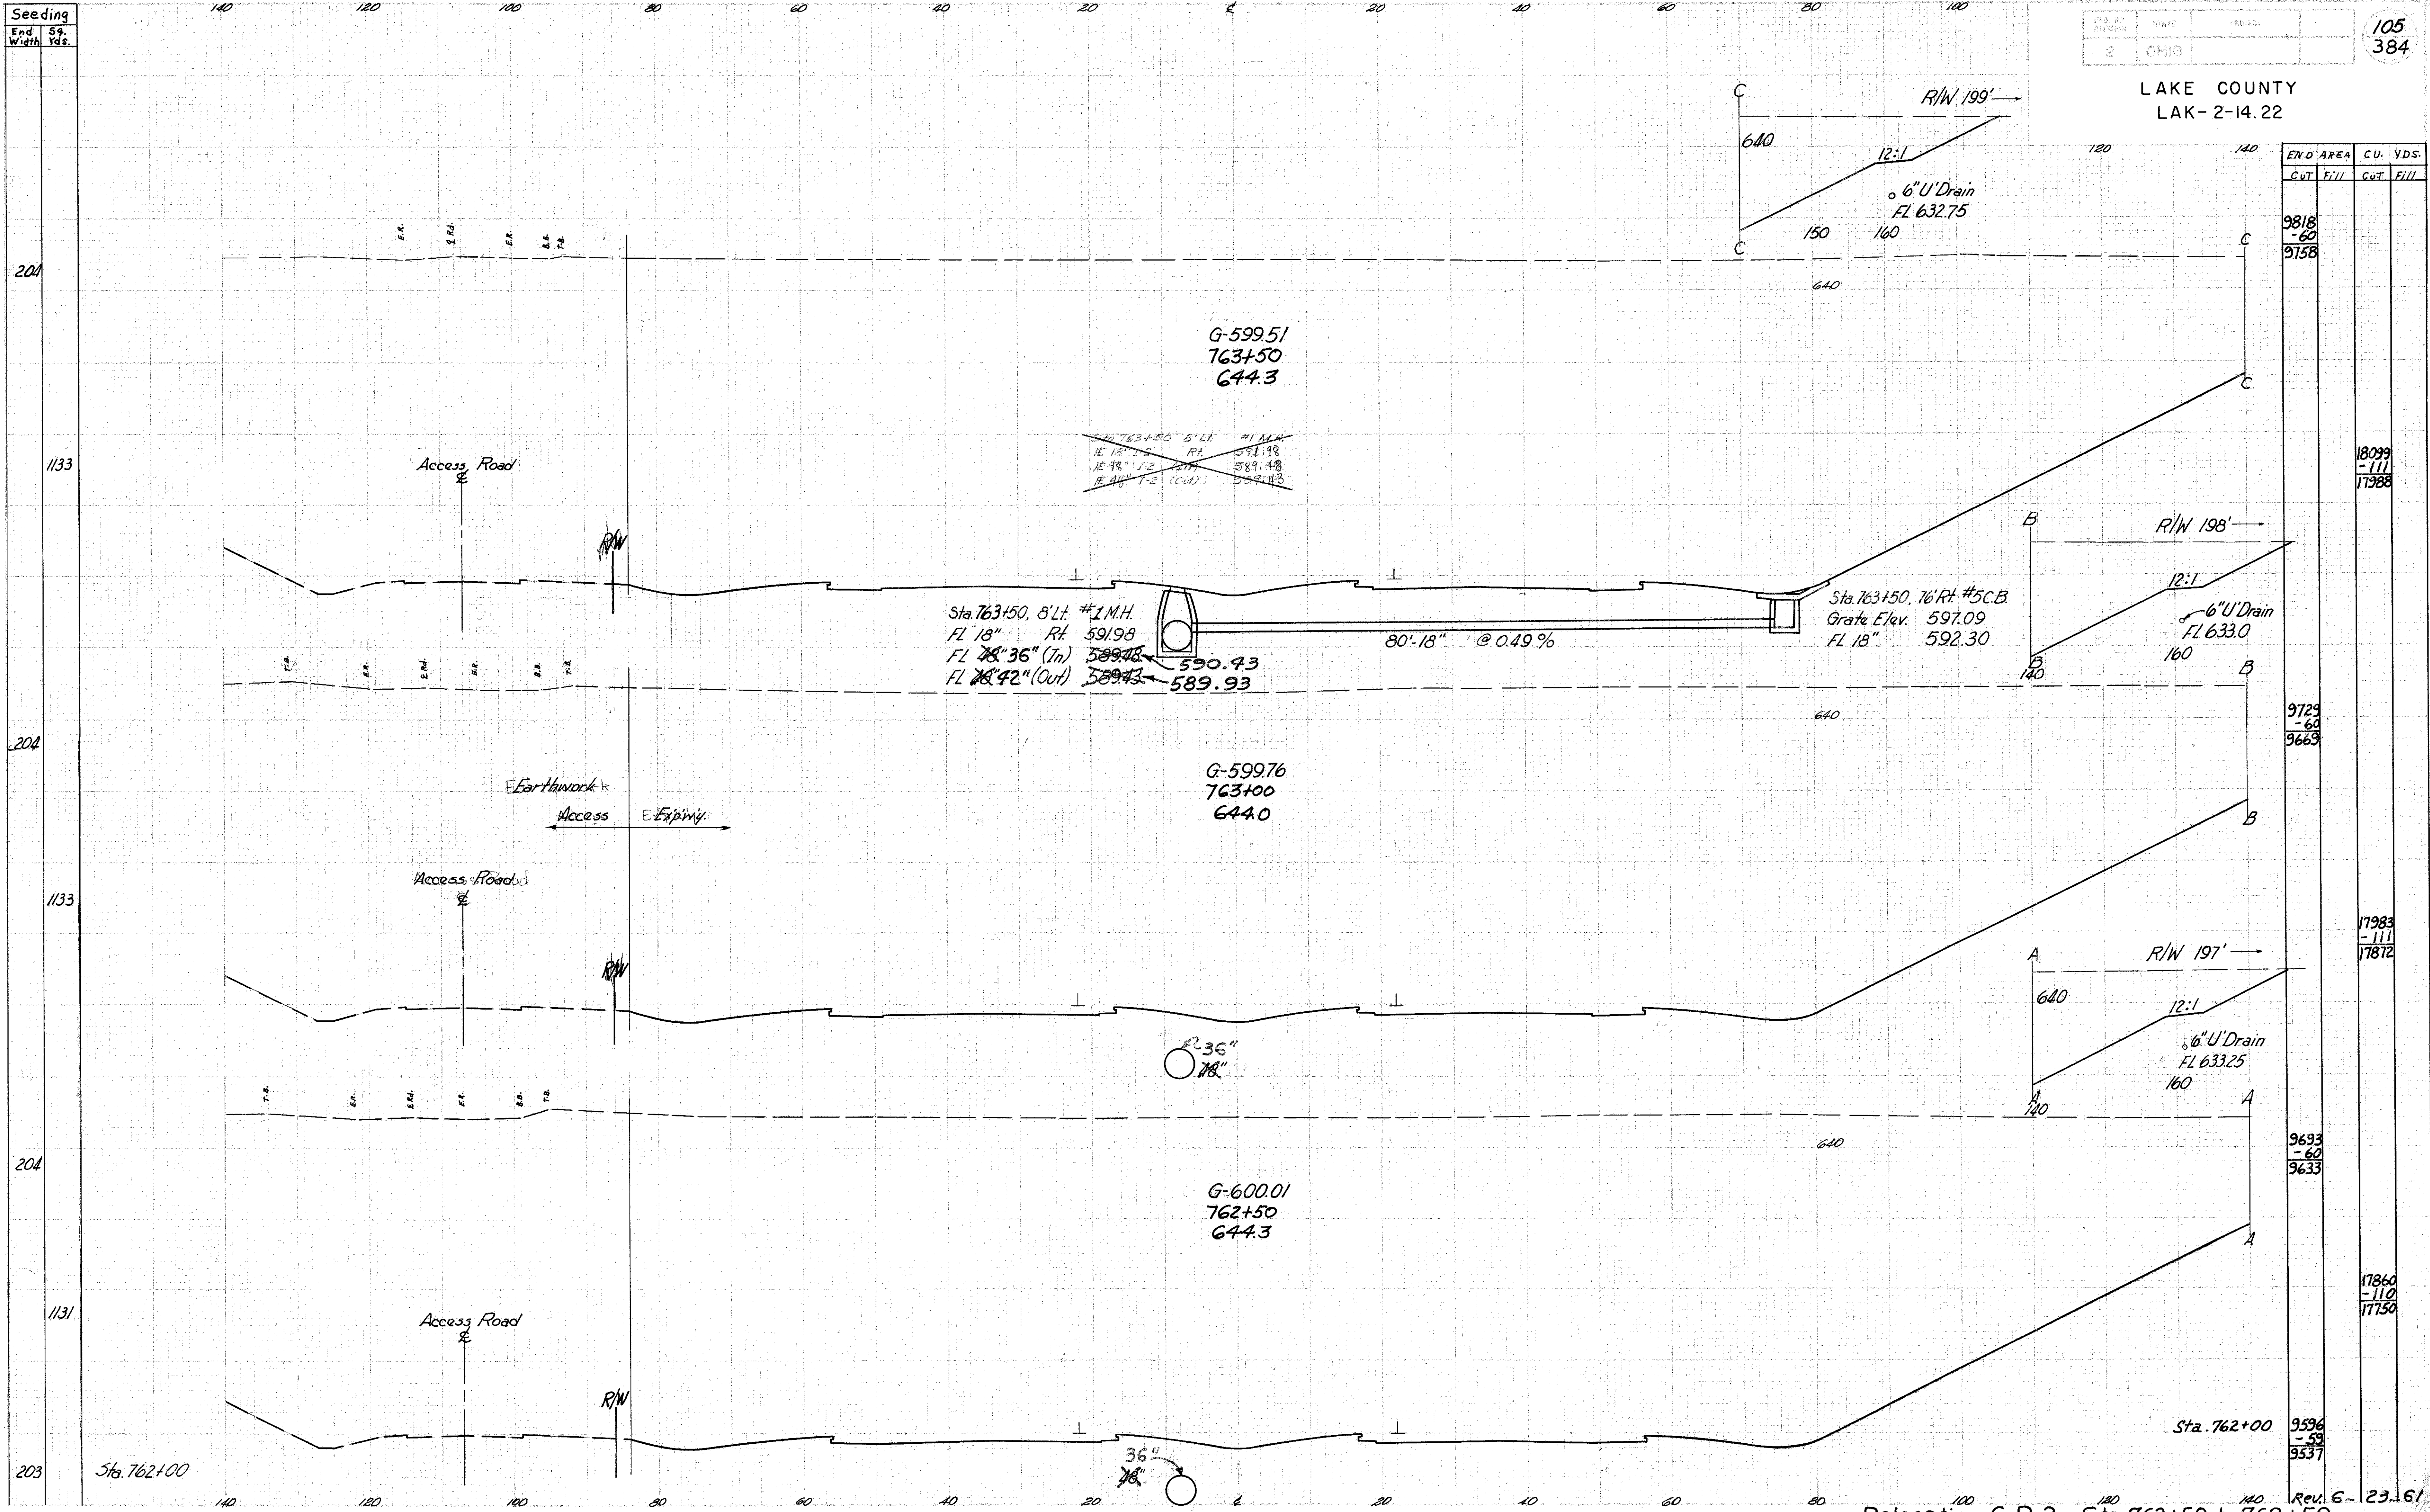

G-599.51
763+50
644.3

~~Sta. 763+50 6' L.A. #1 M.H.
FL 18" RT 591.98
FL 18" 1/2 (In) 589.48
FL 18" 1/2 (Out) 589.43~~

Sta. 763+50, 8' L.A. #1 M.H.
FL 18" RT 591.98
FL 18" 36" (In) 589.48
FL 18" 42" (Out) 589.43

80'-18" @ 0.49%

Sta. 763+50, 76' RT #5 C.B.
Grate Elev. 597.09
FL 18" 592.30

G-599.76
763+00
644.0

FL 36"
78"

G-600.01
762+50
644.3

Sta. 762+00
9596
-59
9537

END AREA	C.U. VDS.
Cut	Fill
9818.60	
9758	
	18099
	-111
	17988
9729.60	
9669	
	17983
	-111
	17872
9693.60	
9633	
	17860
	-110
	17750
9596.59	
9537	