

S.R. 2  
 CURVE DATA No. 1  
 P.I. Sta. 674+94.54  
 $\Delta = 33^\circ 18' 45''$  Lt.  
 $D = 1^\circ 15' 00''$   
 $R = 4,583.66'$   
 $L = 2,665.01'$   
 $T = 1,371.35'$   
 $E = 200.74'$   
 Chord =  $N. 53^\circ 26' 42.5'' E.$   
 2627.62'

Lake County  
 T. 11 N.  
 City of Painesville  
 Painesville Township  
 R. 8 W.


FED. RD. DIVISION	STATE	PROJECT
2	OHIO	

365  
 384

LAK - 2 - 14.22  
 R/W PLAN  
 LIMITED ACCESS

PAINESVILLE TOWNSHIP

LOT II TRACT 4

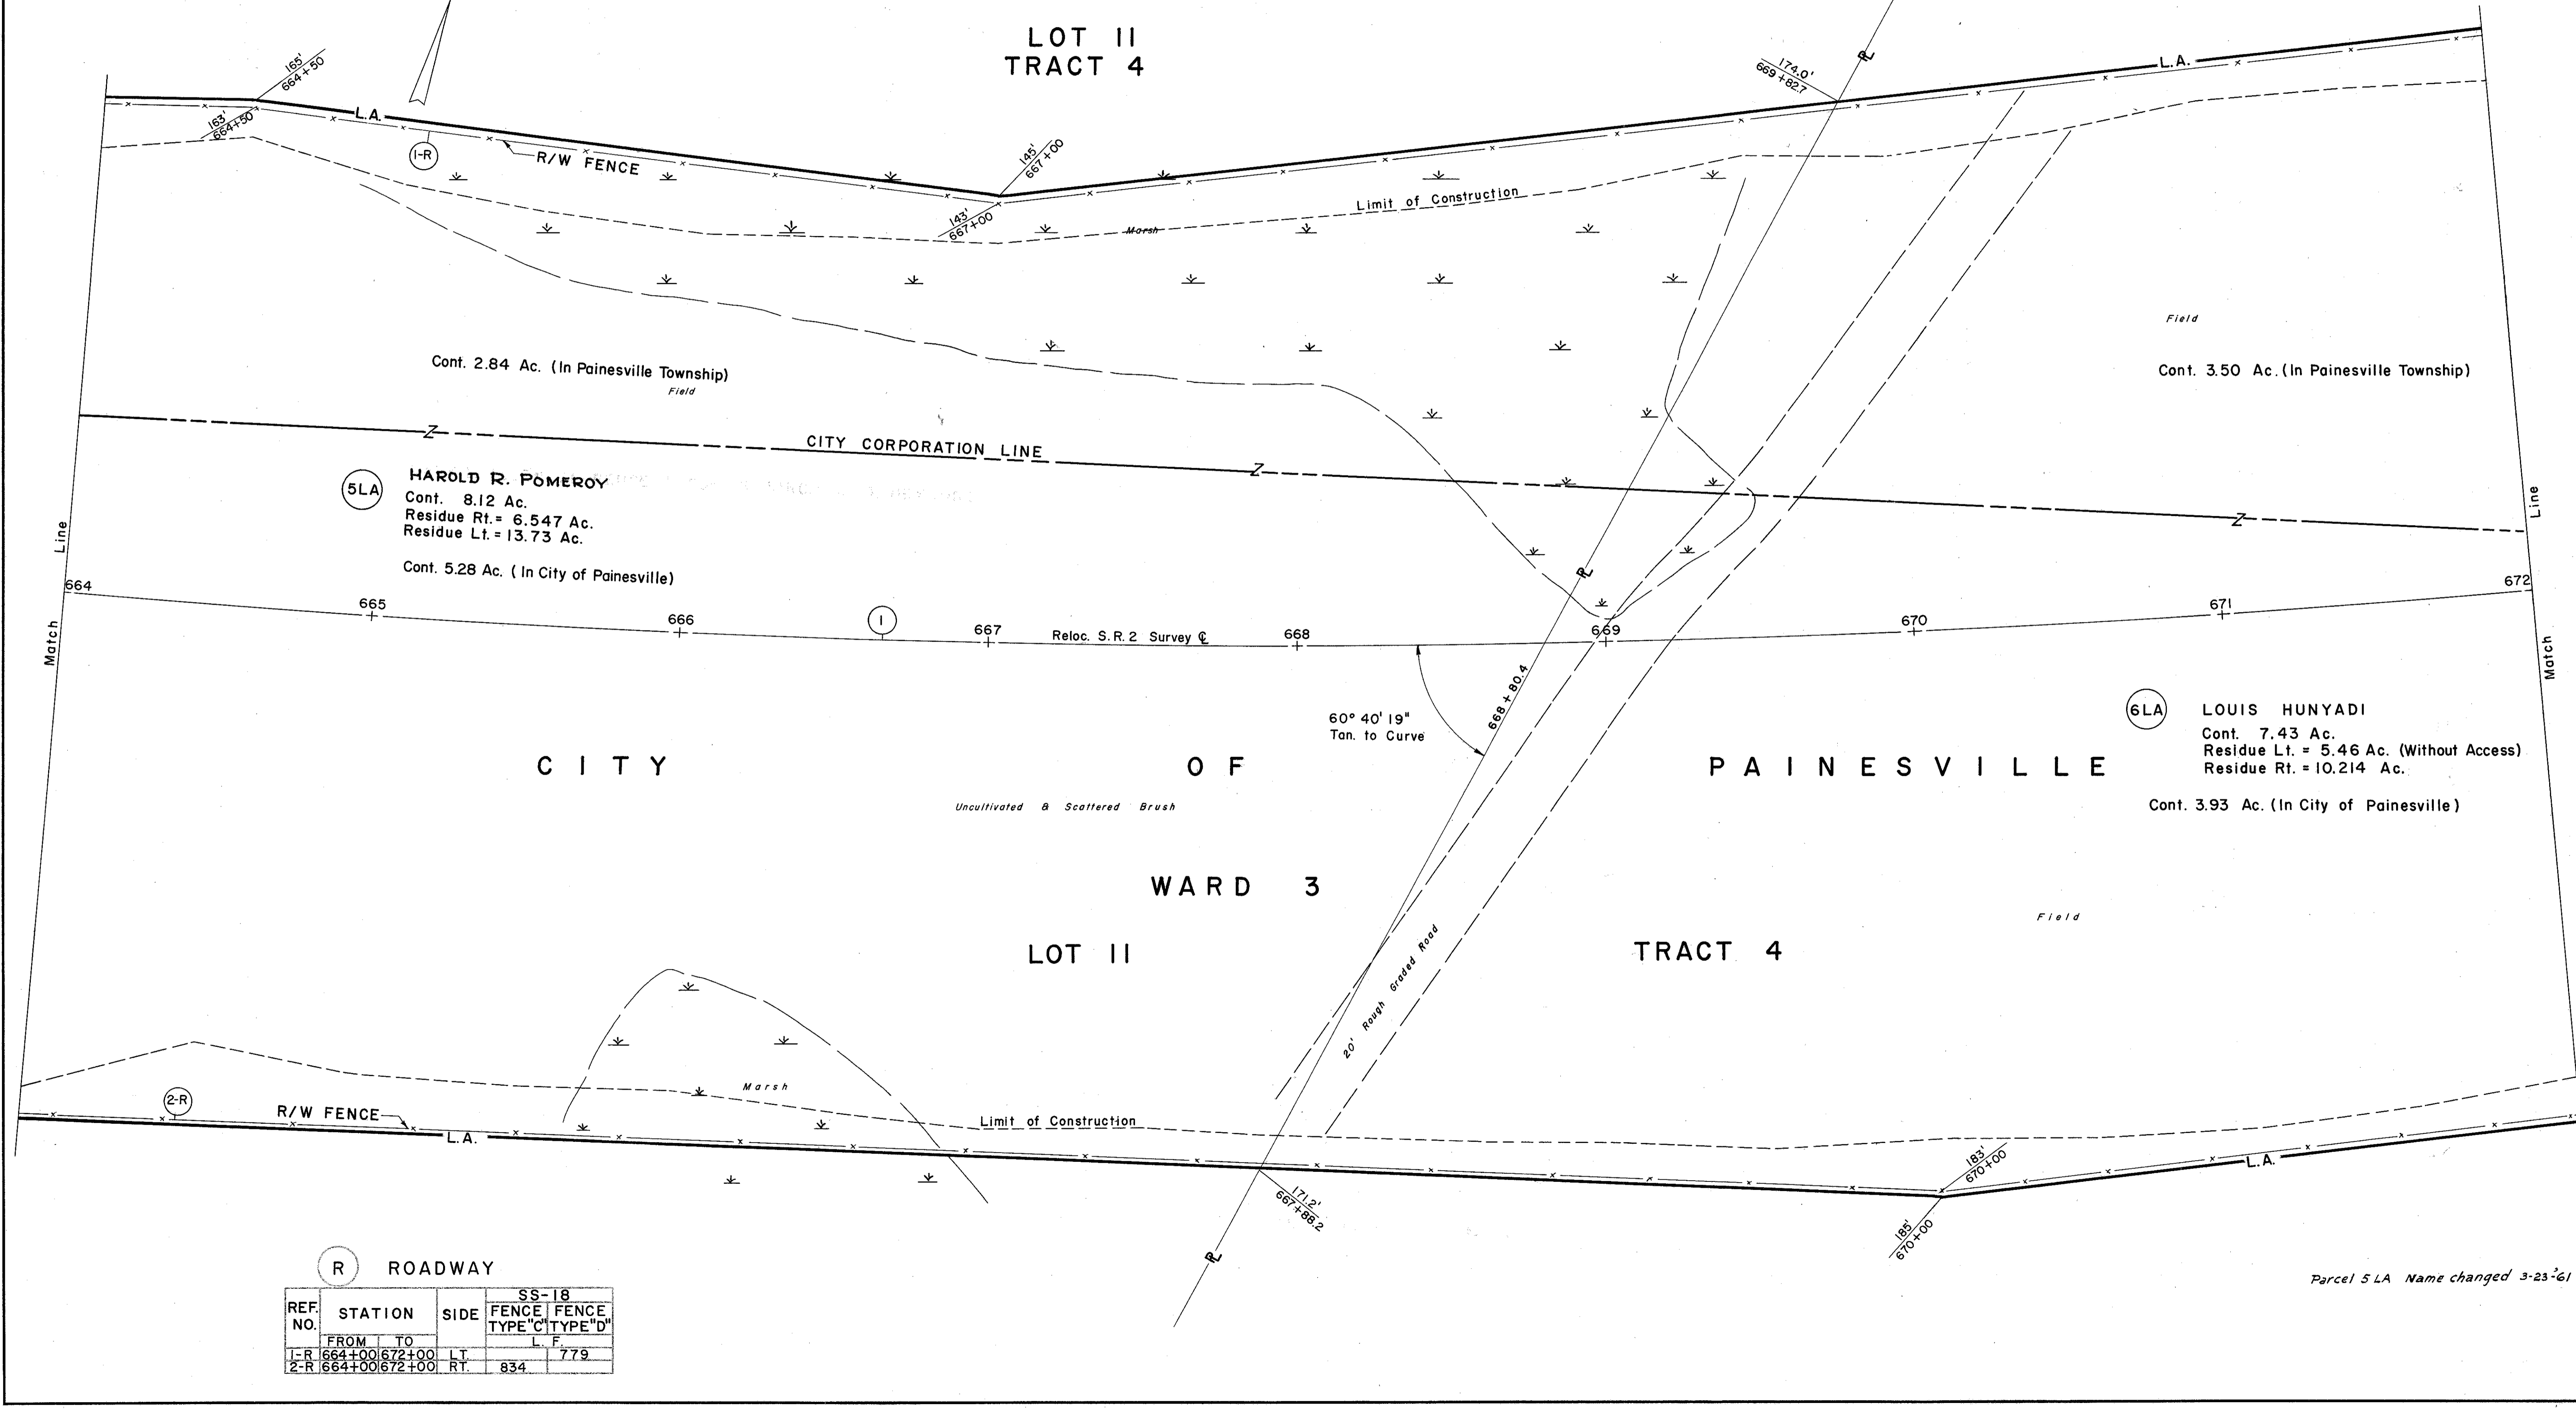

(R) ROADWAY

REF. NO.	STATION		SIDE	SS-18	
	FROM	TO		FENCE TYPE "C"	FENCE TYPE "D"
1-R	664+00	672+00	LT.	L.F.	779

Parcel 5 LA Name changed 3-23-61