


SEEDING	END SQ.
WIDTH	YDS.

53
313

LAKE COUNTY
LAK-2-16.49

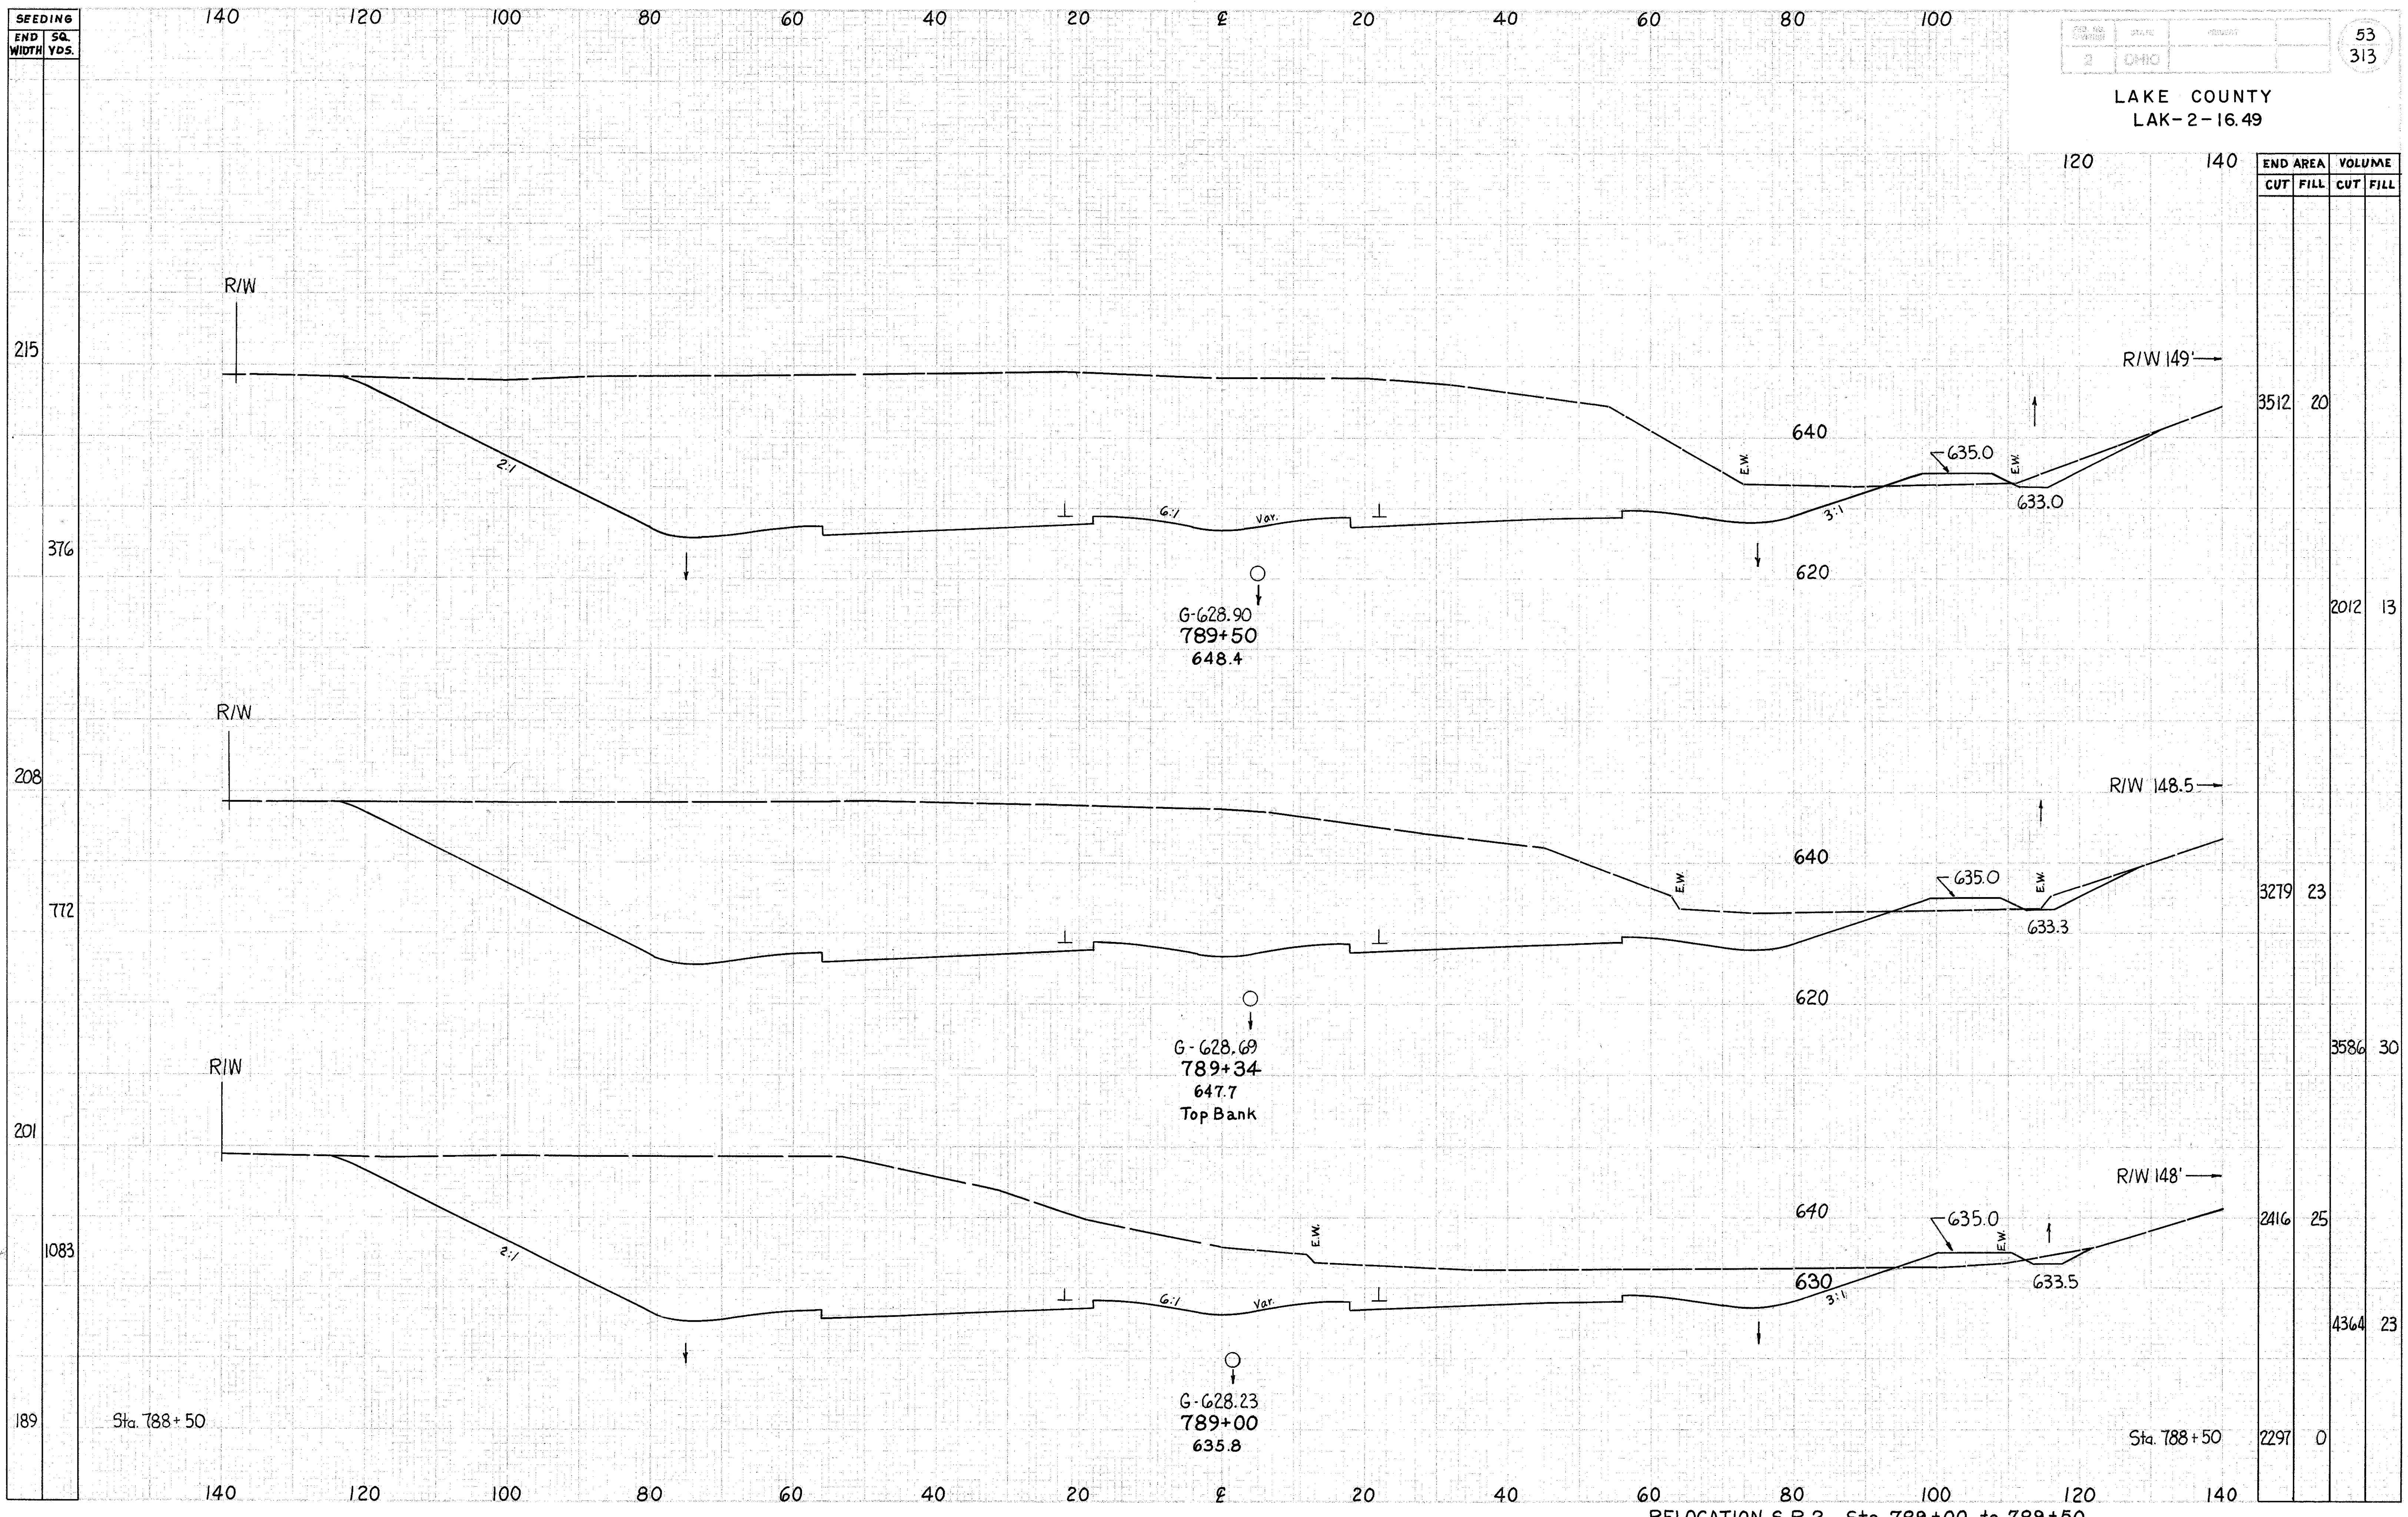

END AREA	VOLUME	
	CUT	FILL
3512	20	
		2012
3219	23	
		3586
2416	25	
		4364
2297	0	

RELOCATION S.R.2 Sta. 789+00 to 789+50

10. 11/10/03
 ✓
 Rev. R.M.D.
 Sta. 788+50
 1/20/03
 1/20/03