
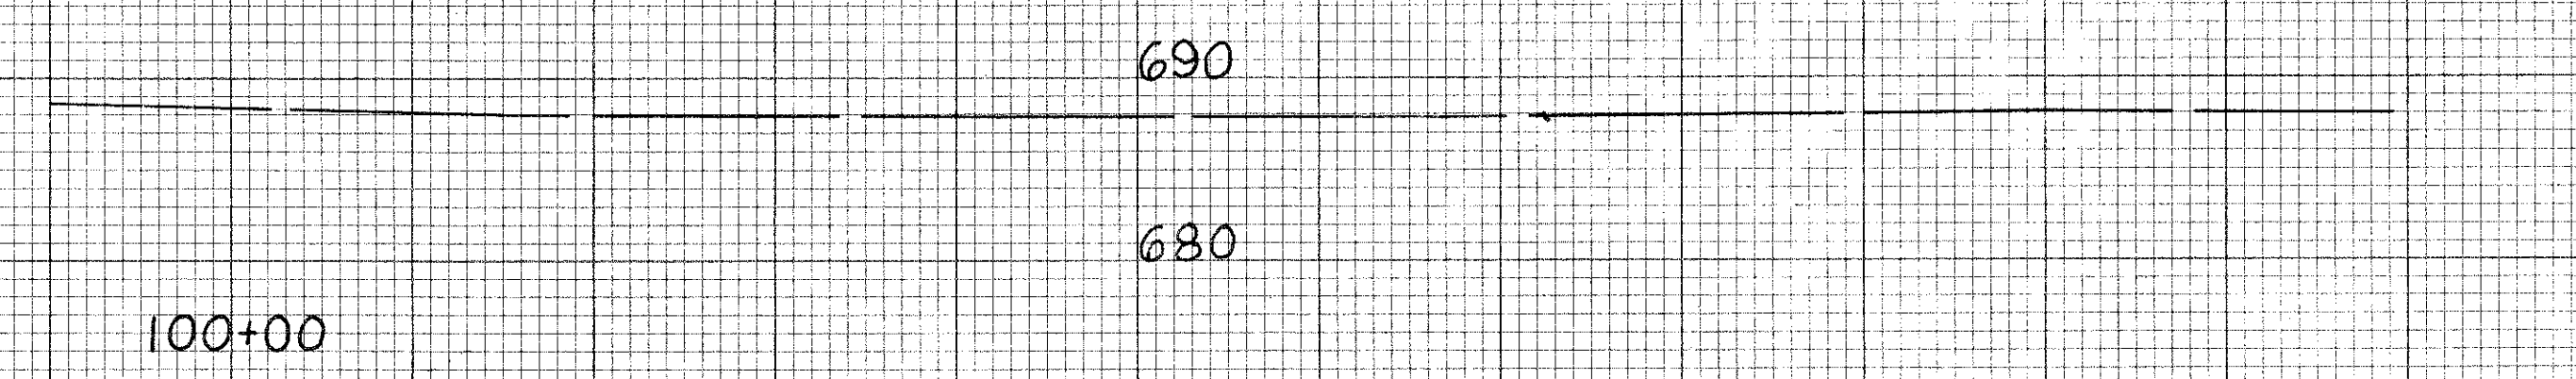
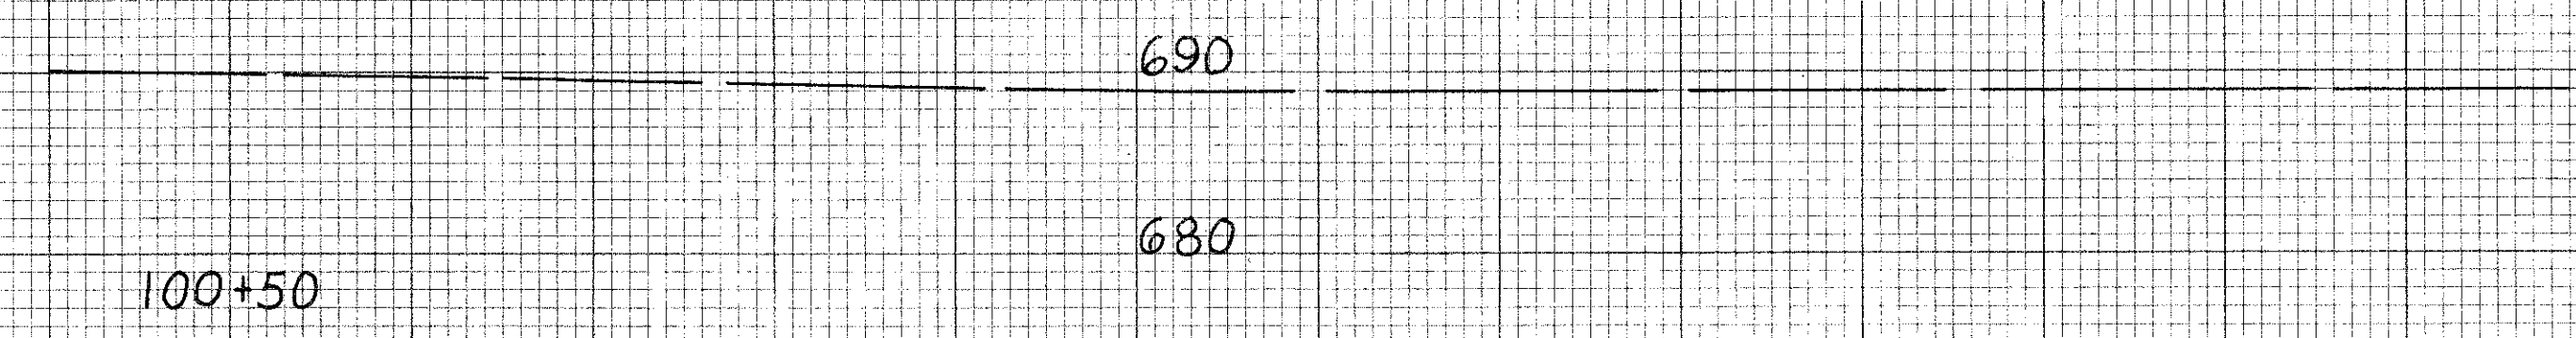
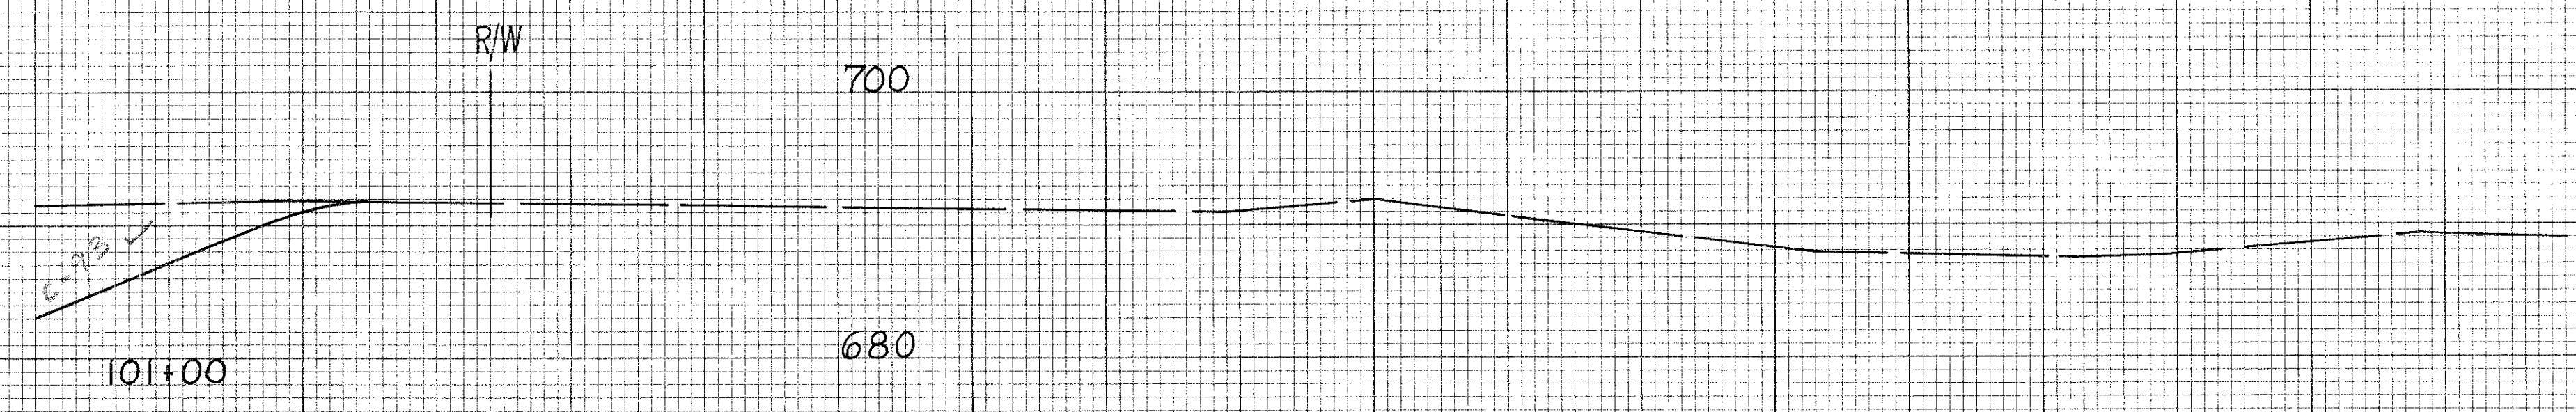


140 160 180 200 220 240 260 280 300

FED. RD. DIVISION	STATE	PROJECT	116 313
2	OHIO		

LAKE COUNTY
LAK-2-1649

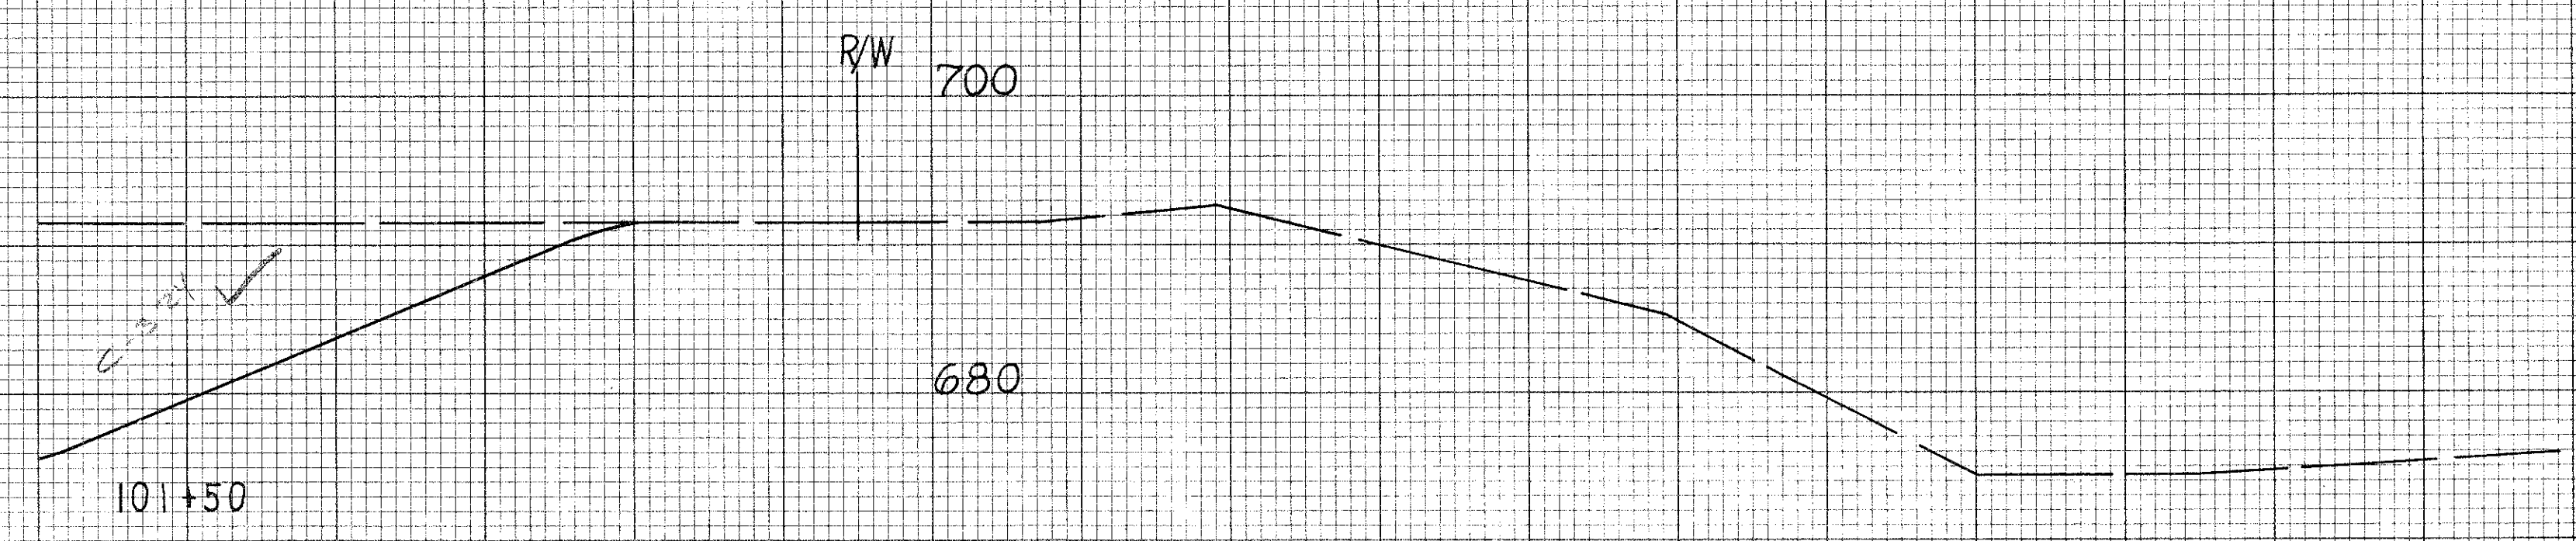

140 160 180 200 220 240 260 280 300