



SEEDING  
END SR.  
WIDTH YDS.

260 240 220 200 180 160 140 120 100 80 60 40

FED. RD. DIVISION	STATE	PROJECT	
2	OHIO	500-64	200-A 313


LAKE COUNTY  
LAK.-2-16.49

62  
100  
58  
686  
48  
378  
48

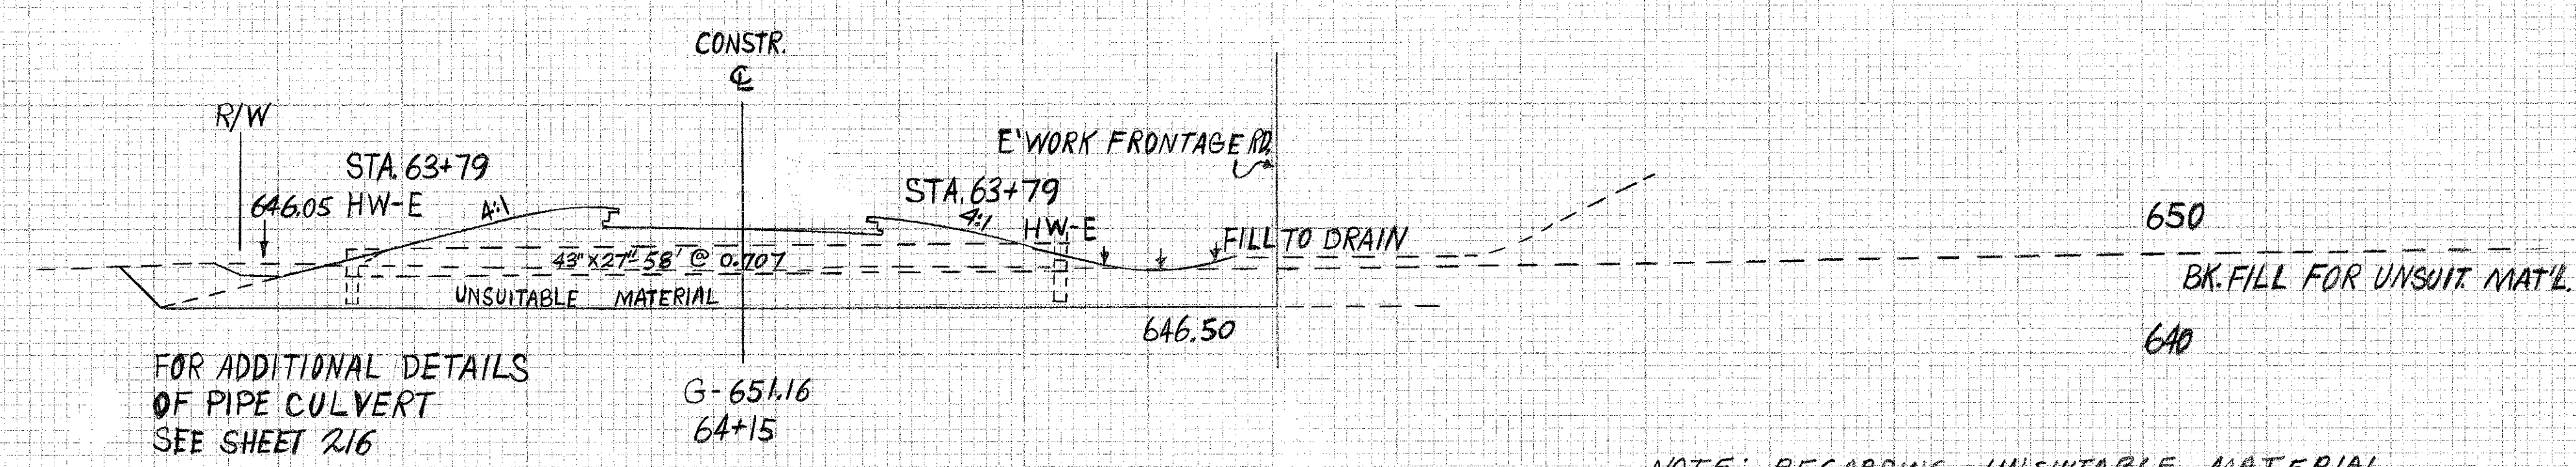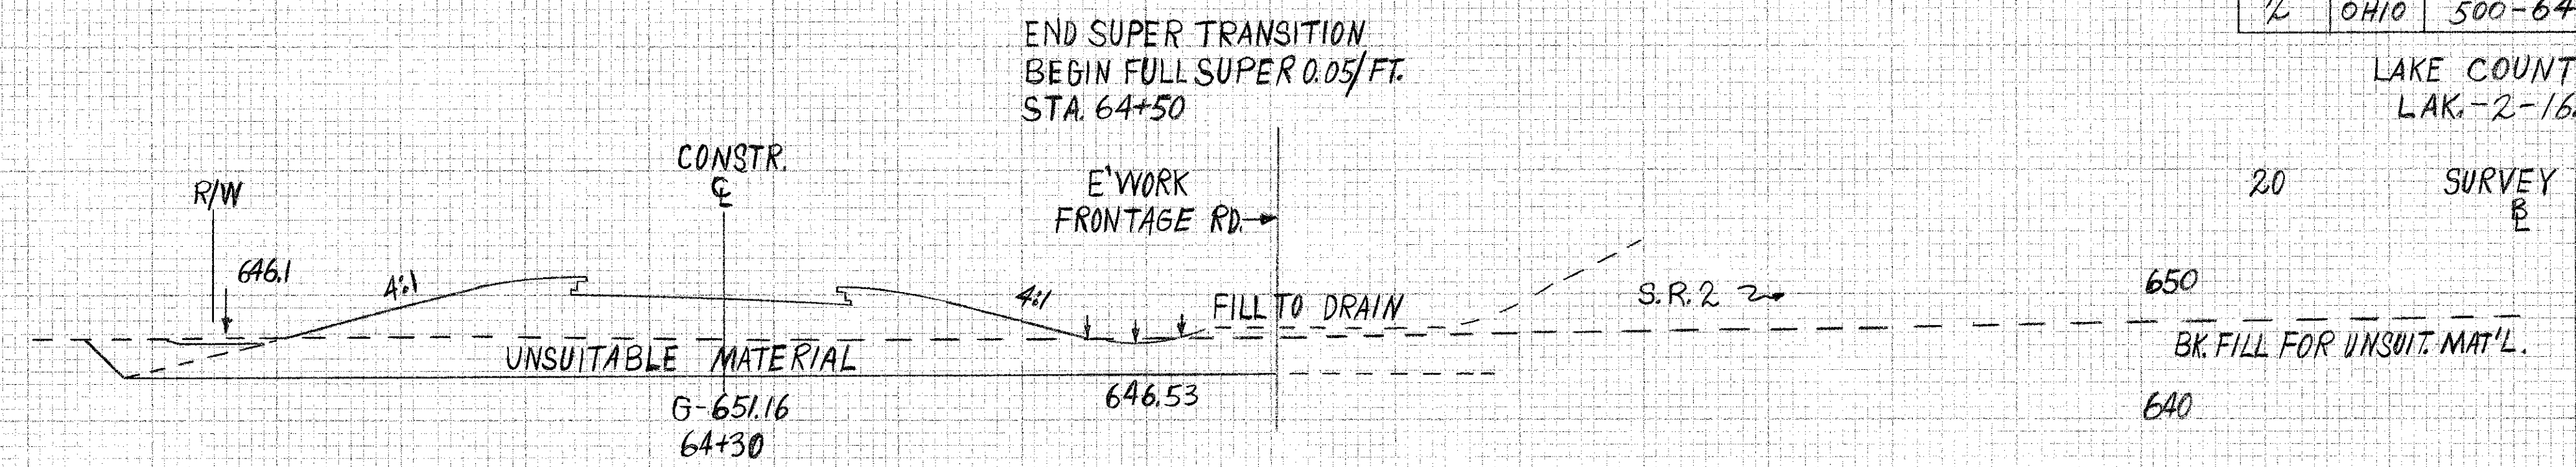


FOR ADDITIONAL DETAILS  
OF PIPE CULVERT  
SEE SHEET 216

NOTE: REGARDING UNSUITABLE MATERIAL,  
REFER TO TELETYPE MESSAGE  
DATED JAN. 11, 1965 RE: LAK-2-16.49

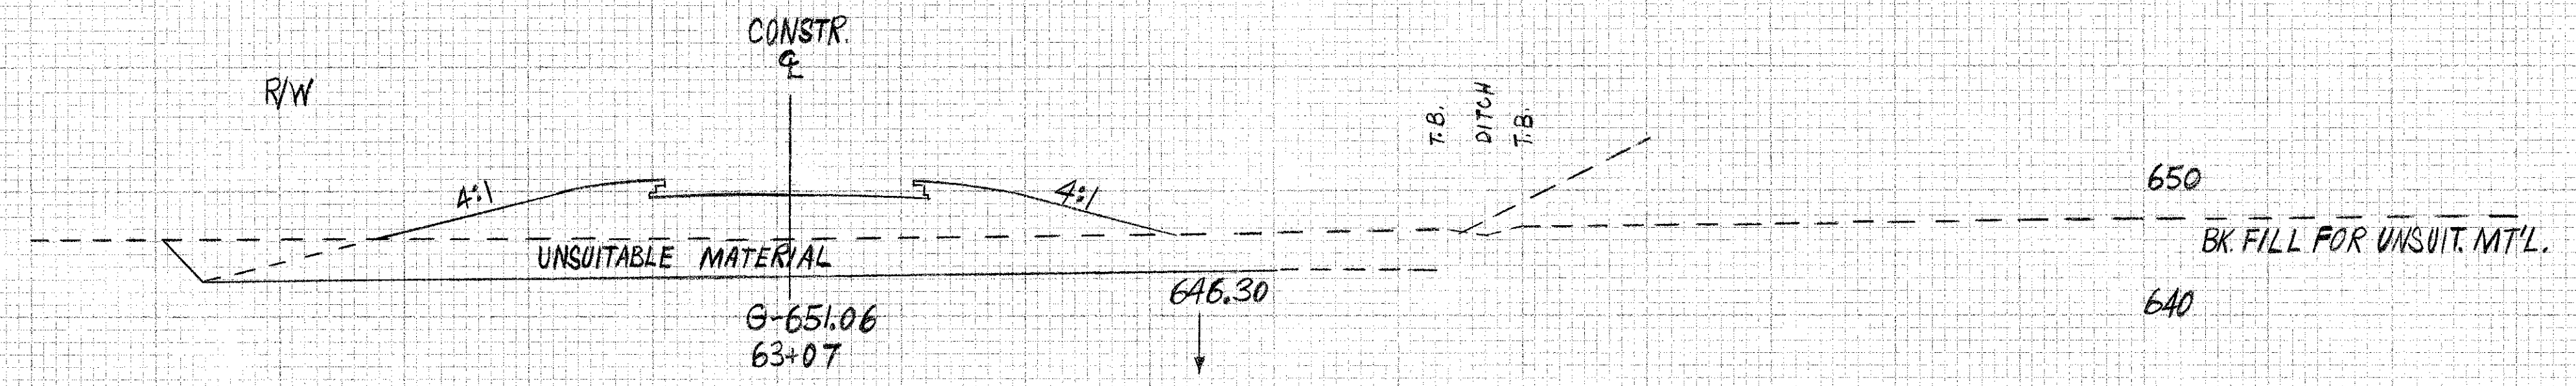

END NORMAL SECTION  
BEGIN SUPER TRANSITION  
STA. 62+65

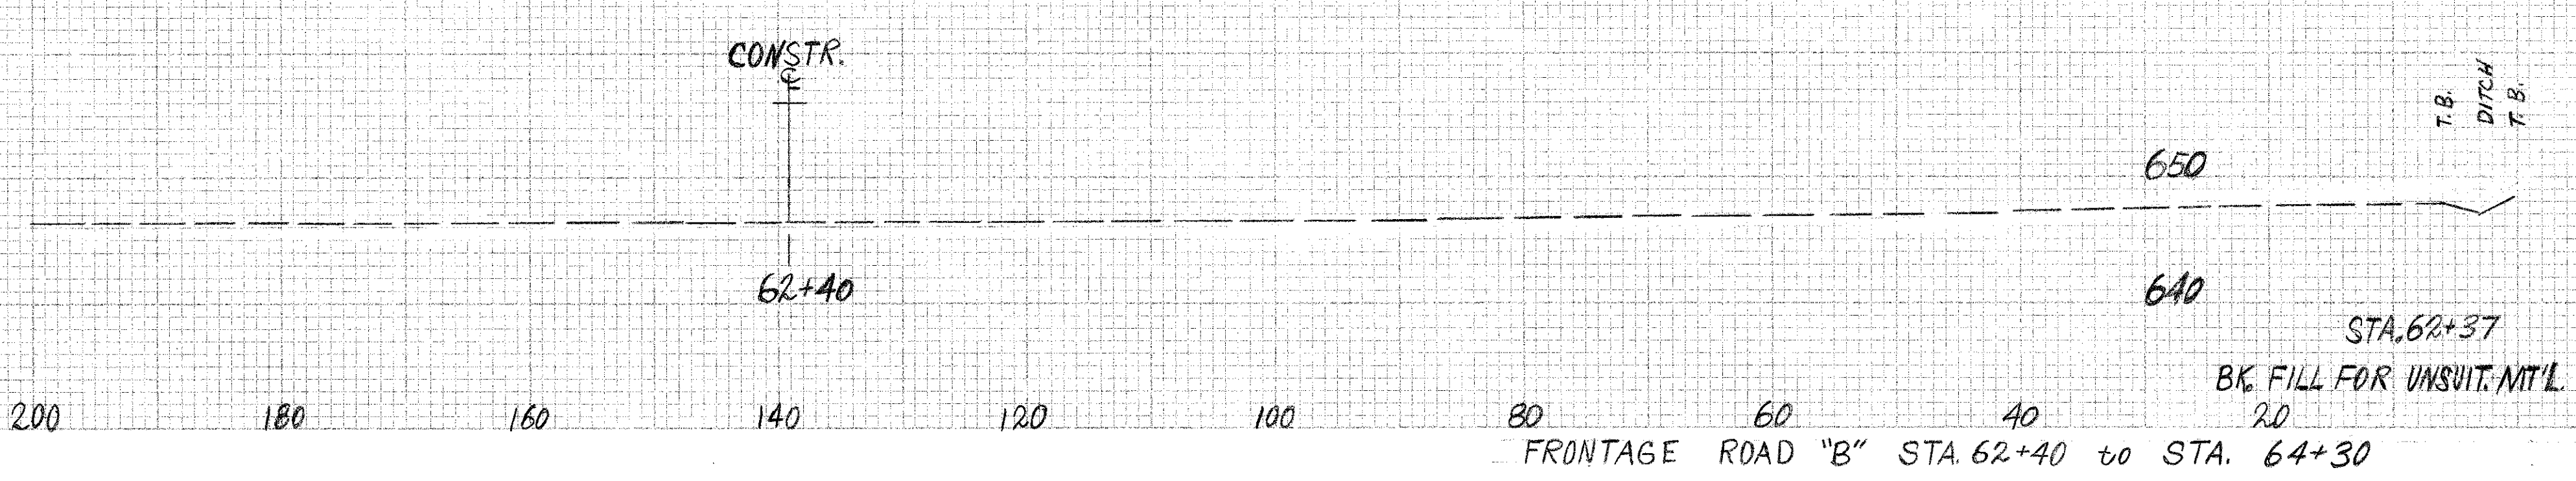

STA. 62+37

260 240 220 200 180 160 140 120 100 80 60 40 20

FRONTAGE ROAD "B" STA. 62+40 to STA. 64+30

END	AREA		VOLUME	
	CUT	FILL	CUT	FILL
289	193	284		
		477		
			166	268
308	182	327		
		489		
			1172	1906
278	197	277		
		474		
			700	1171
262	168	261		
		429		