

SEEDING
END
WIDTH YDS


52	82+77
156	
52	Sta. 82+50
162	
65	Sta. 82+25
344	
64	Sta. 81+77

FED. RD. DIVISION	STATE	PROJECT	209 313
2	OHIO		

LAKE COUNTY
LAK-2-16.49

END AREA		VOLUME	
CUT	FILL	CUT	FILL

See Sheet 115 for Frontage Road "B"
X Sections Ahead.

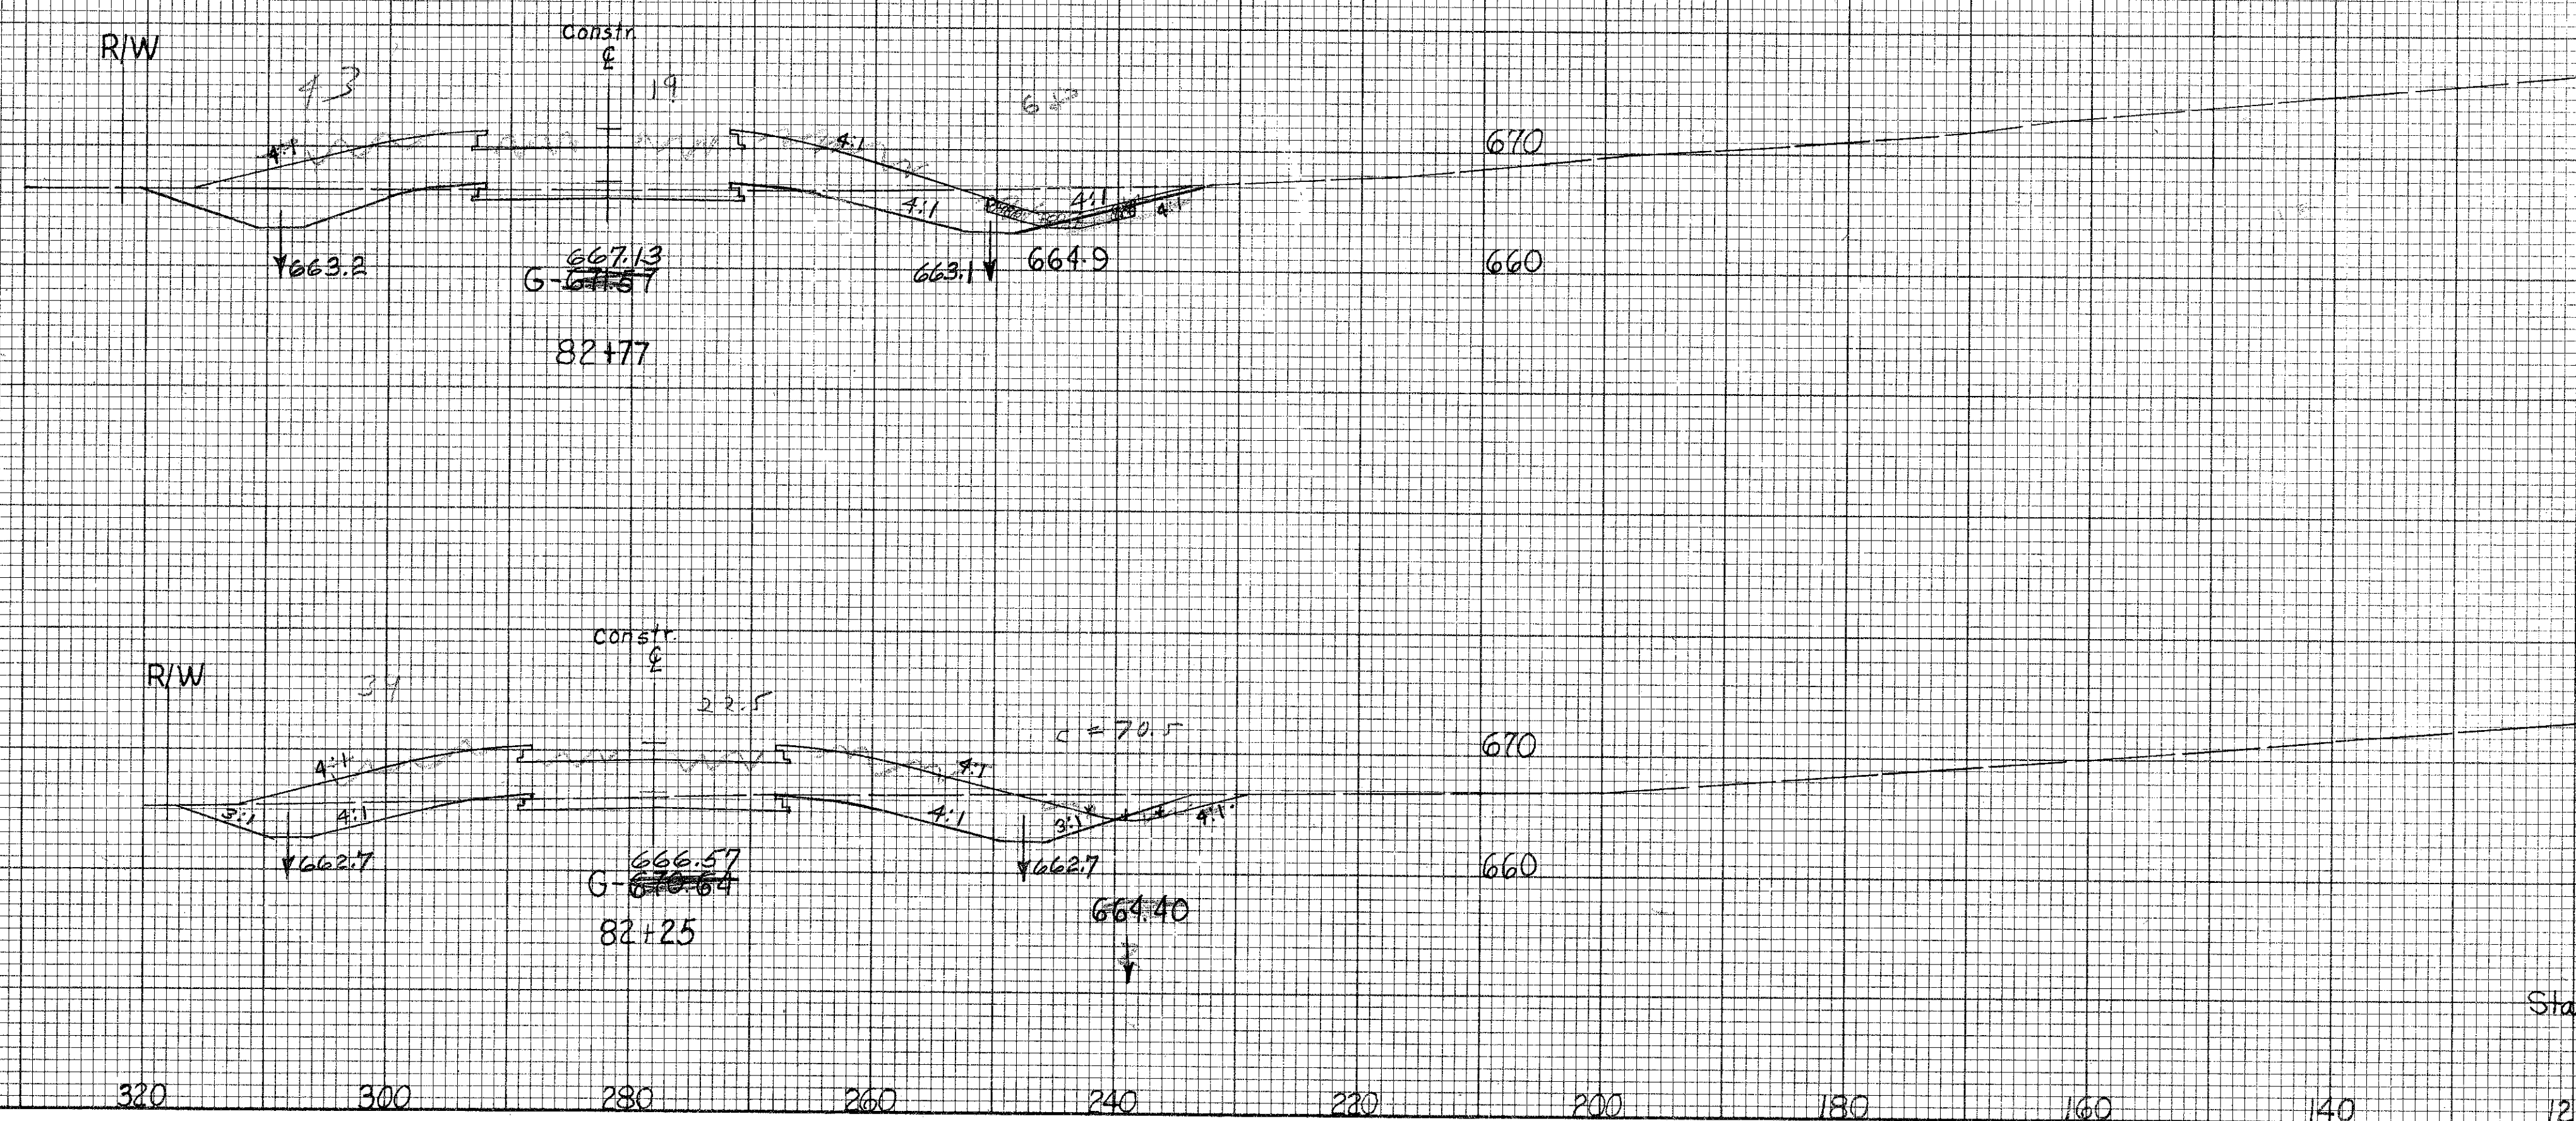

130	203	4	
252	45	383	6
132	24	174	2
263	59	257	2
164	42	175	0
515			3

FRONTAGE ROAD "B" Sta. 82+25 to 82+77