
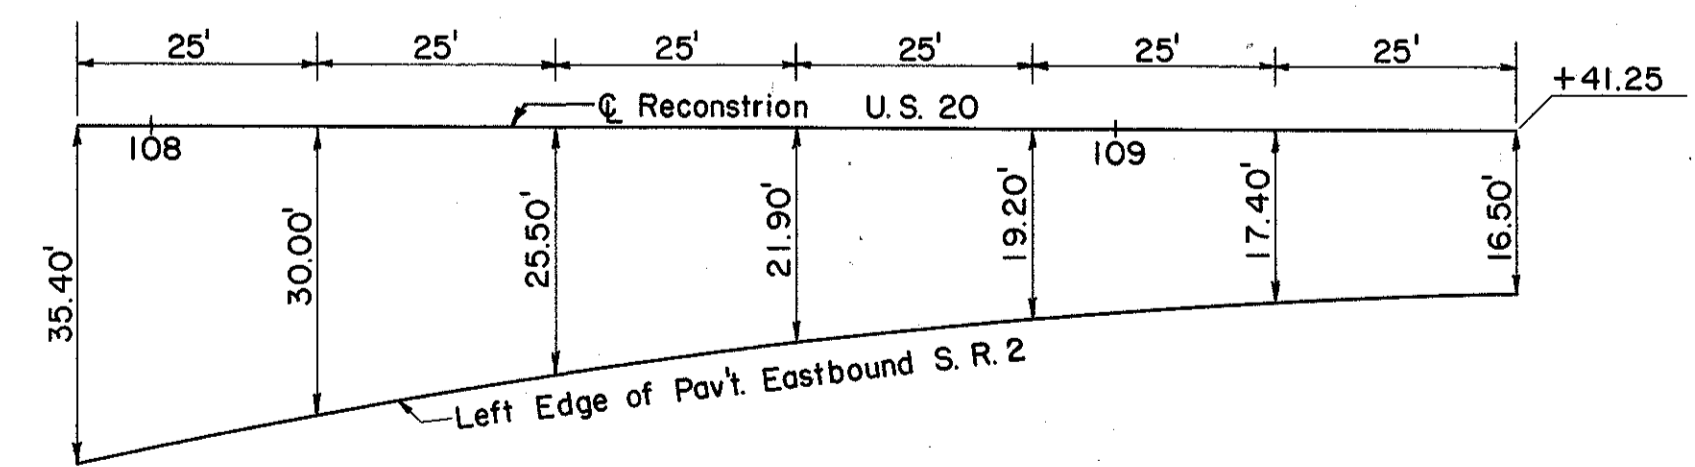
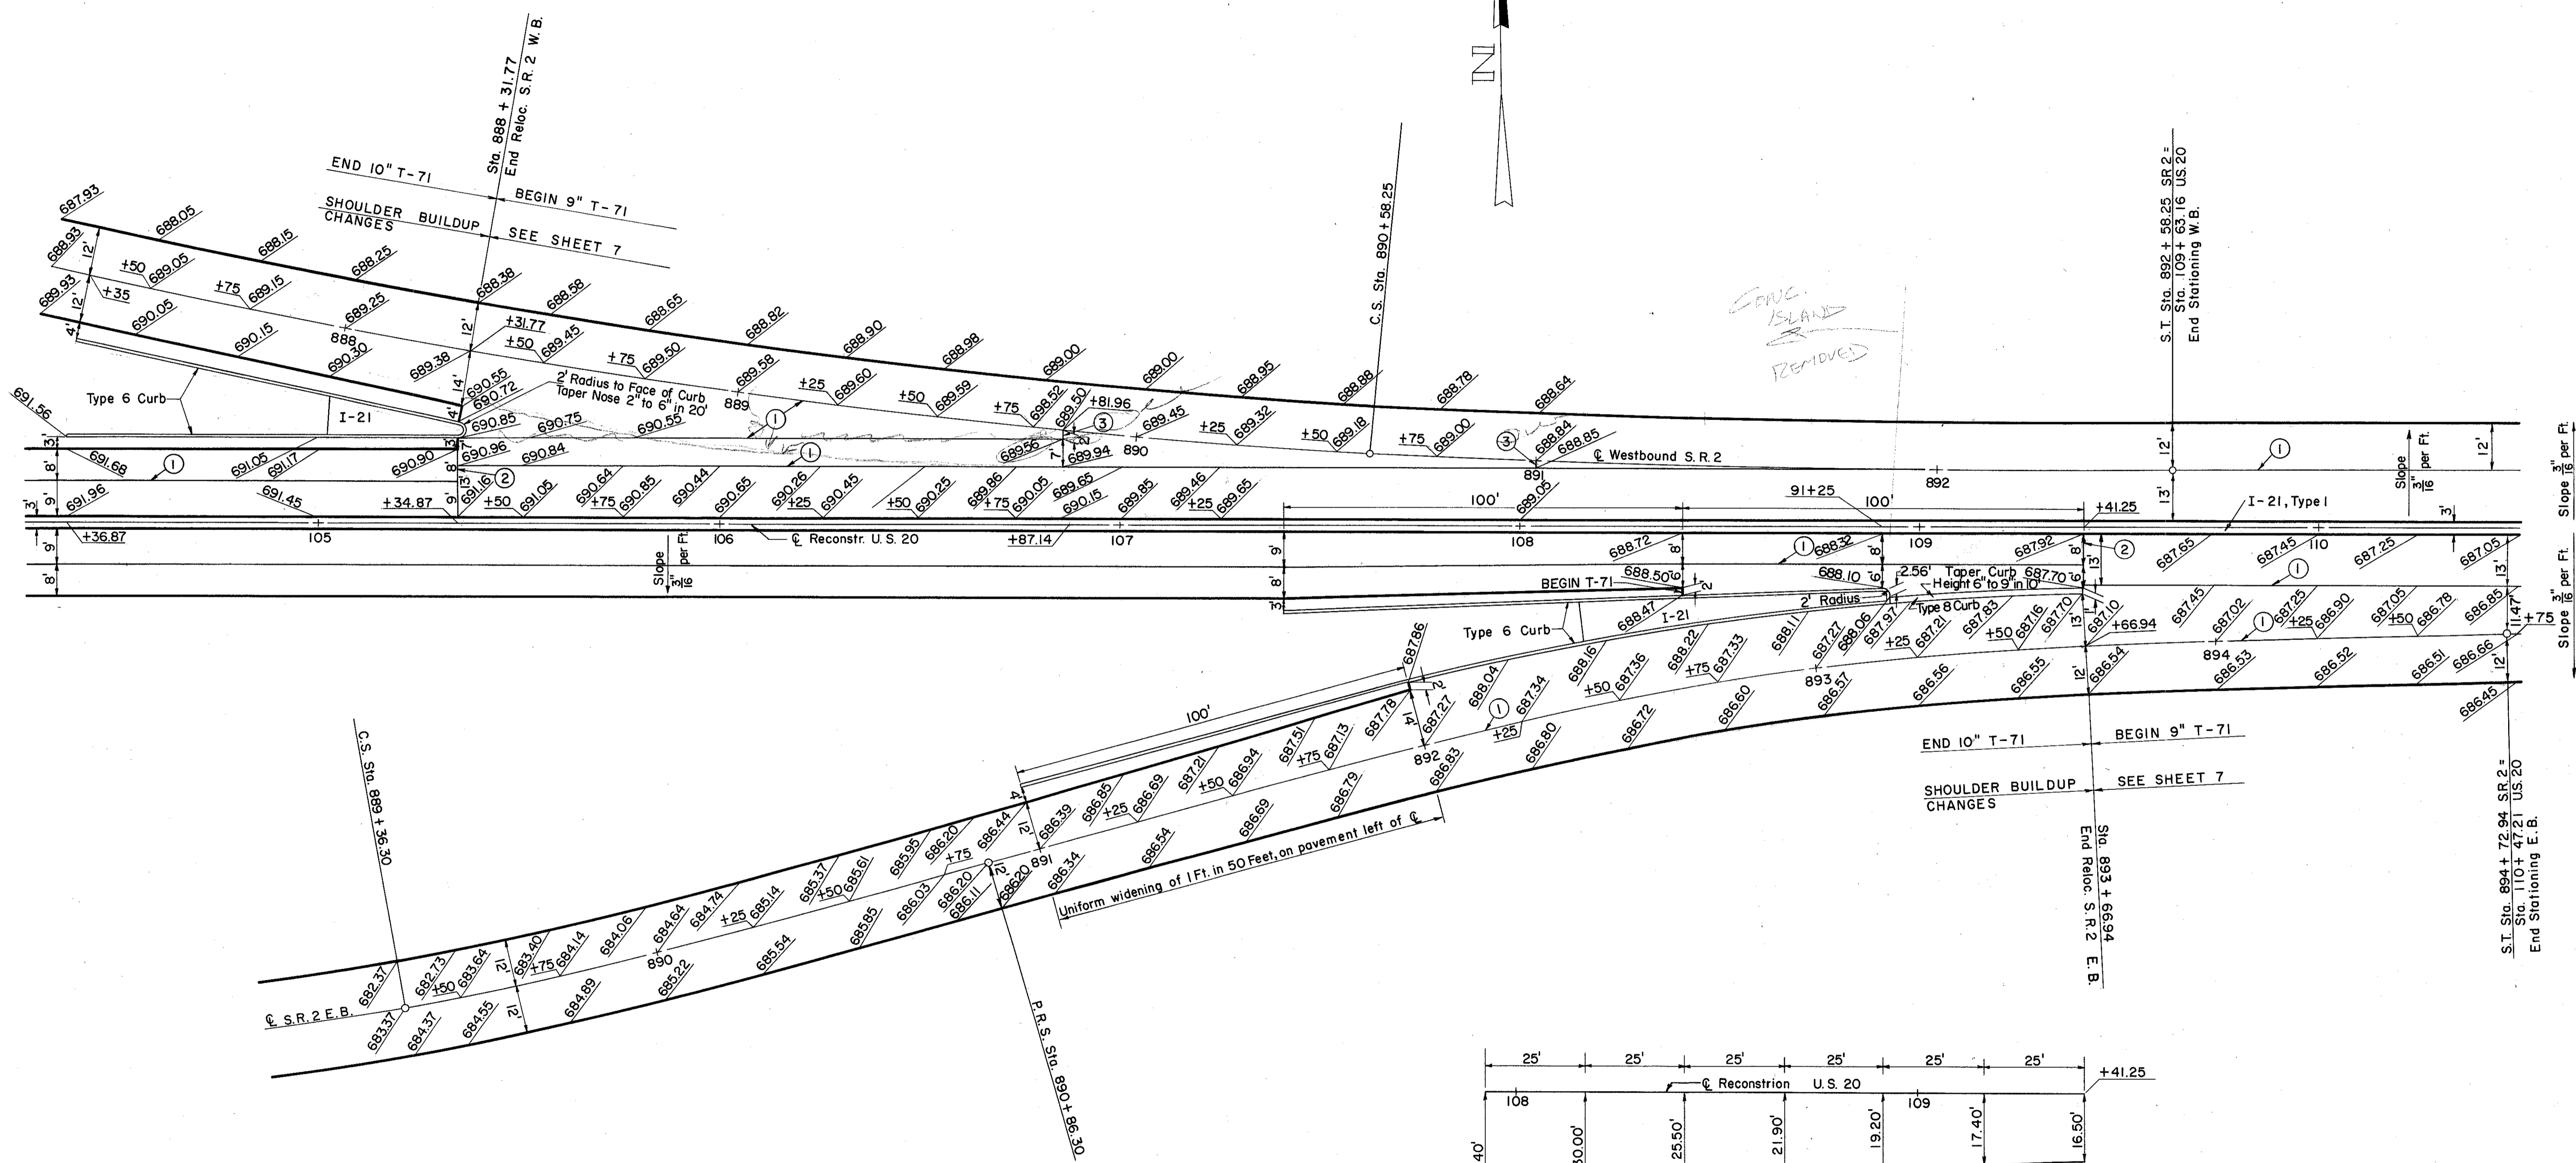


LAKE COUNTY
LAK -2-16.49

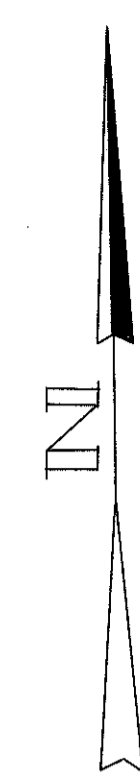

FOR OTHER DETAILS
SEE SHEET 36

- CONSTRUCTION JOINT LEGEND
- ① Standard Longitudinal Joint
 - ② Standard Expansion Joint
 - ③ Expansion Joint Without Dowels

RECONSTR. U.S. 20 & S.R. 2 INTERCHANGE
S. R. 2 WESTBOUND ENTRANCE TERMINAL
S. R. 2 EASTBOUND EXIT TERMINAL