


MICROFILMED
MAR 3 0 1964


FED. RD. DIVISION	STATE	PROJECT
2	OHIO	

242
313

LAKE COUNTY
LAK-2-16.49

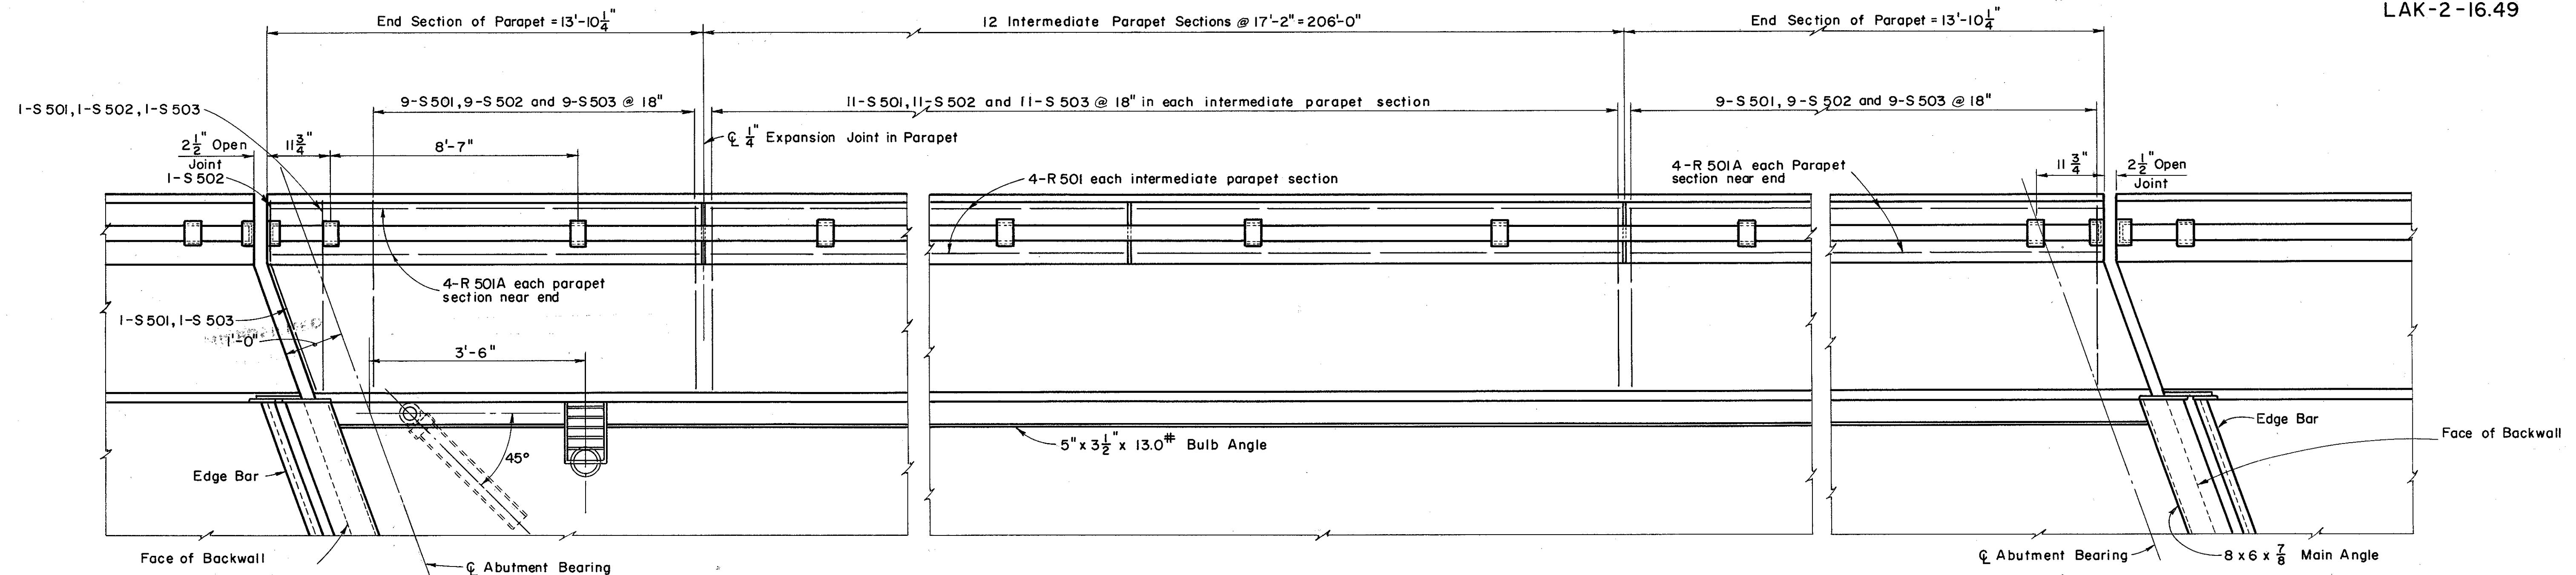

PARAPET REINFORCEMENT PLAN

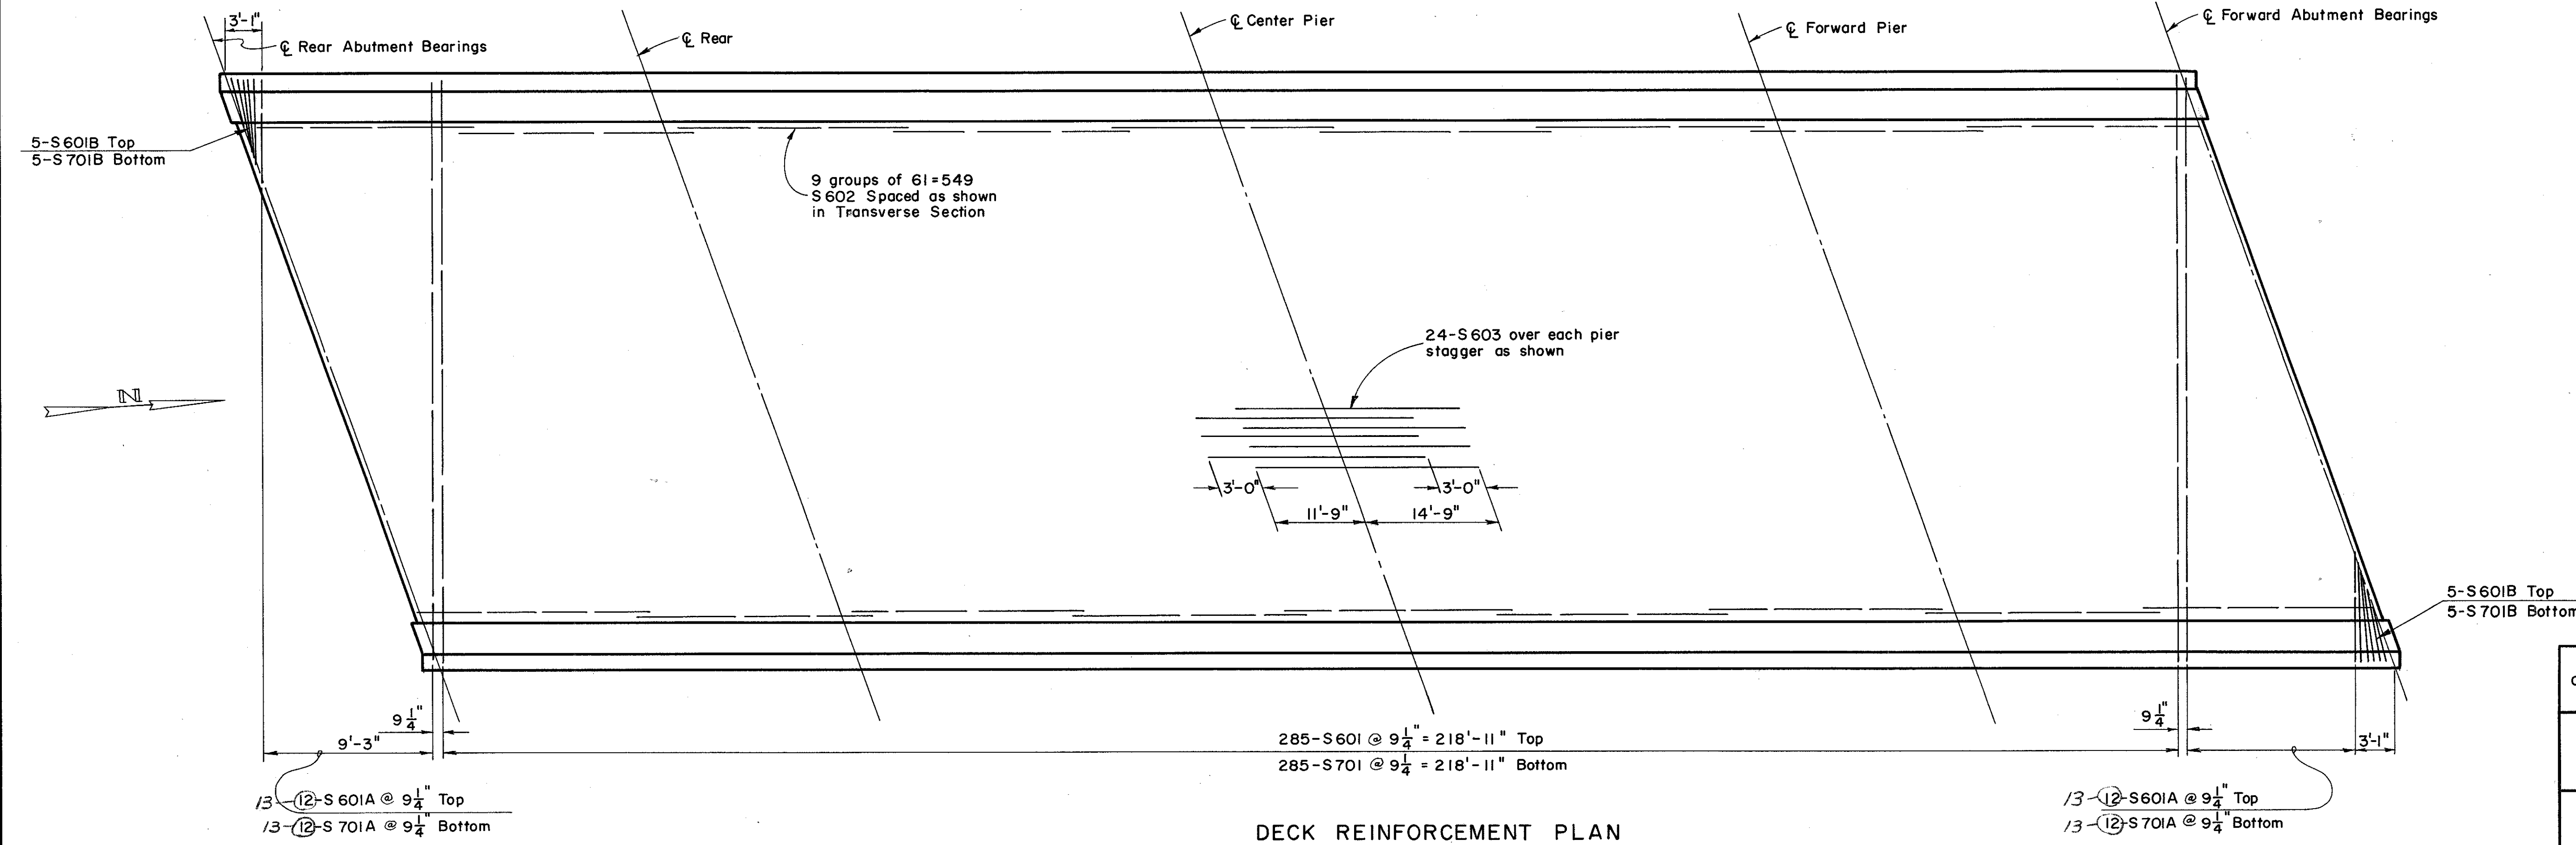

DECK REINFORCEMENT PLAN

PREPARED BY CAPITOL ENGINEERING ASSOCIATES, DILLSBURG, PA. FOR					
STATE OF OHIO DEPARTMENT OF HIGHWAYS DIVISION OF DESIGN AND CONSTRUCTION BUREAU OF BRIDGES					
DETAILS OF DECK & PARAPET BRIDGE NO. LAK-2-1673 RELOC. S.R. 2 UNDER RELOC. MANTLE ROAD LAKE COUNTY STA. 783 + 61.13					
DESIGNED M.J.F. L.L.D.	DRAWN M.J.F.	TRACED F.W.B.	CHECKED L.L.D. M.J.F.	REVIEWED DATE G.S.W. M.C.P.	REVISED 11-20-64