
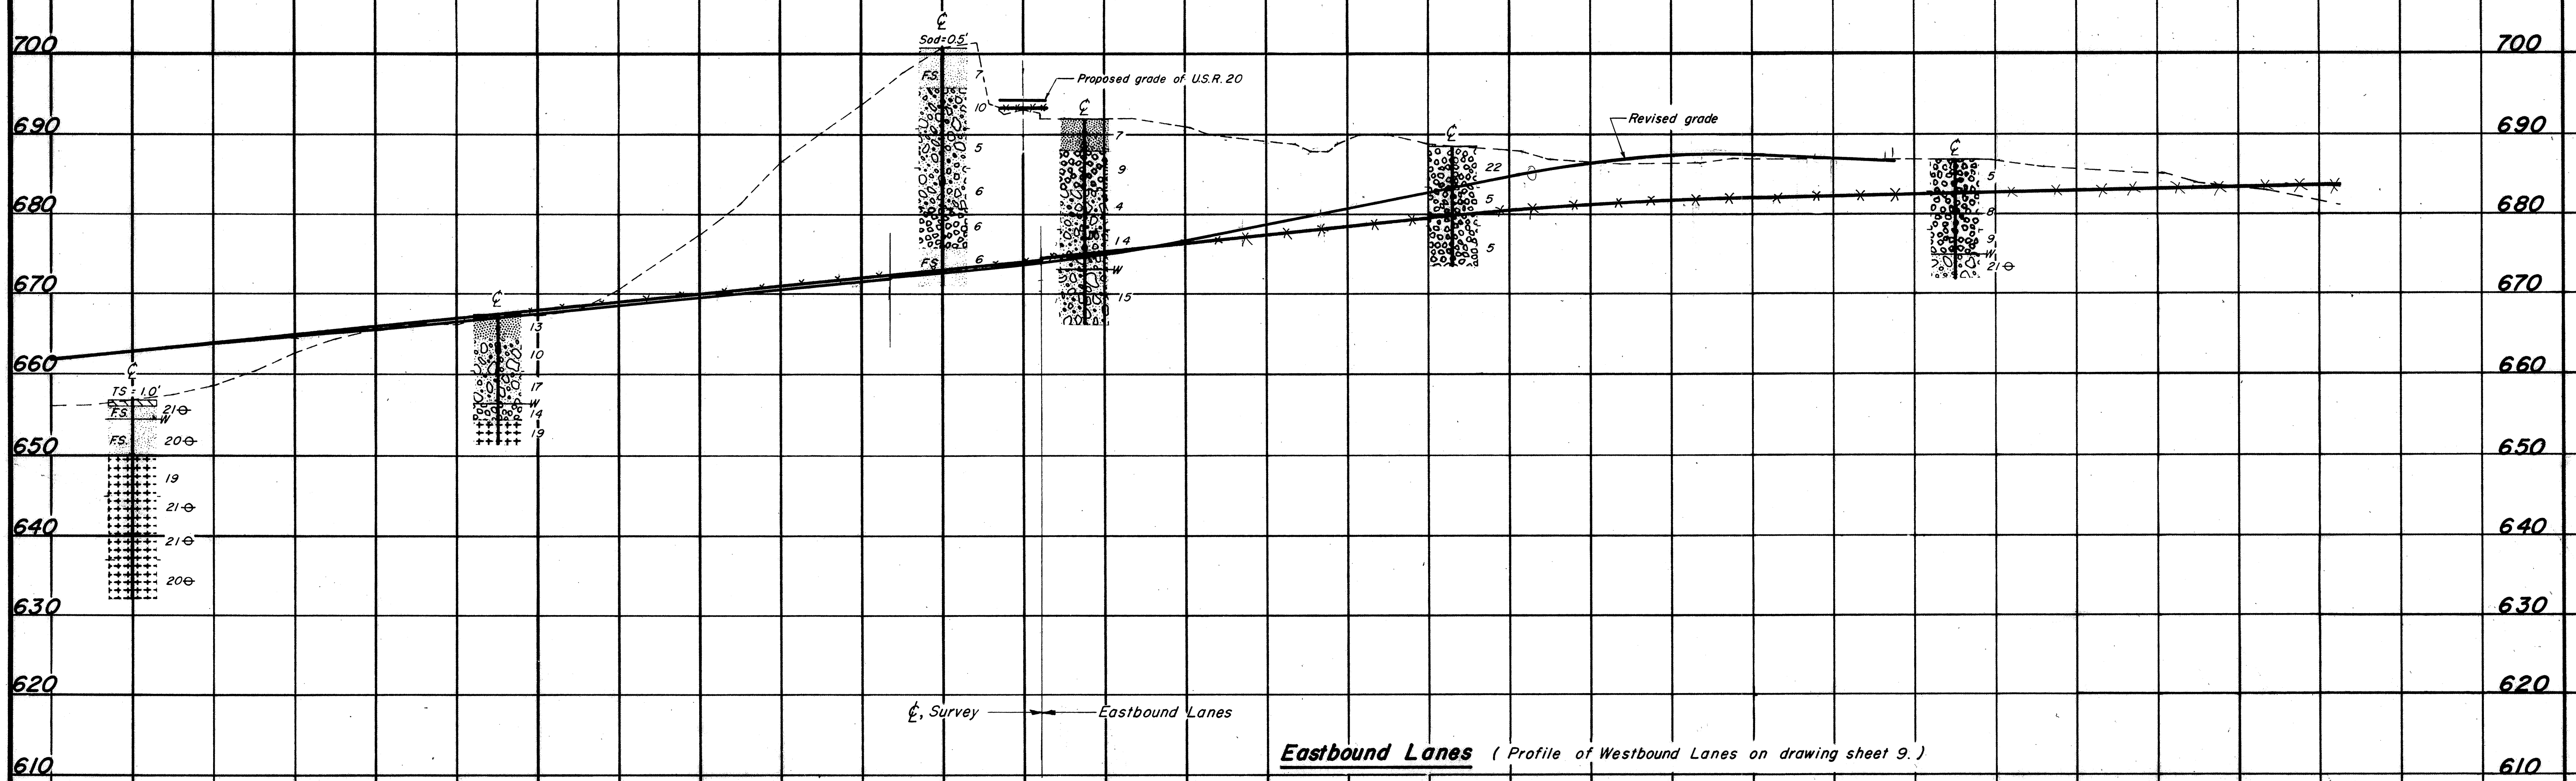


# S.R.2 & U.S.R.20 INTERCHANGE

SOIL PROFILE  
LAKE COUNTY  
LAK-2-16.49  
OHIO STATE HIGHWAY  
TESTING LABORATORY  
COLUMBUS, OHIO

Revised  
4-5-63

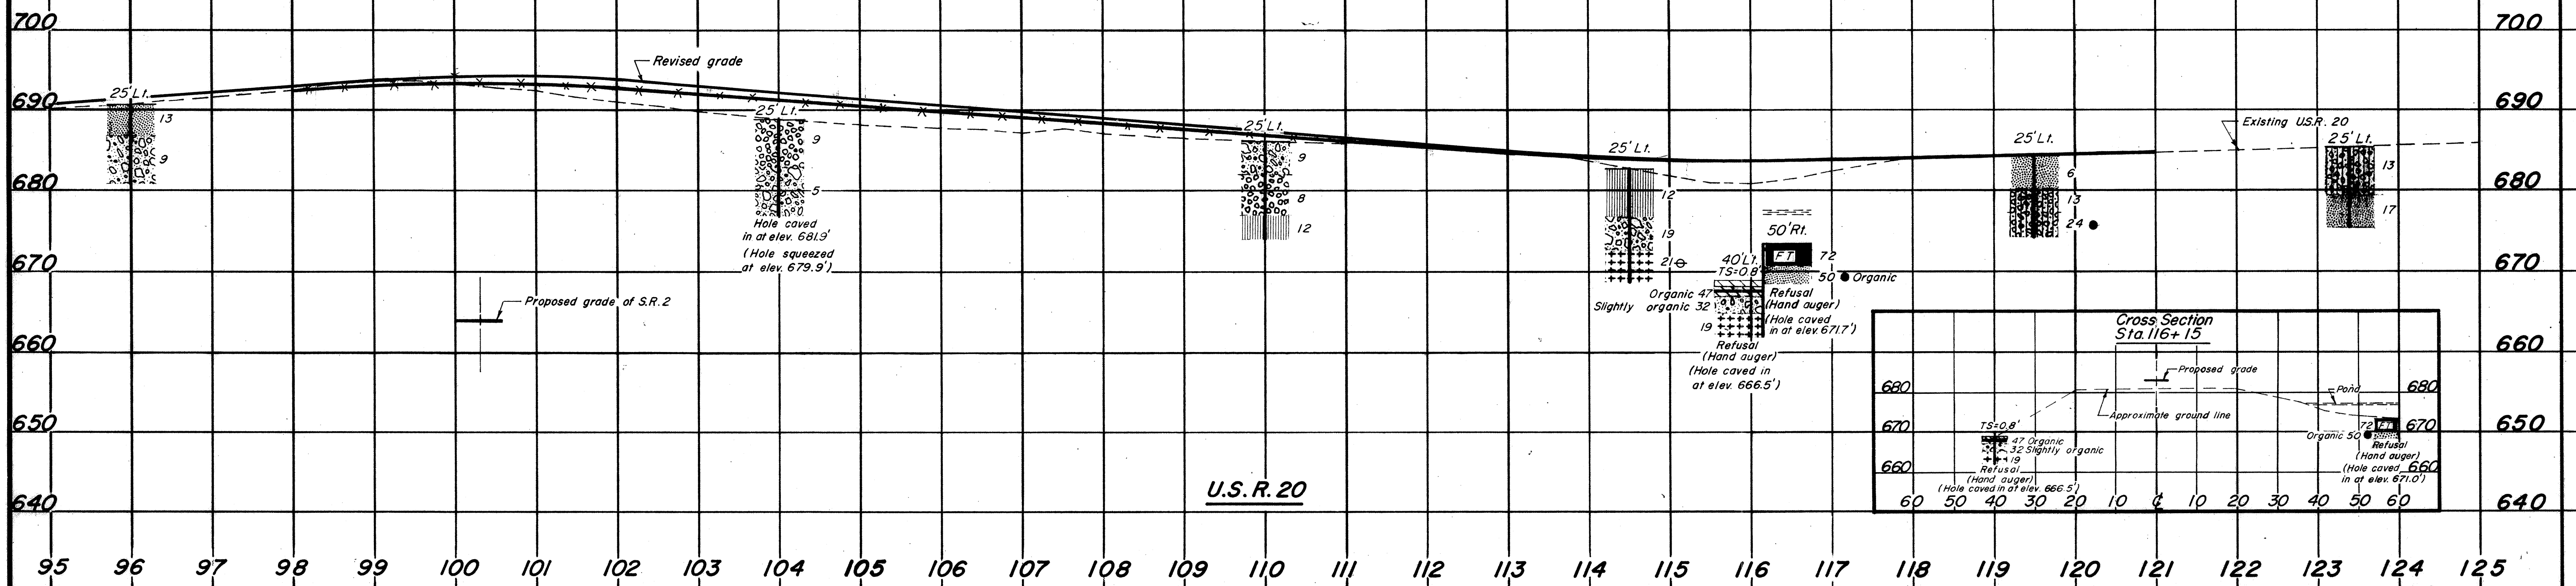

872 873 874 