


2 REVISION 04/07/10:
PAVEMENT MARKING CHANGES
DUE TO MOVED CURB LINE 2.5' OFF C
AND DELETED REMOVAL OF MEDIAN
OVER SR 2
REVISED RAMP A PAVEMENT MARKINGS
NEAR STOP LINE

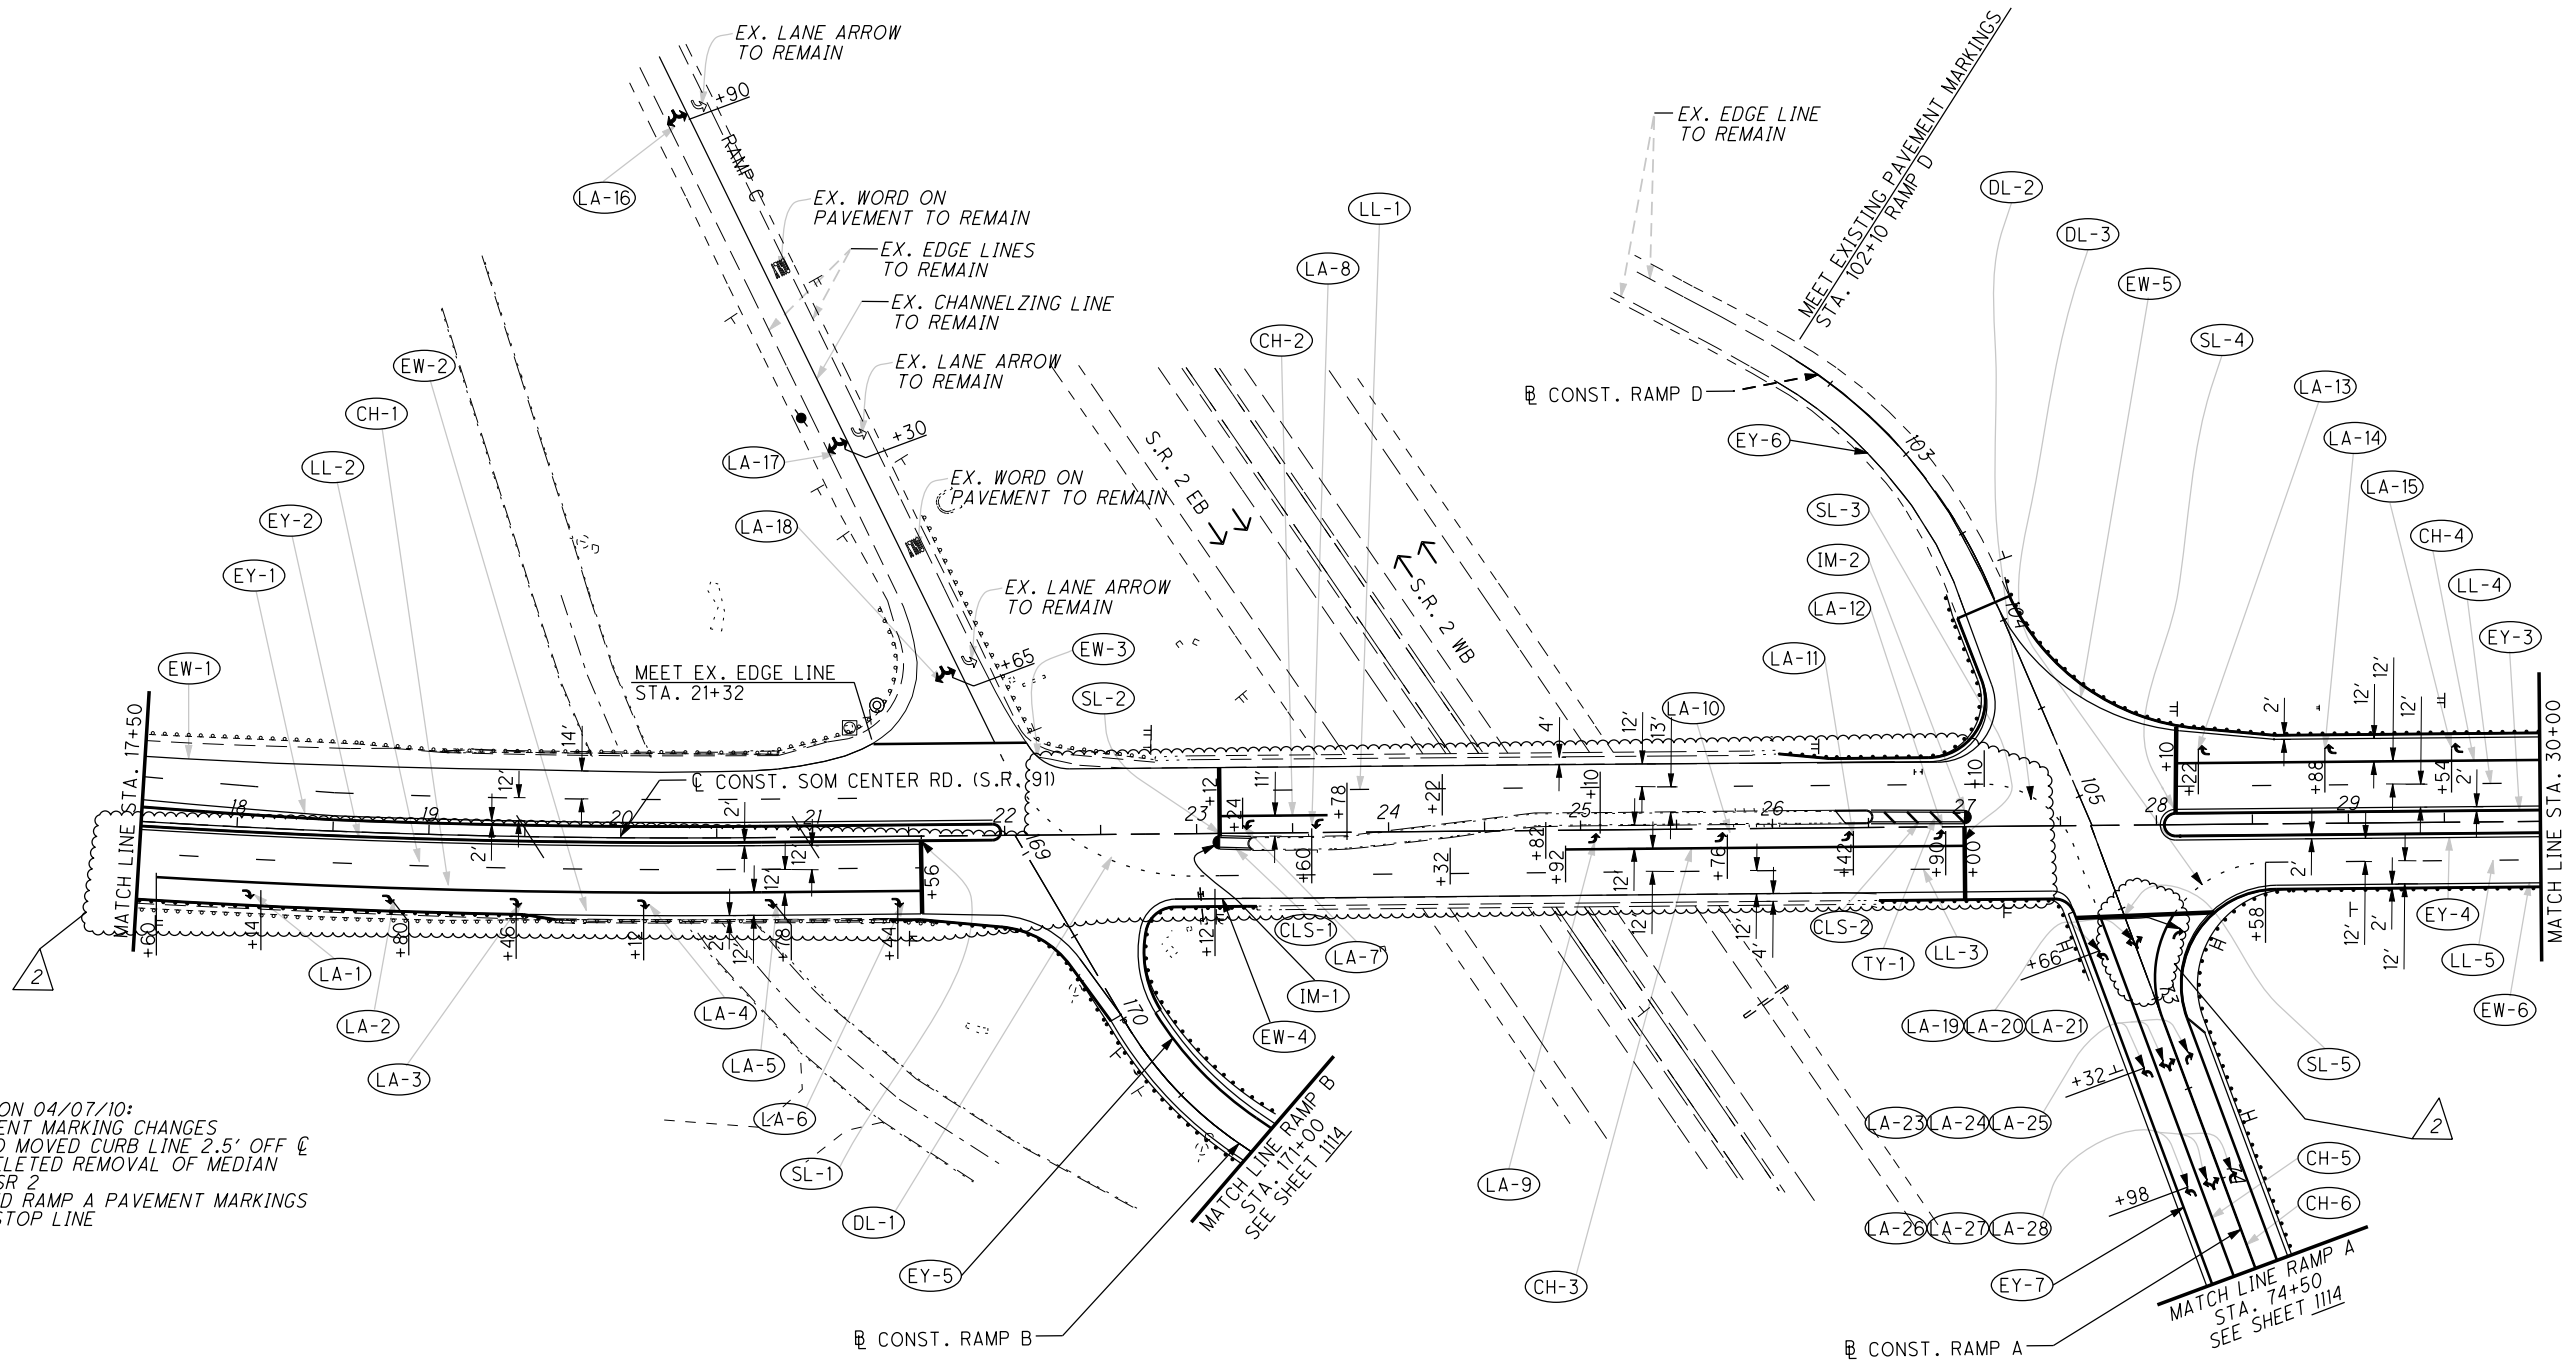

CALCULATED
TJR
CHECKED
MAH

0 50 100
25
HORIZONTAL
SCALE IN FEET

PAVEMENT MARKING PLAN
SOM CENTER RD. (S.R. 91) - STA. 17+50 TO STA. 30+00

LAK-2-3.32