


c:\Project\lak\13486\traffic\sheets\13486\PSOM08.dgn 4/7/2010 12:00:20 PM djzjzty

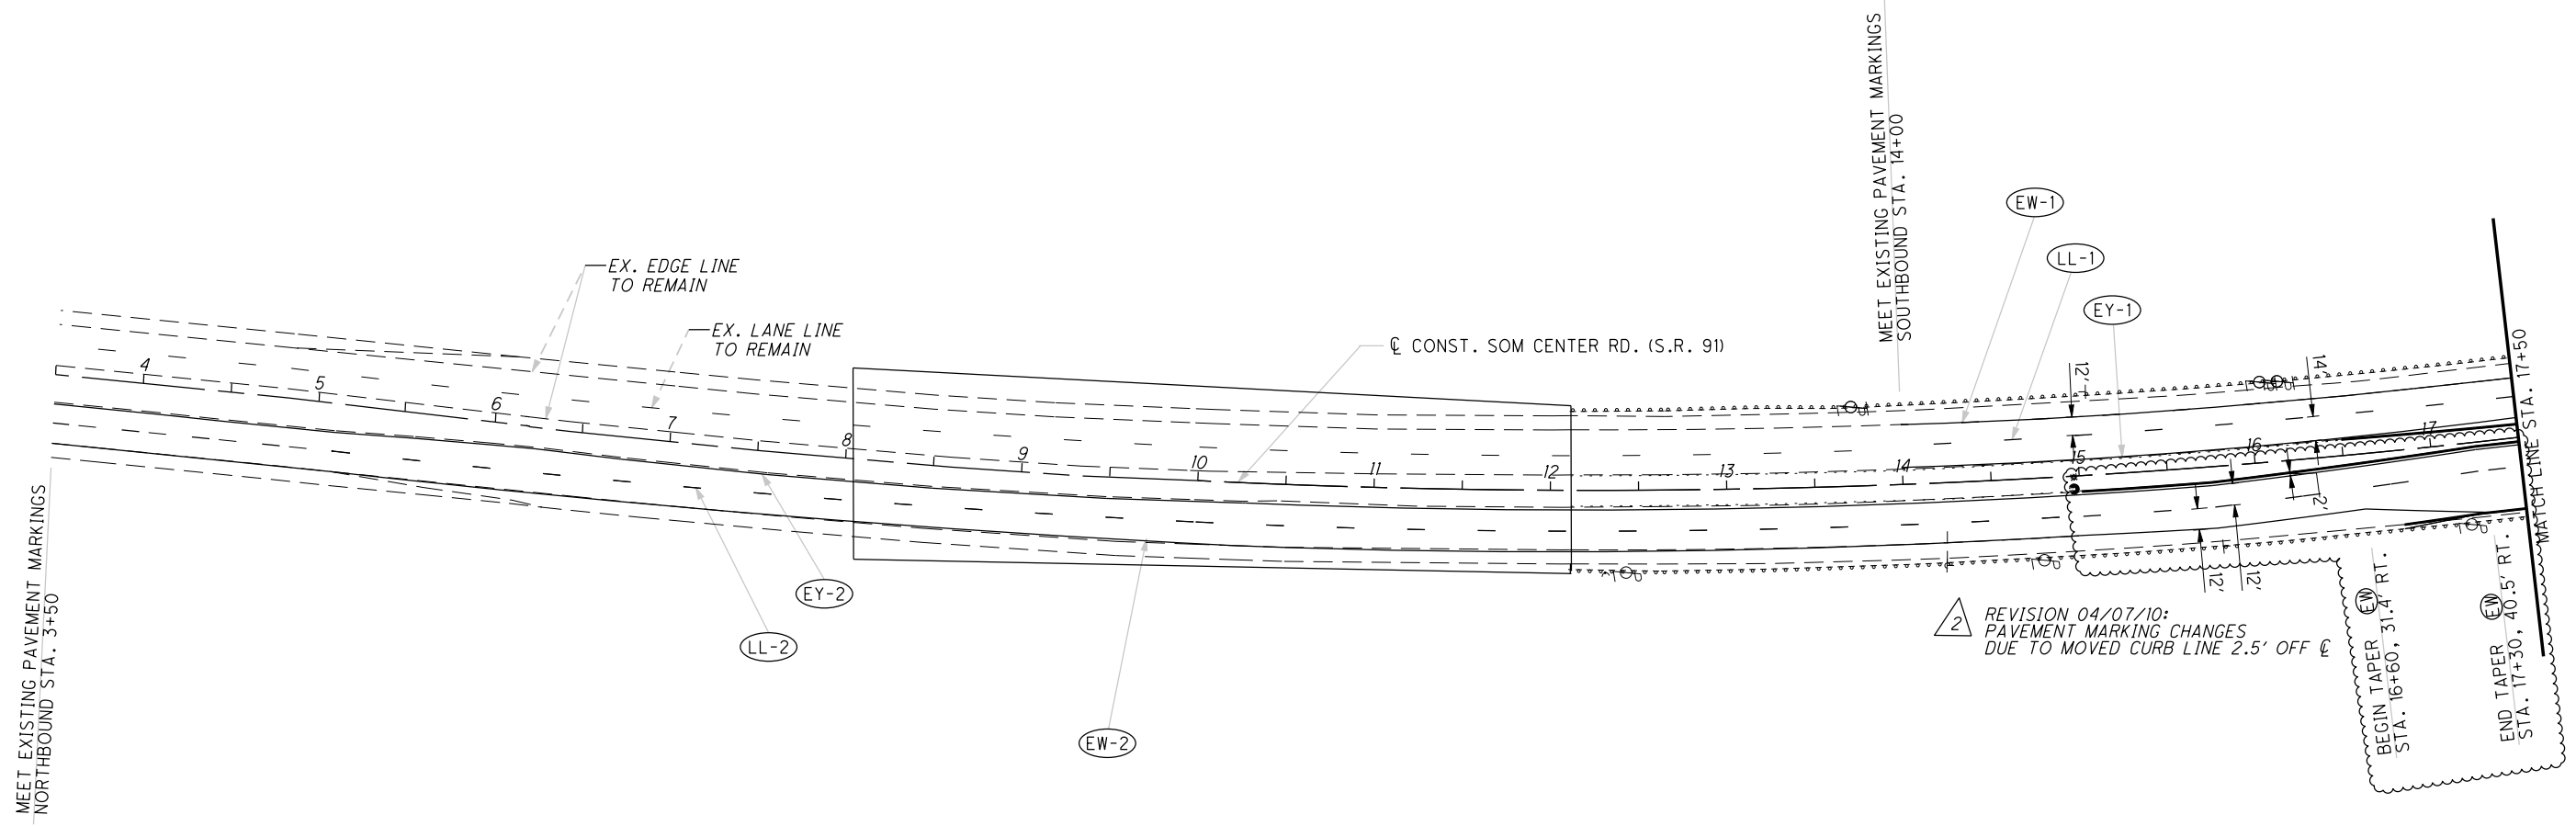

CALCULATED  
TRR  
CHECKED  
MAH

0 50 100  
25  
HORIZONTAL  
SCALE IN FEET

**PAVEMENT MARKING PLAN**  
**SOM CENTER RD. (S.R. 91) - BEGIN TO STA. 17+50**

**LAK-2-3.32**

1123  
1679

FOR PAVEMENT MARKING AND SIGNING LEGEND, SEE SHEET 1094.